


UNITED STATES
DEPARTMENT OF THE INTERIOR
BUREAU OF LAND MANAGEMENT

SECTION

Oregon State Water Filings

TOWNSHIP 29S, RANGE 16E, W. M.

North WEAVER WATER HOLE

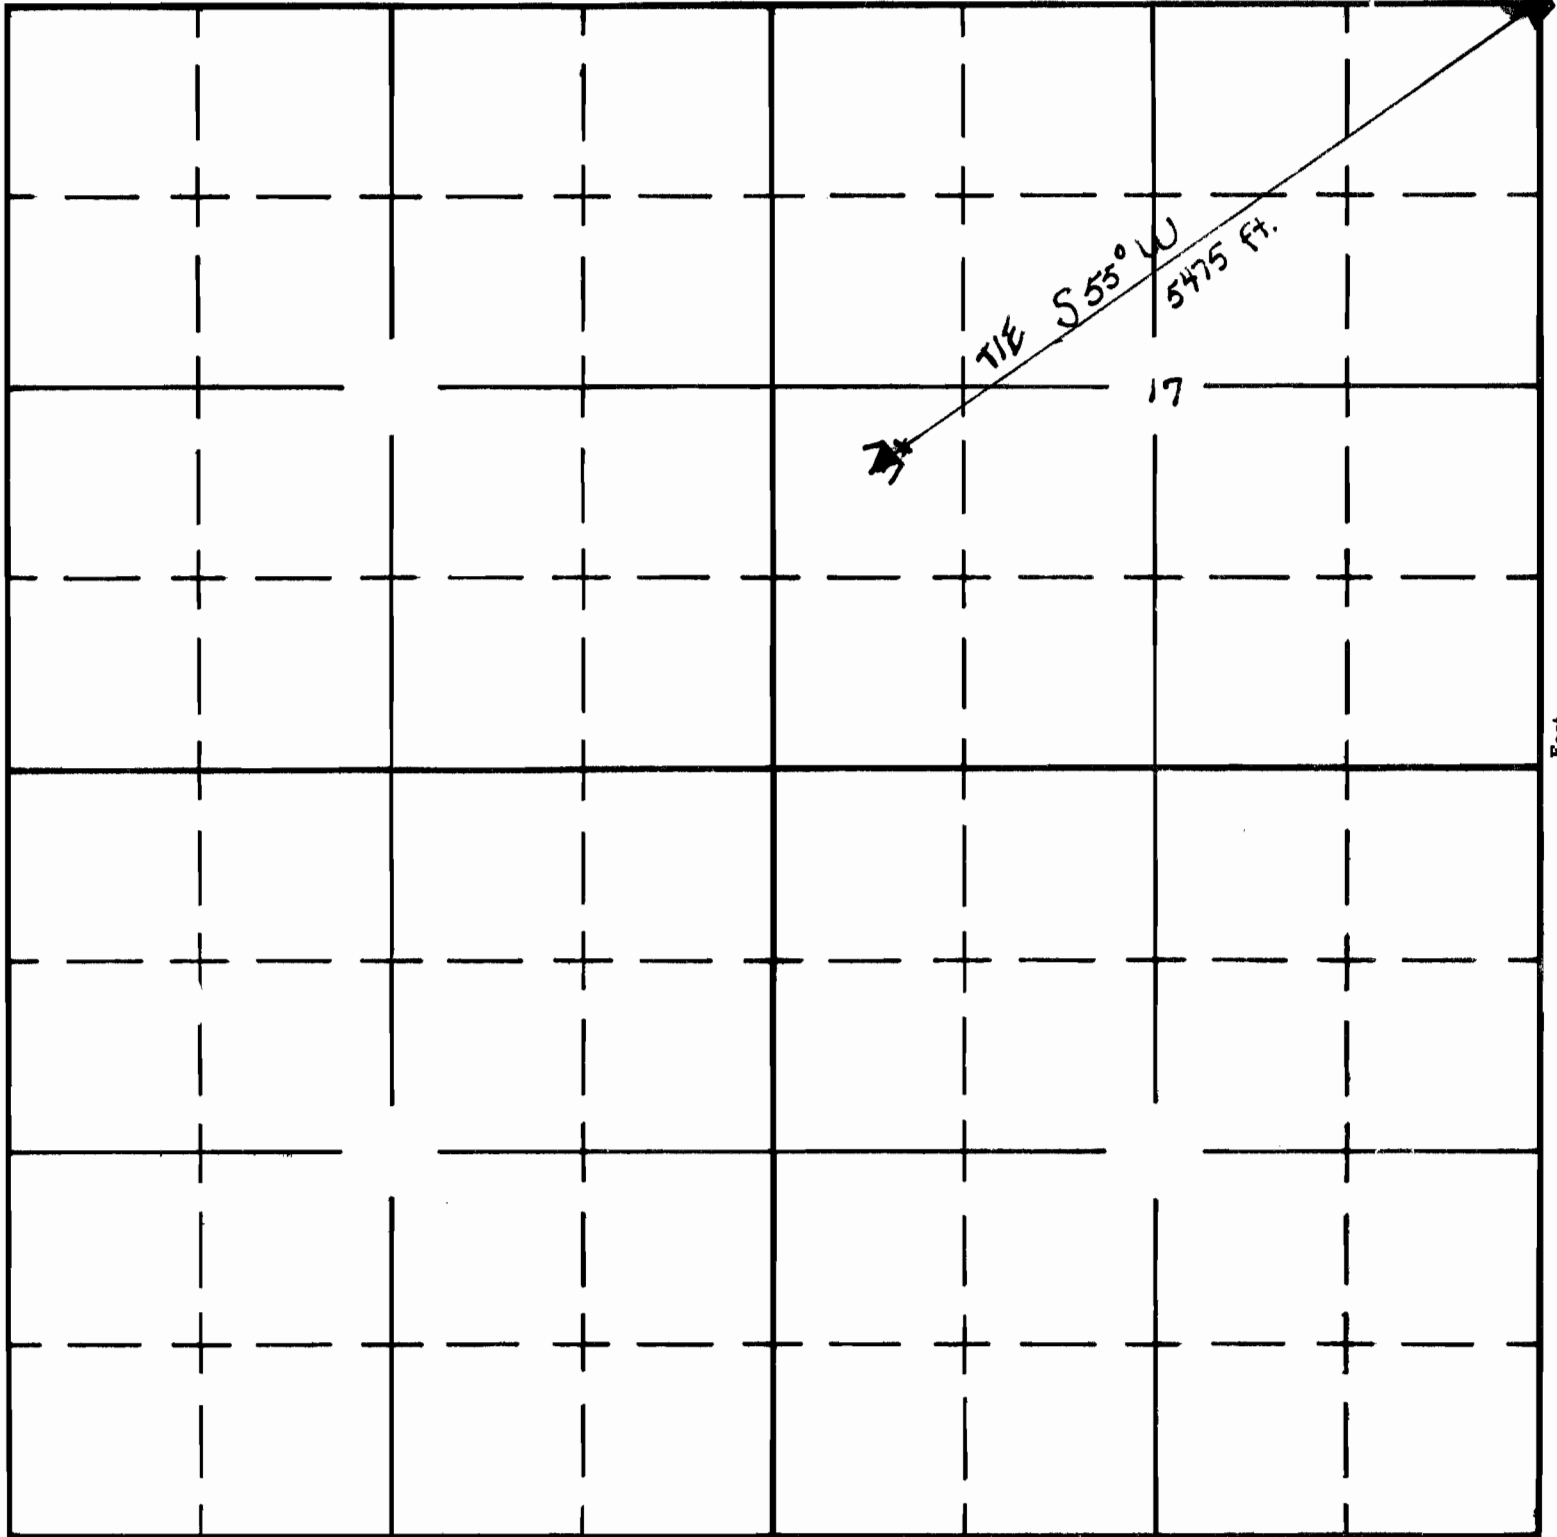

◆ FOUND SURVEY CORNER

South

W PROJECT

APPLICATION No. R-34373
PERMIT No. R-2546