


UNITED STATES
DEPARTMENT OF THE INTERIOR
BUREAU OF LAND MANAGEMENT

SECTION

Oregon State Water Filings

TOWNSHIP 29S, RANGE 16E, W. M.

North UNKNOWN SEEP RESERVOIR

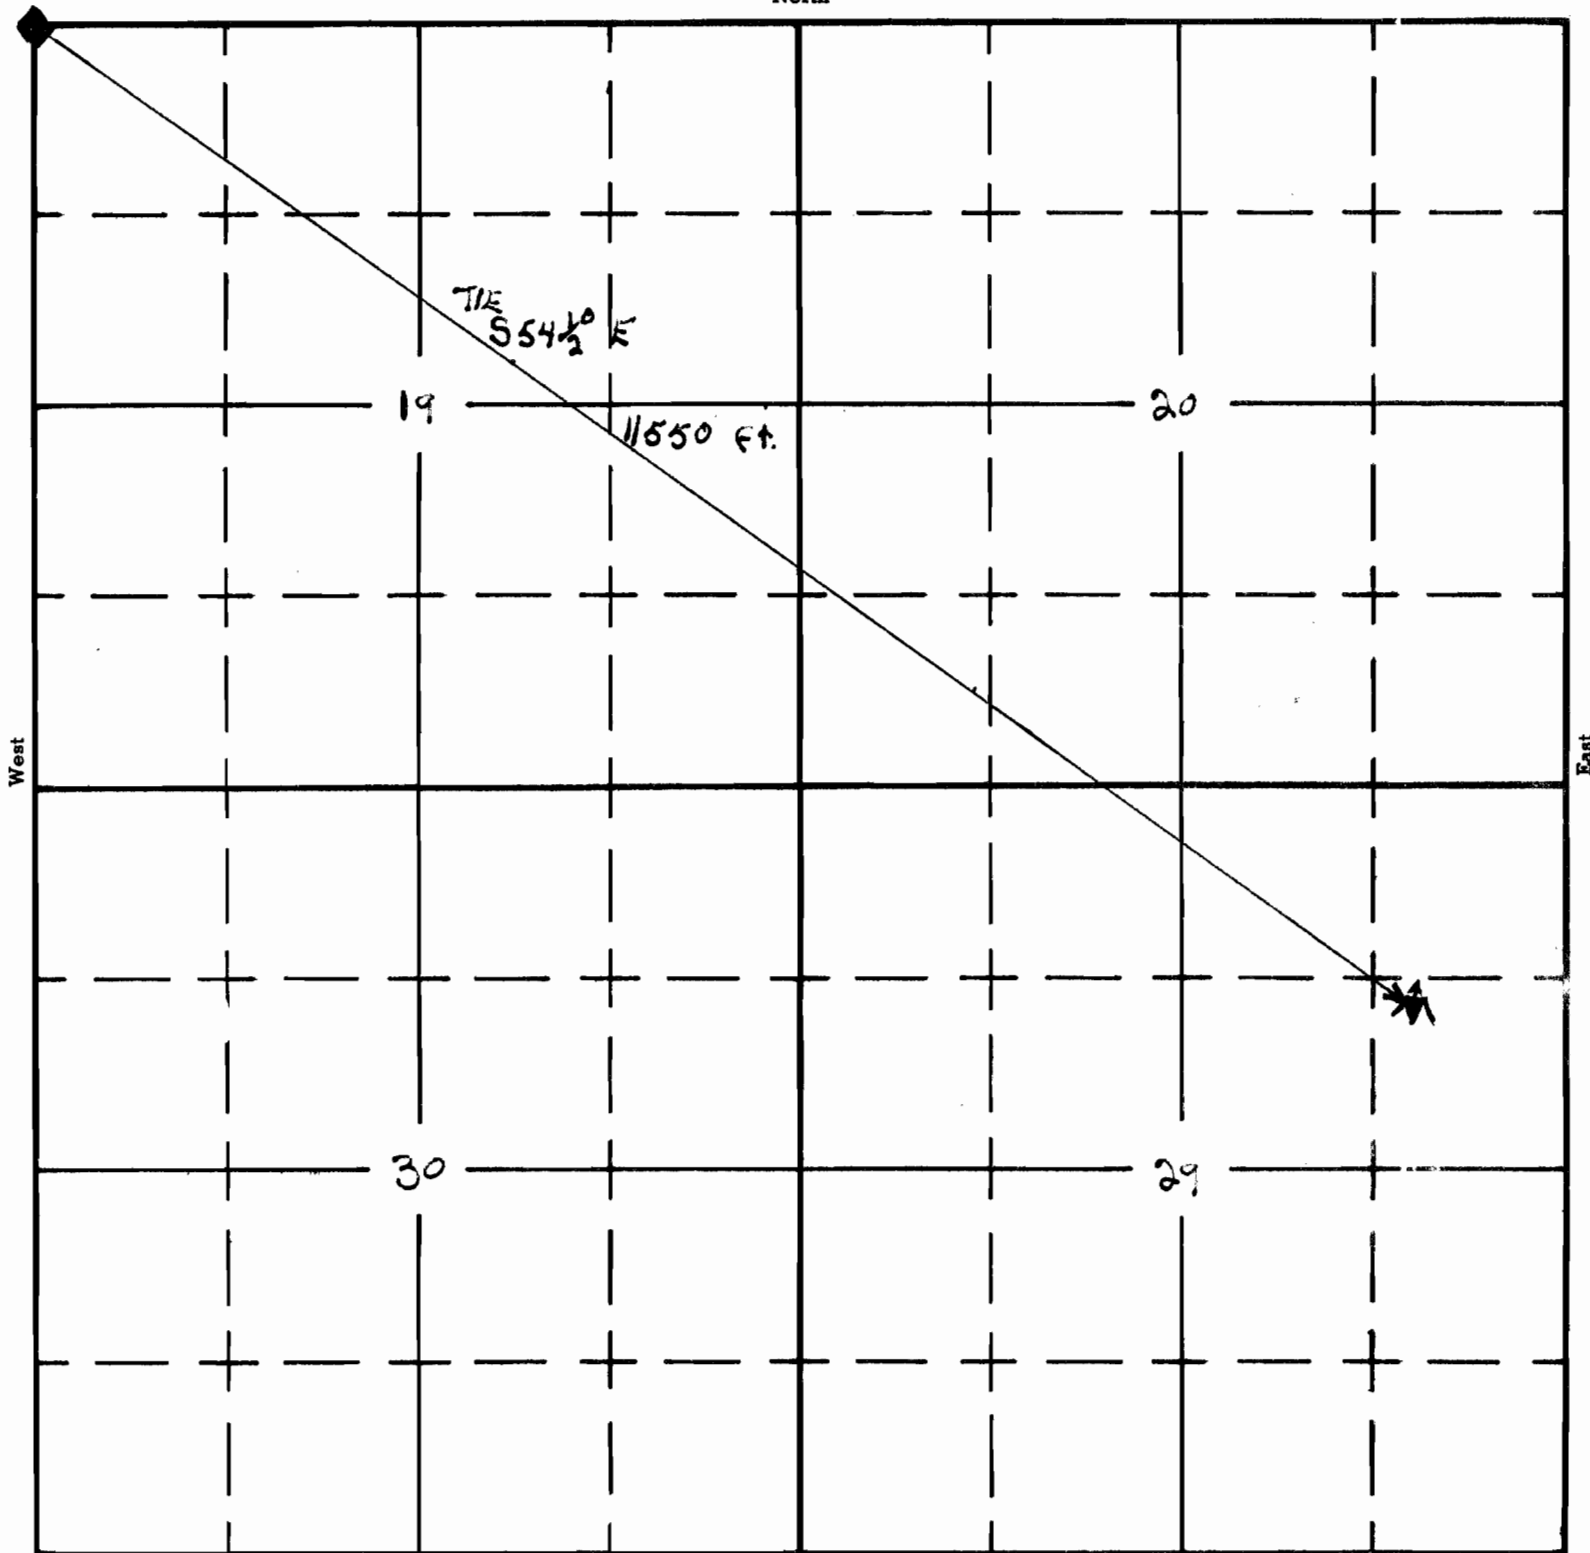

◆ FOUND SURVEY CORNER

South

★ PROJECT

APPLICATION No. R-34374
PERMIT No. R-2547