

AL-187  
1961

UNITED STATES  
DEPARTMENT OF THE INTERIOR  
BUREAU OF LAND MANAGEMENT


SECTION

//

Oregon State Water Filings

TOWNSHIP 28-S, RANGE 13-E, W. M.

North

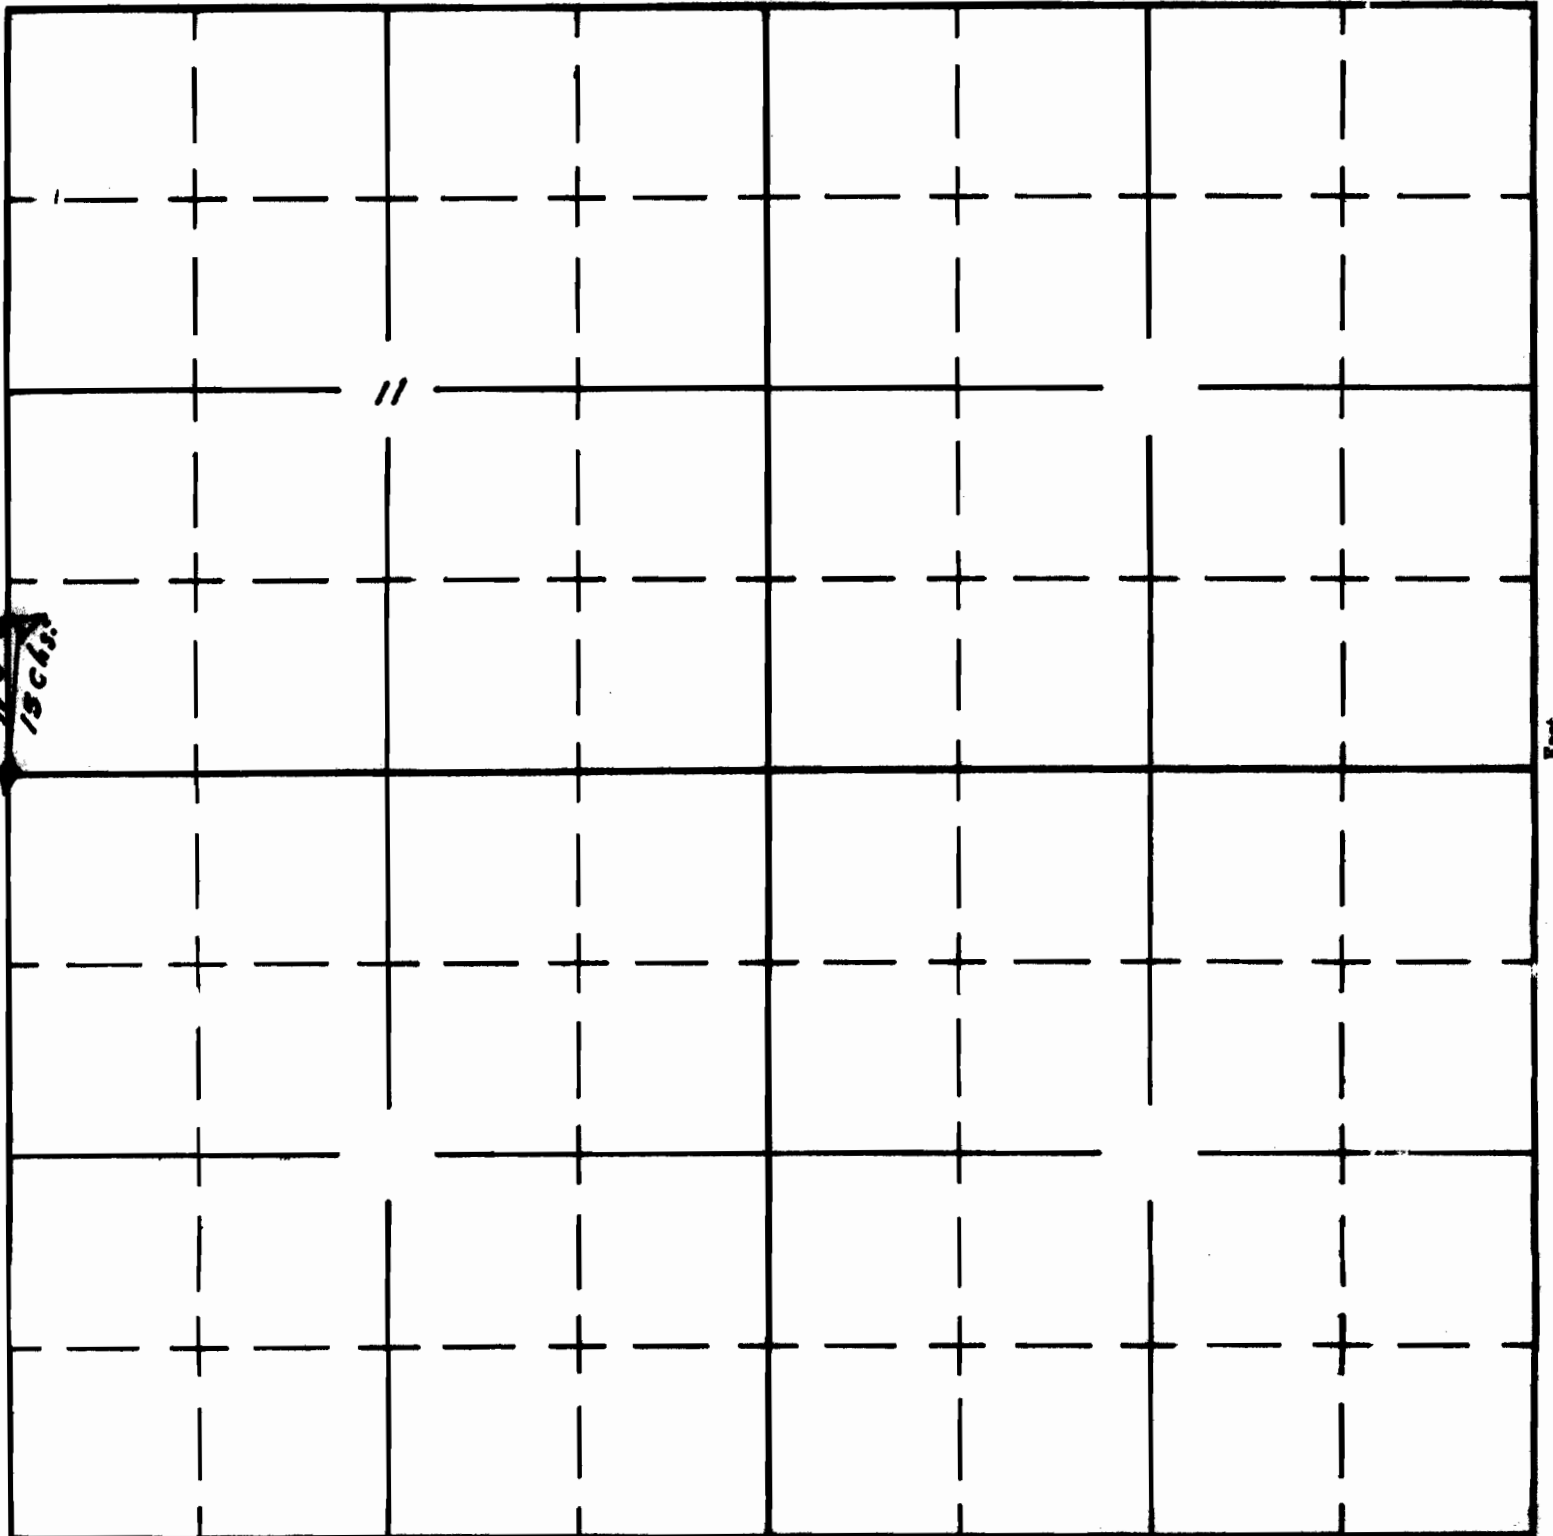

South

APPLICATION No. R-34813  
PERMIT No. R-2623