

Form AI-187
March 1961

UNITED STATES
DEPARTMENT OF THE INTERIOR
BUREAU OF LAND MANAGEMENT

SECTION


NE¹NW¹ Sec 2

Oregon State Water Filings

TOWNSHIP 38S, RANGE 29E, W. M.

North

No Corner Found.
Tied in with aerial photos and Q&ND Quad maps

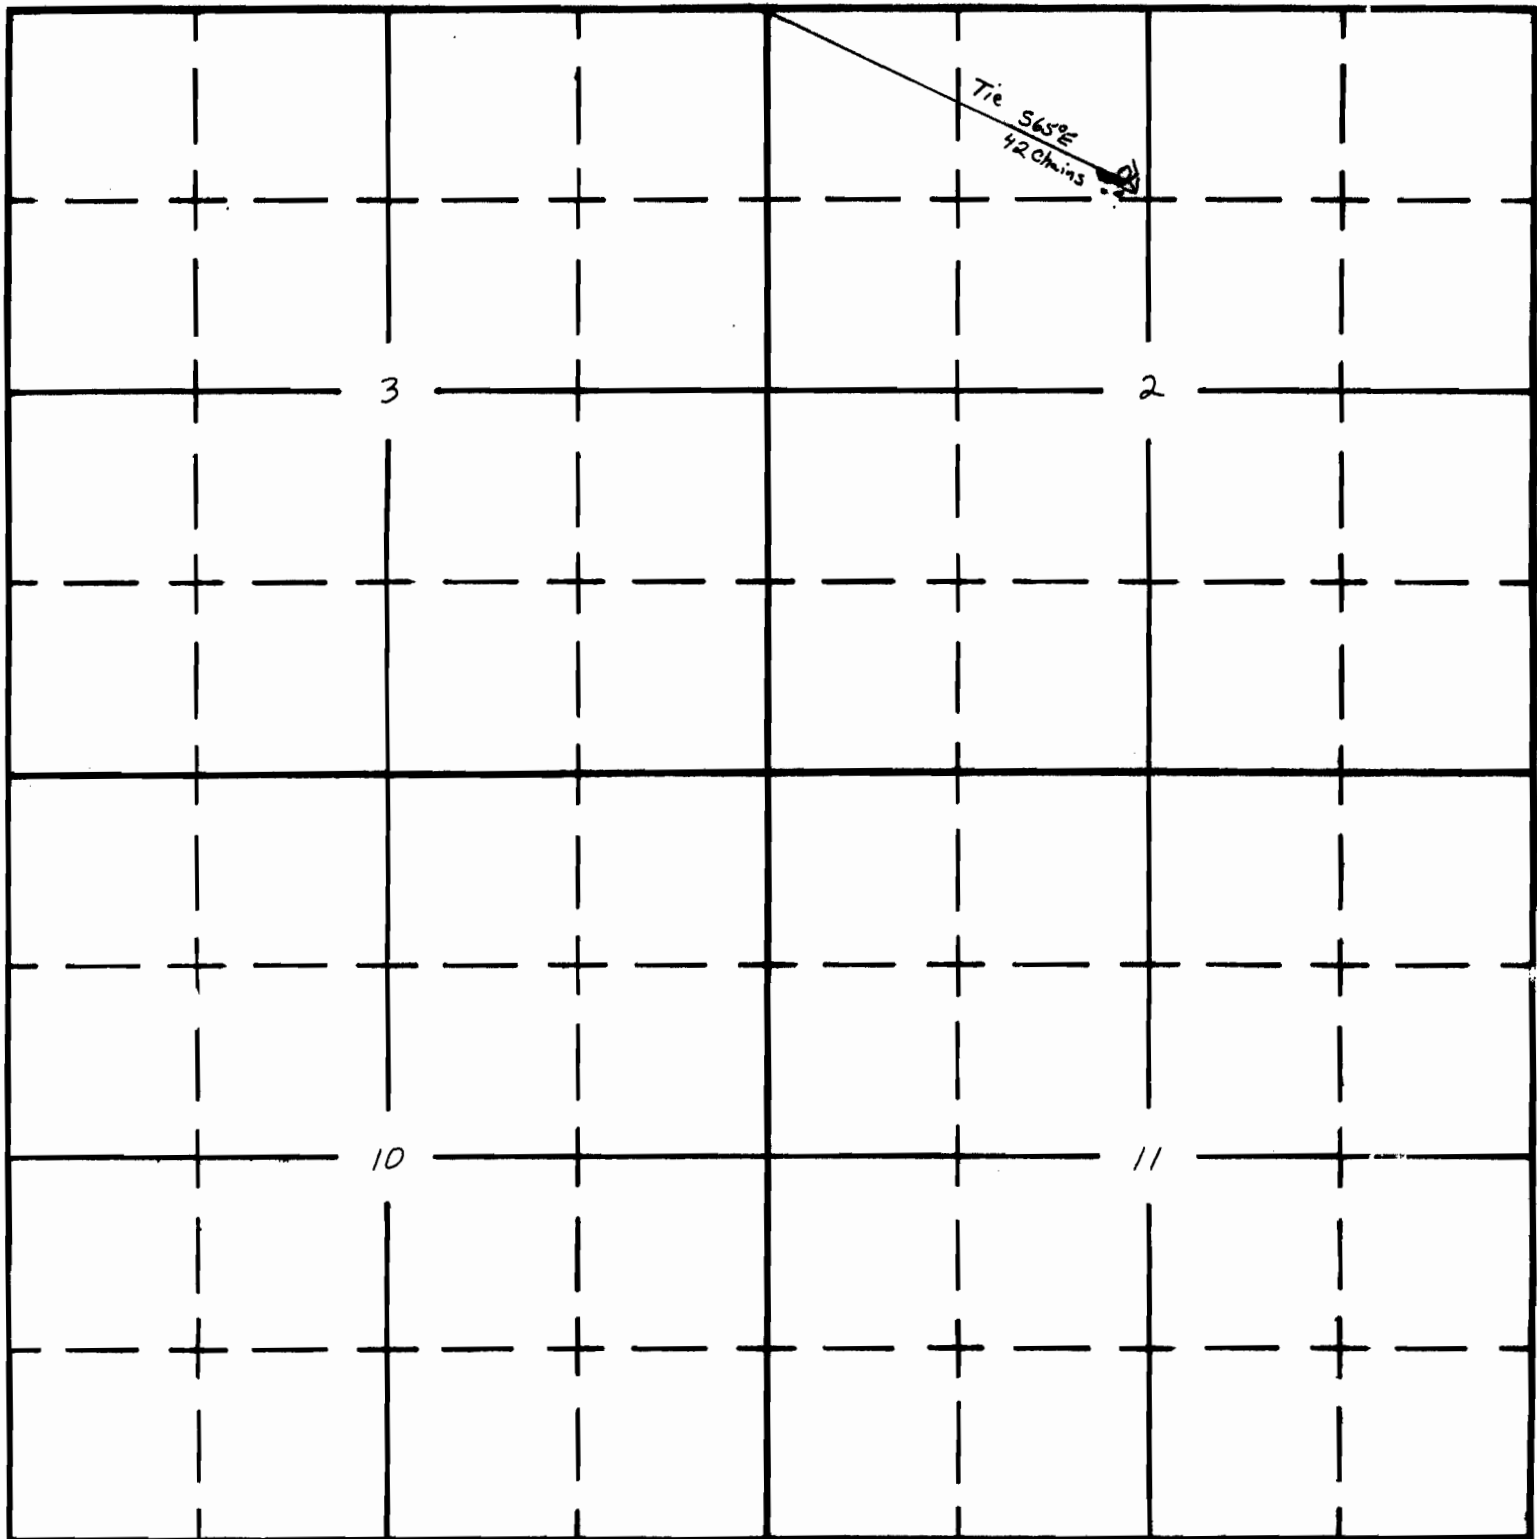

South

APPLICATION No. R-34819
PERMIT No. R-2628