

Form A1-187
March 1961

UNITED STATES
DEPARTMENT OF THE INTERIOR
BUREAU OF LAND MANAGEMENT

SECTION

NE¹NW⁴ Sec 2


Oregon State Water Filings

TOWNSHIP 38S, RANGE 29E, W. M.

North

No corner Found

Tied in with aerial photos and Q&ND. Quad maps

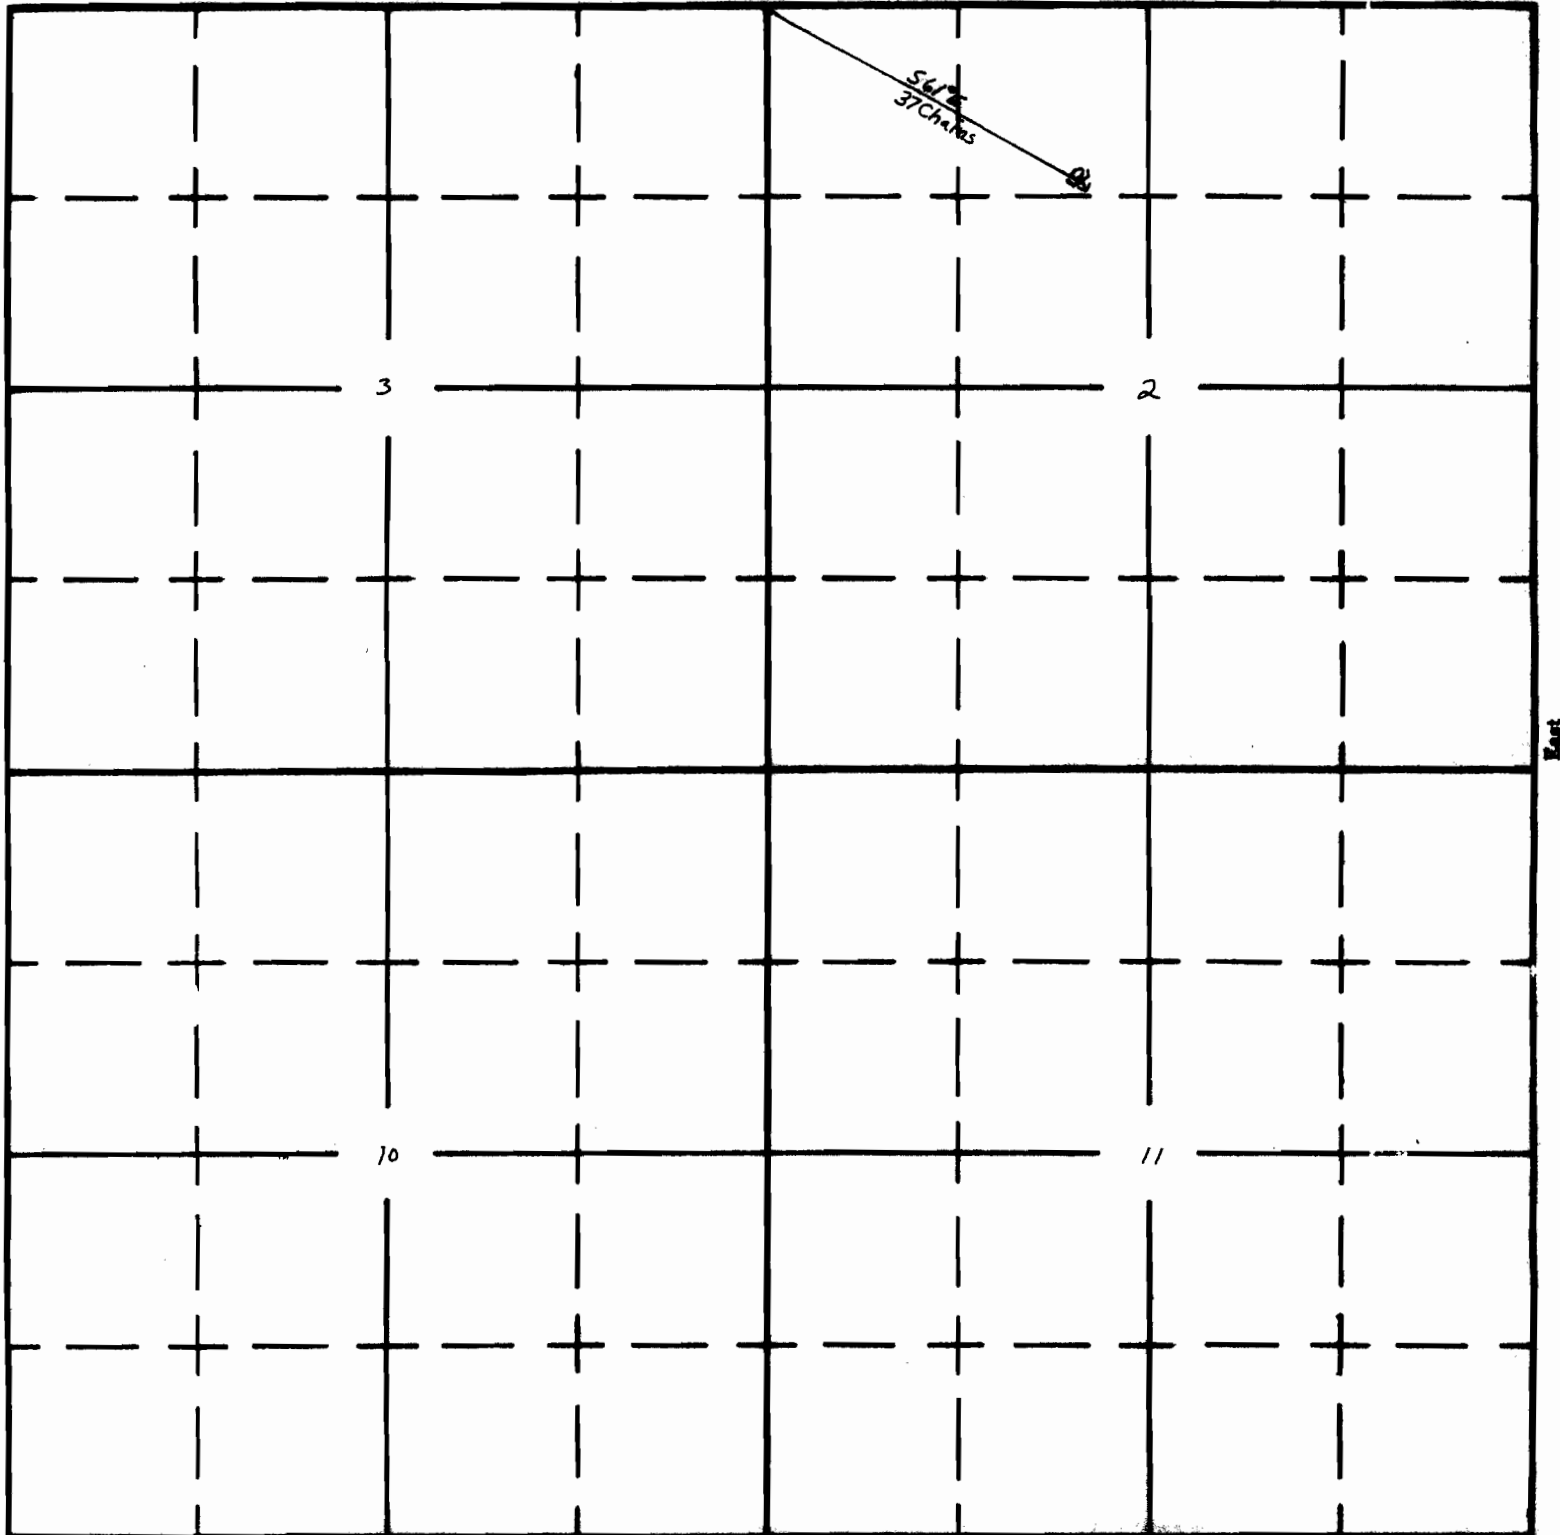

South

APPLICATION No. R-34820

PERMIT No. R-9629