

UNITED STATES
DEPARTMENT OF THE INTERIOR
BUREAU OF LAND MANAGEMENT

R2748
77642
79527


RECEIVED
JUN 25 1960
STATE ENGINEER
BUREAU OF LAND MANAGEMENT

SECTION

Oregon State Water Filings

TOWNSHIP 29S, RANGE 15E, W. M.

North TWO SHEEP WATER HOLE

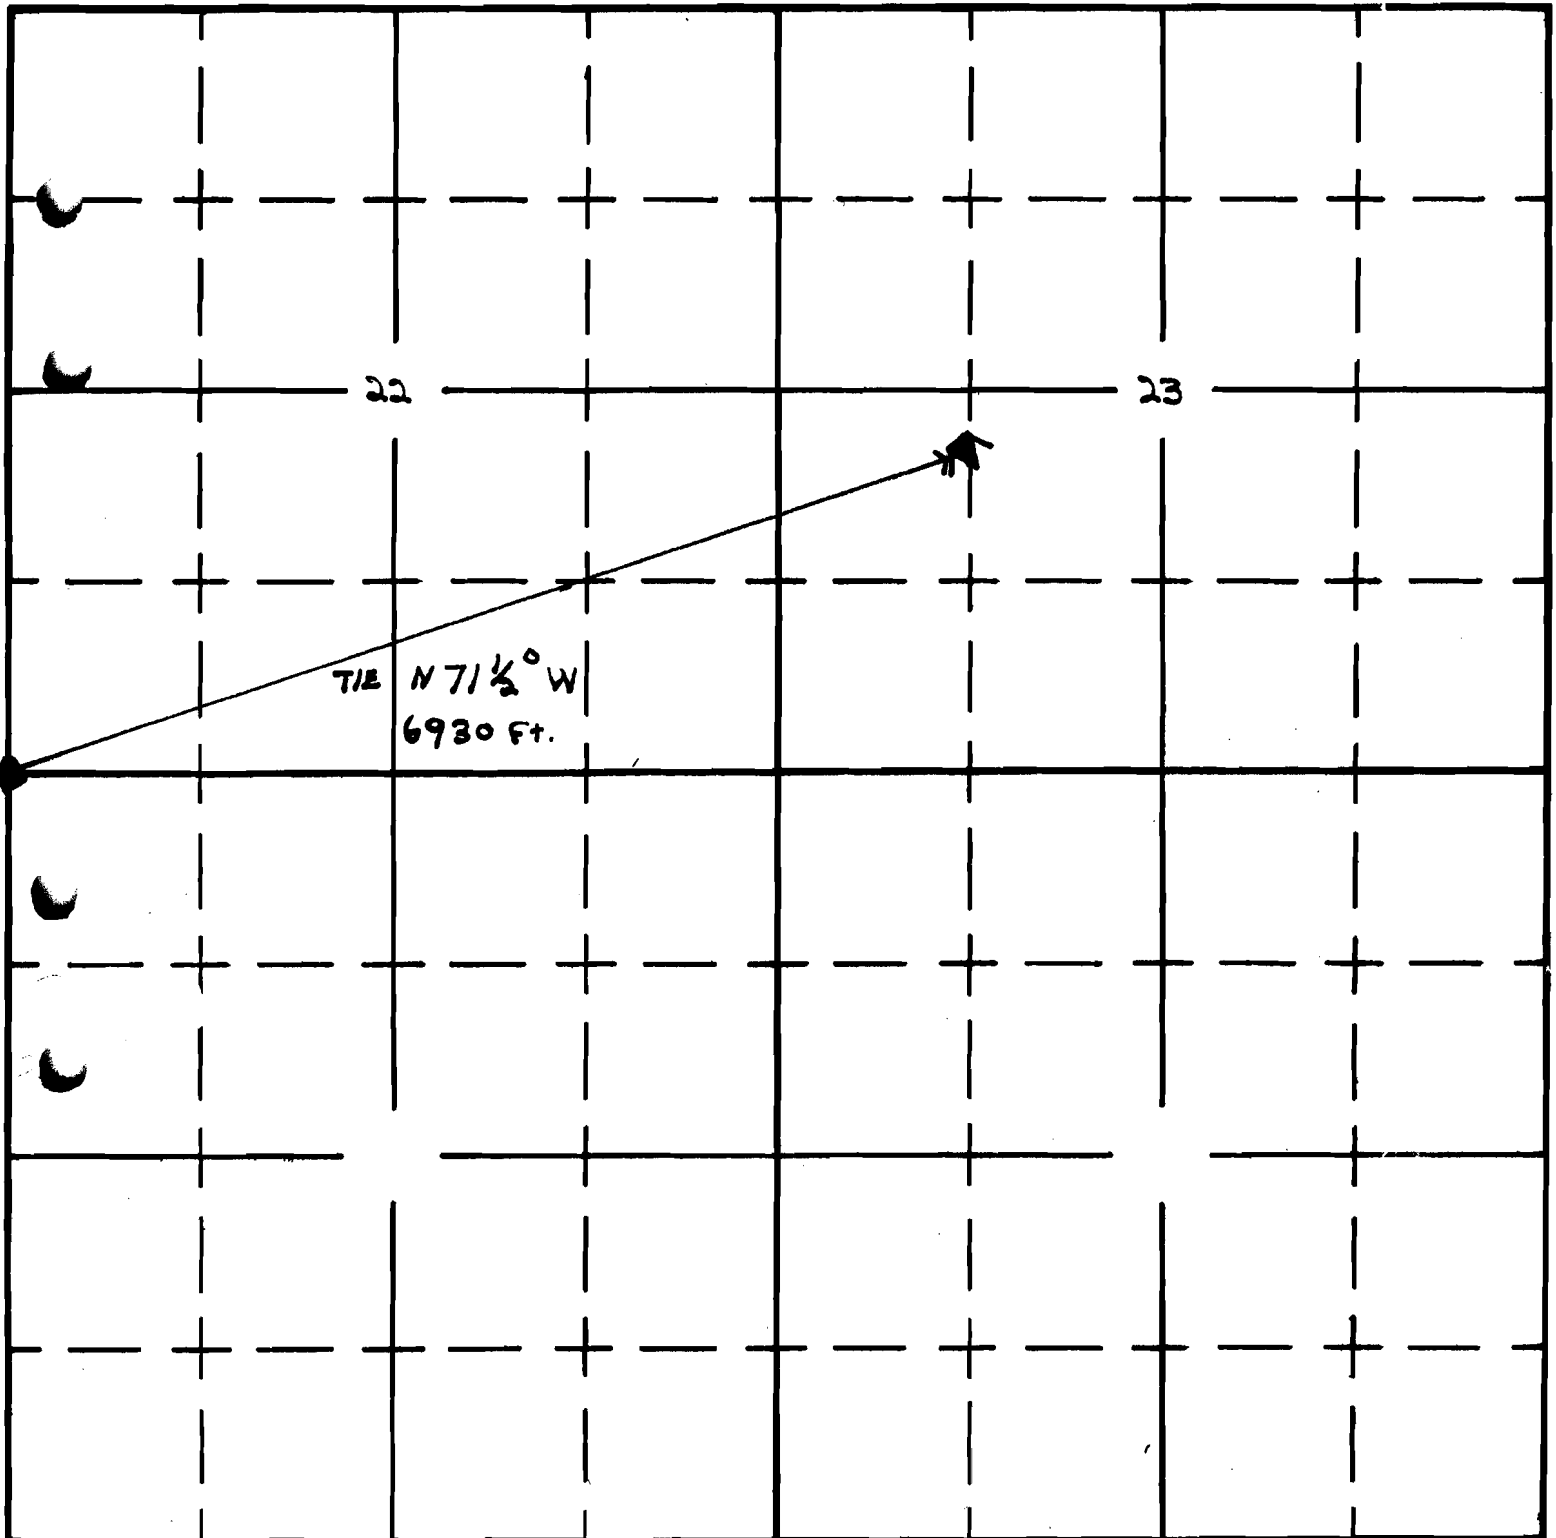

◆ FOUND SURVEY CORNER

South

✦ PROJECT

APPLICATION No. R-34372

PERMIT No. R-2748