

UNITED STATES
DEPARTMENT OF THE INTERIOR
BUREAU OF LAND MANAGEMENT


SECTION

NE⁴SW⁴ 33

Oregon State Water Filings

TOWNSHIP 27-S, RANGE 13-E, W. M.

North

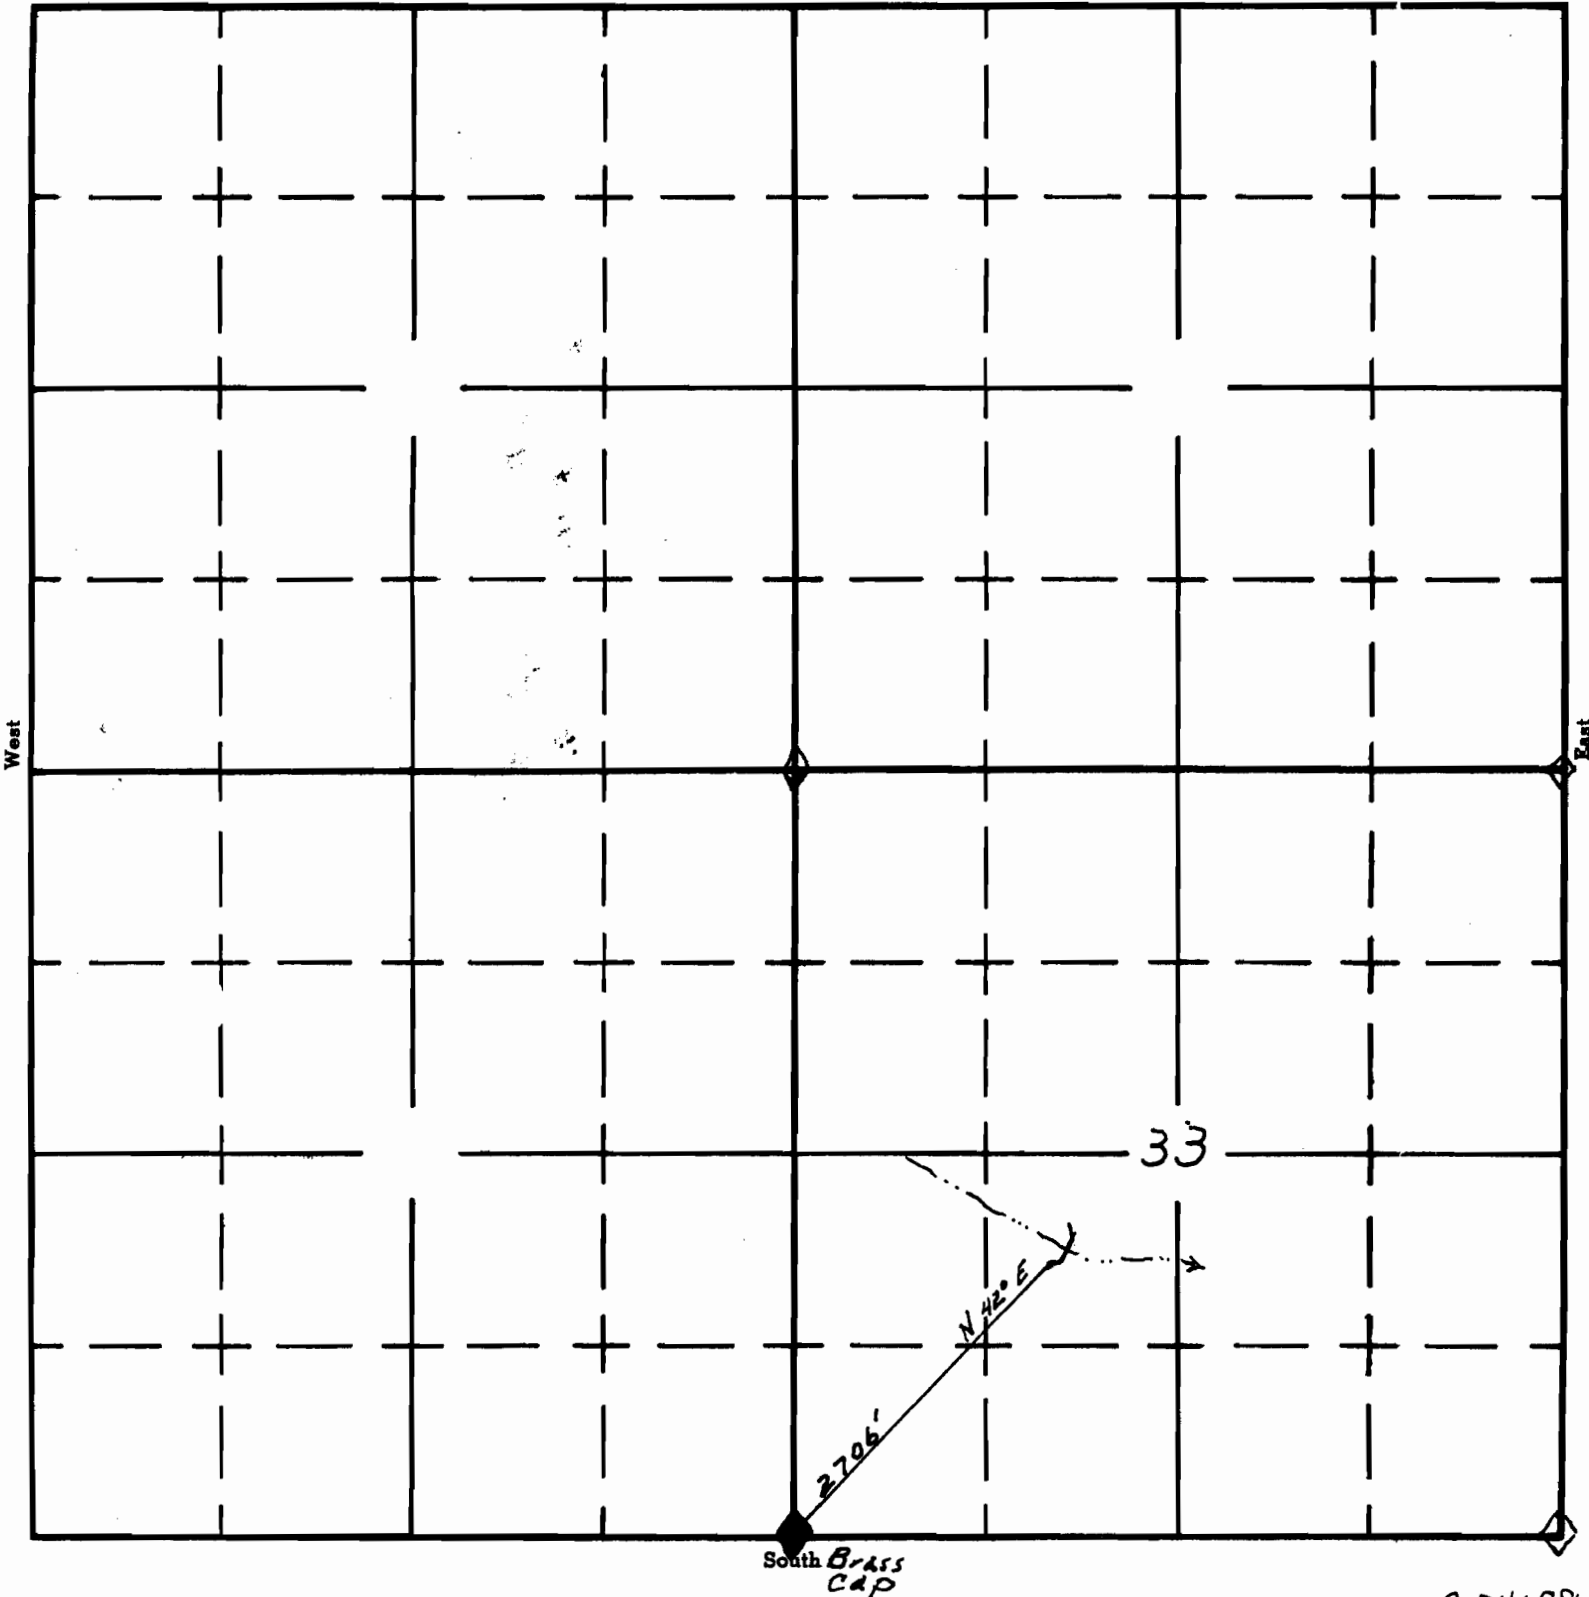

APPLICATION No. R-34679

PERMIT No. R-2790