

Form AI-187
March 1961

UNITED STATES
DEPARTMENT OF THE INTERIOR
BUREAU OF LAND MANAGEMENT

SECTION


5

Oregon State Water Filings

TOWNSHIP 28-S, RANGE 13-E, W. M.

RECORDED
INDEXED
SERIALIZED
FILED

North

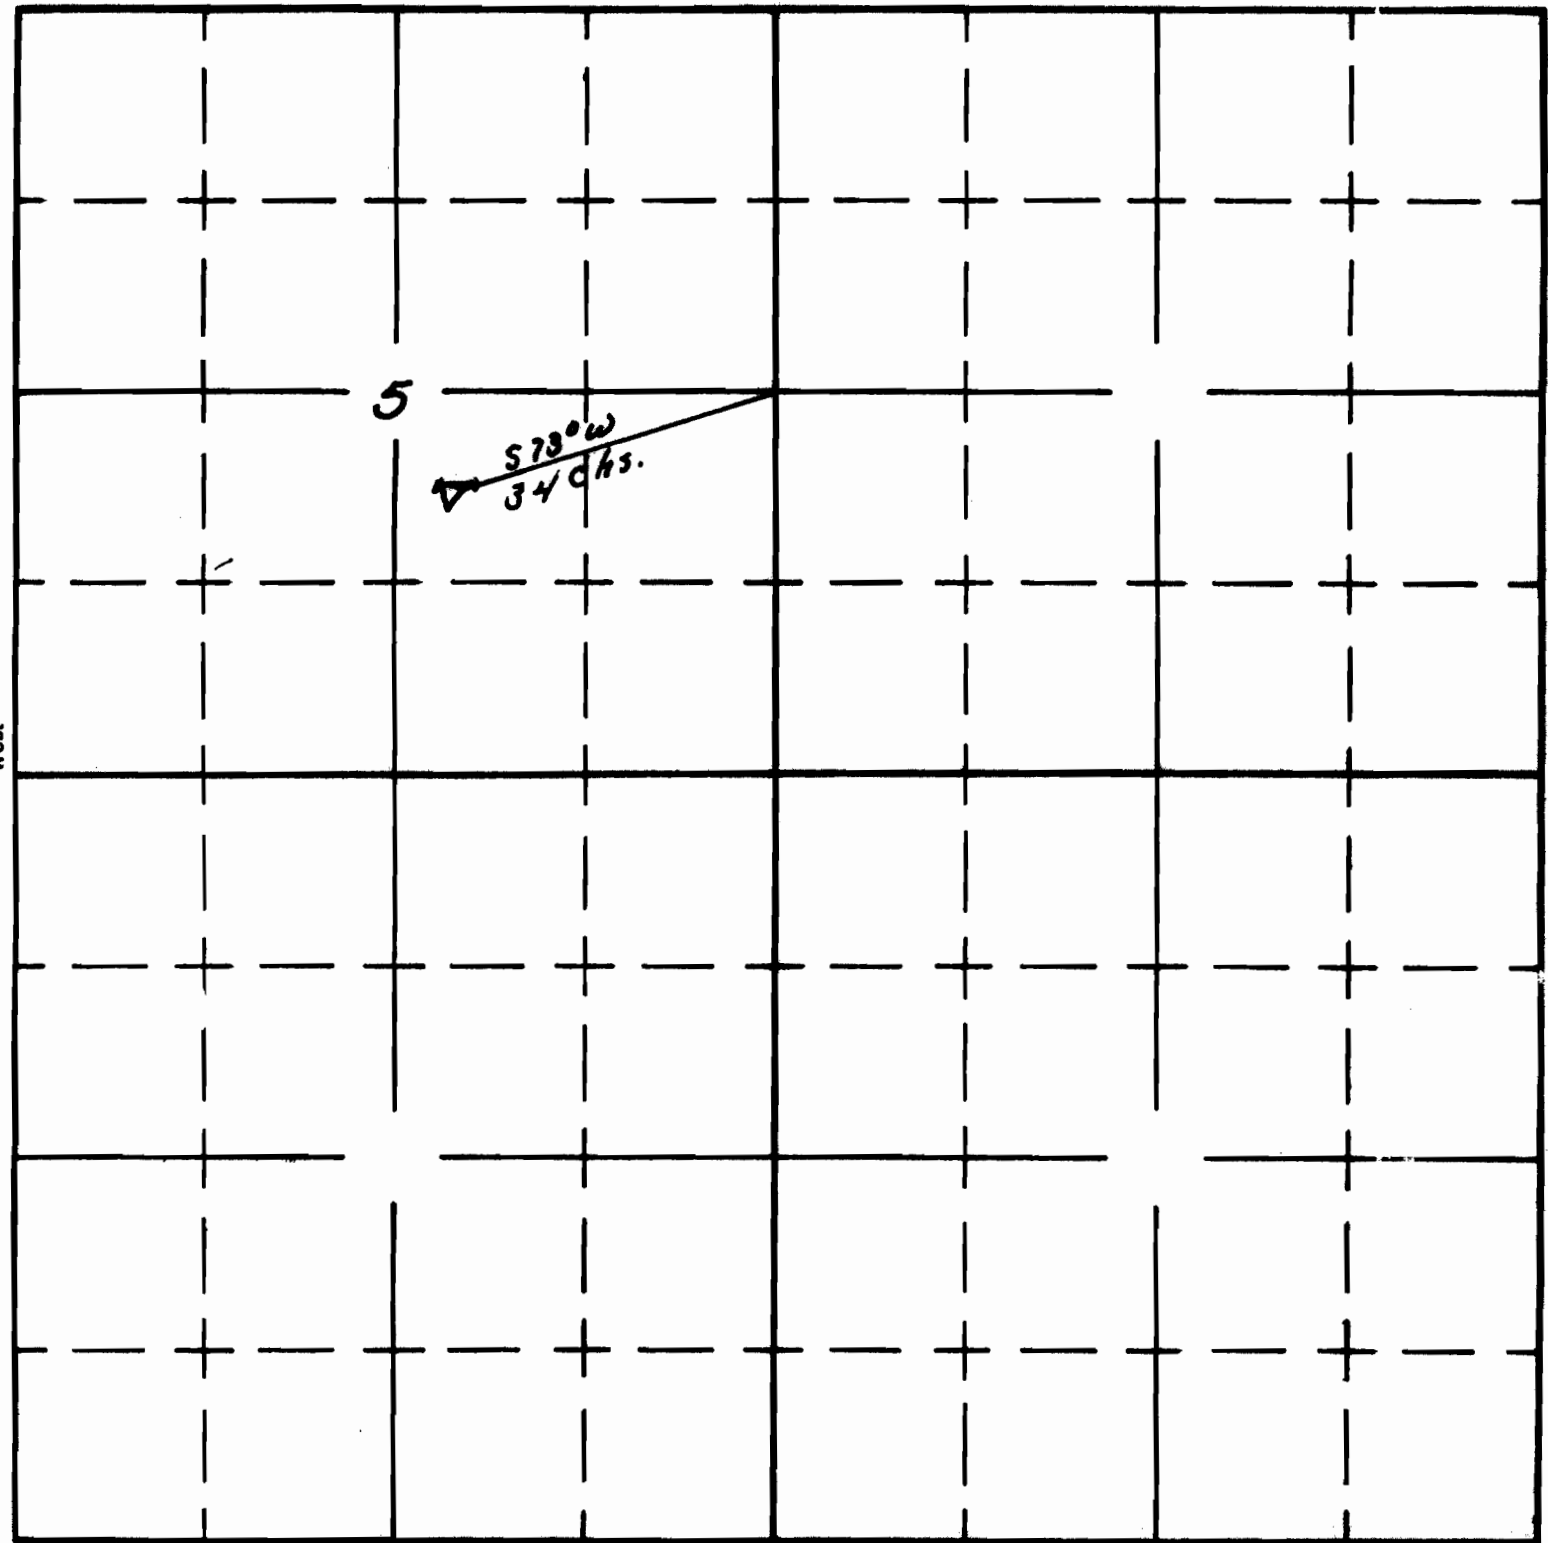

South

APPLICATION No. P-34680

PERMIT No. R-2791