


UNITED STATES
DEPARTMENT OF THE INTERIOR
BUREAU OF LAND MANAGEMENT

SECTION

SE 1/4 SE 1/4 1

Oregon State Water Filings

TOWNSHIP 29-S, RANGE 13-E, W. M.

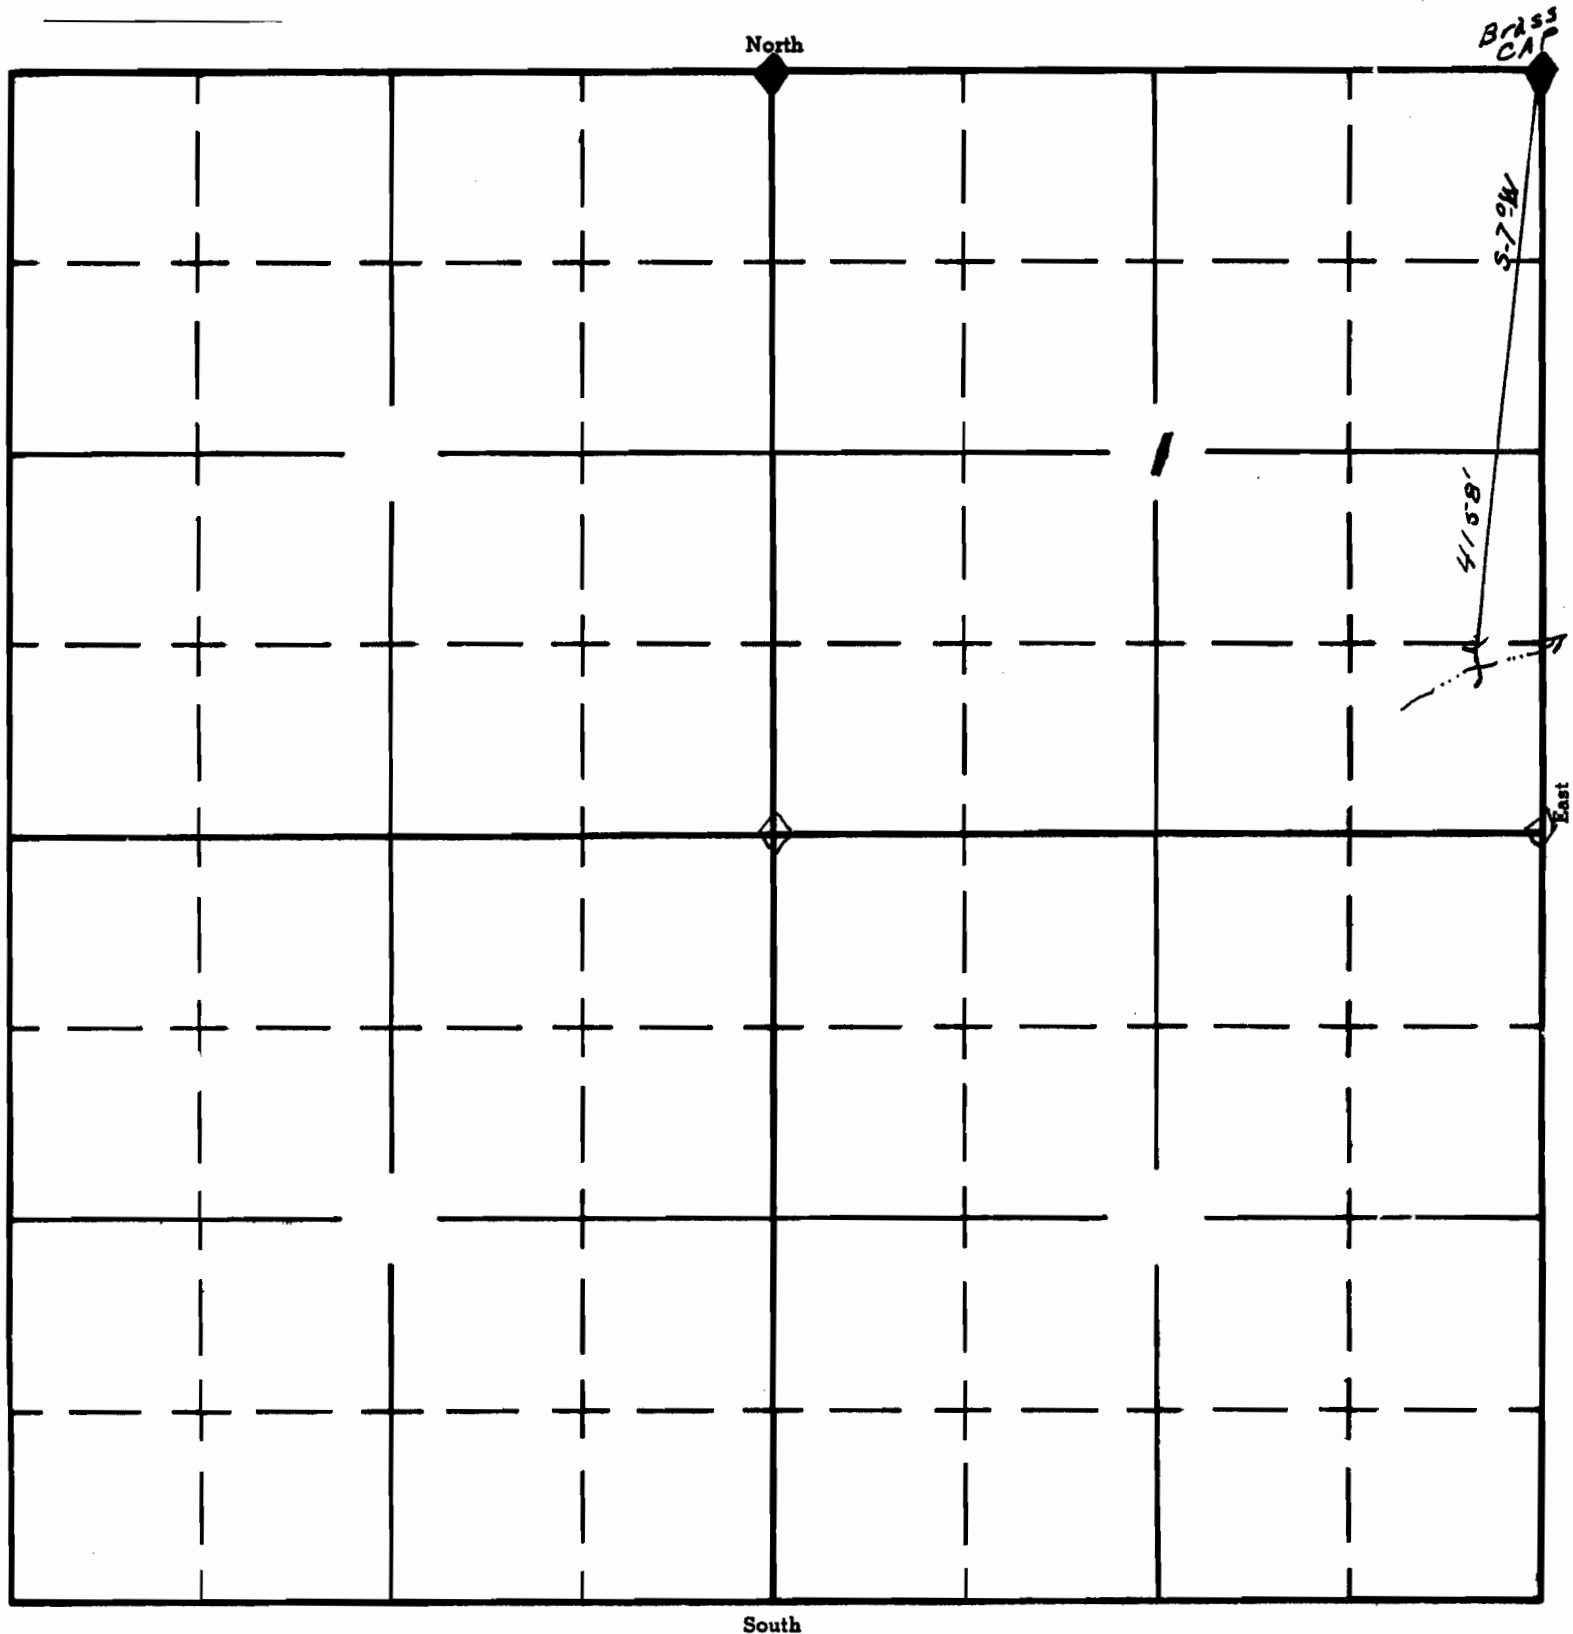

APPLICATION No. R-34681

PERMIT No. R-2792