

Form A1-187
March 1961

UNITED STATES
DEPARTMENT OF THE INTERIOR
BUREAU OF LAND MANAGEMENT

RECEIVED
MAY 24 1961
STATE ENGINEER
SALEM, OREGON


SECTION

//

Oregon State Water Filings

TOWNSHIP 29-S, RANGE 14-E, W. M.

North

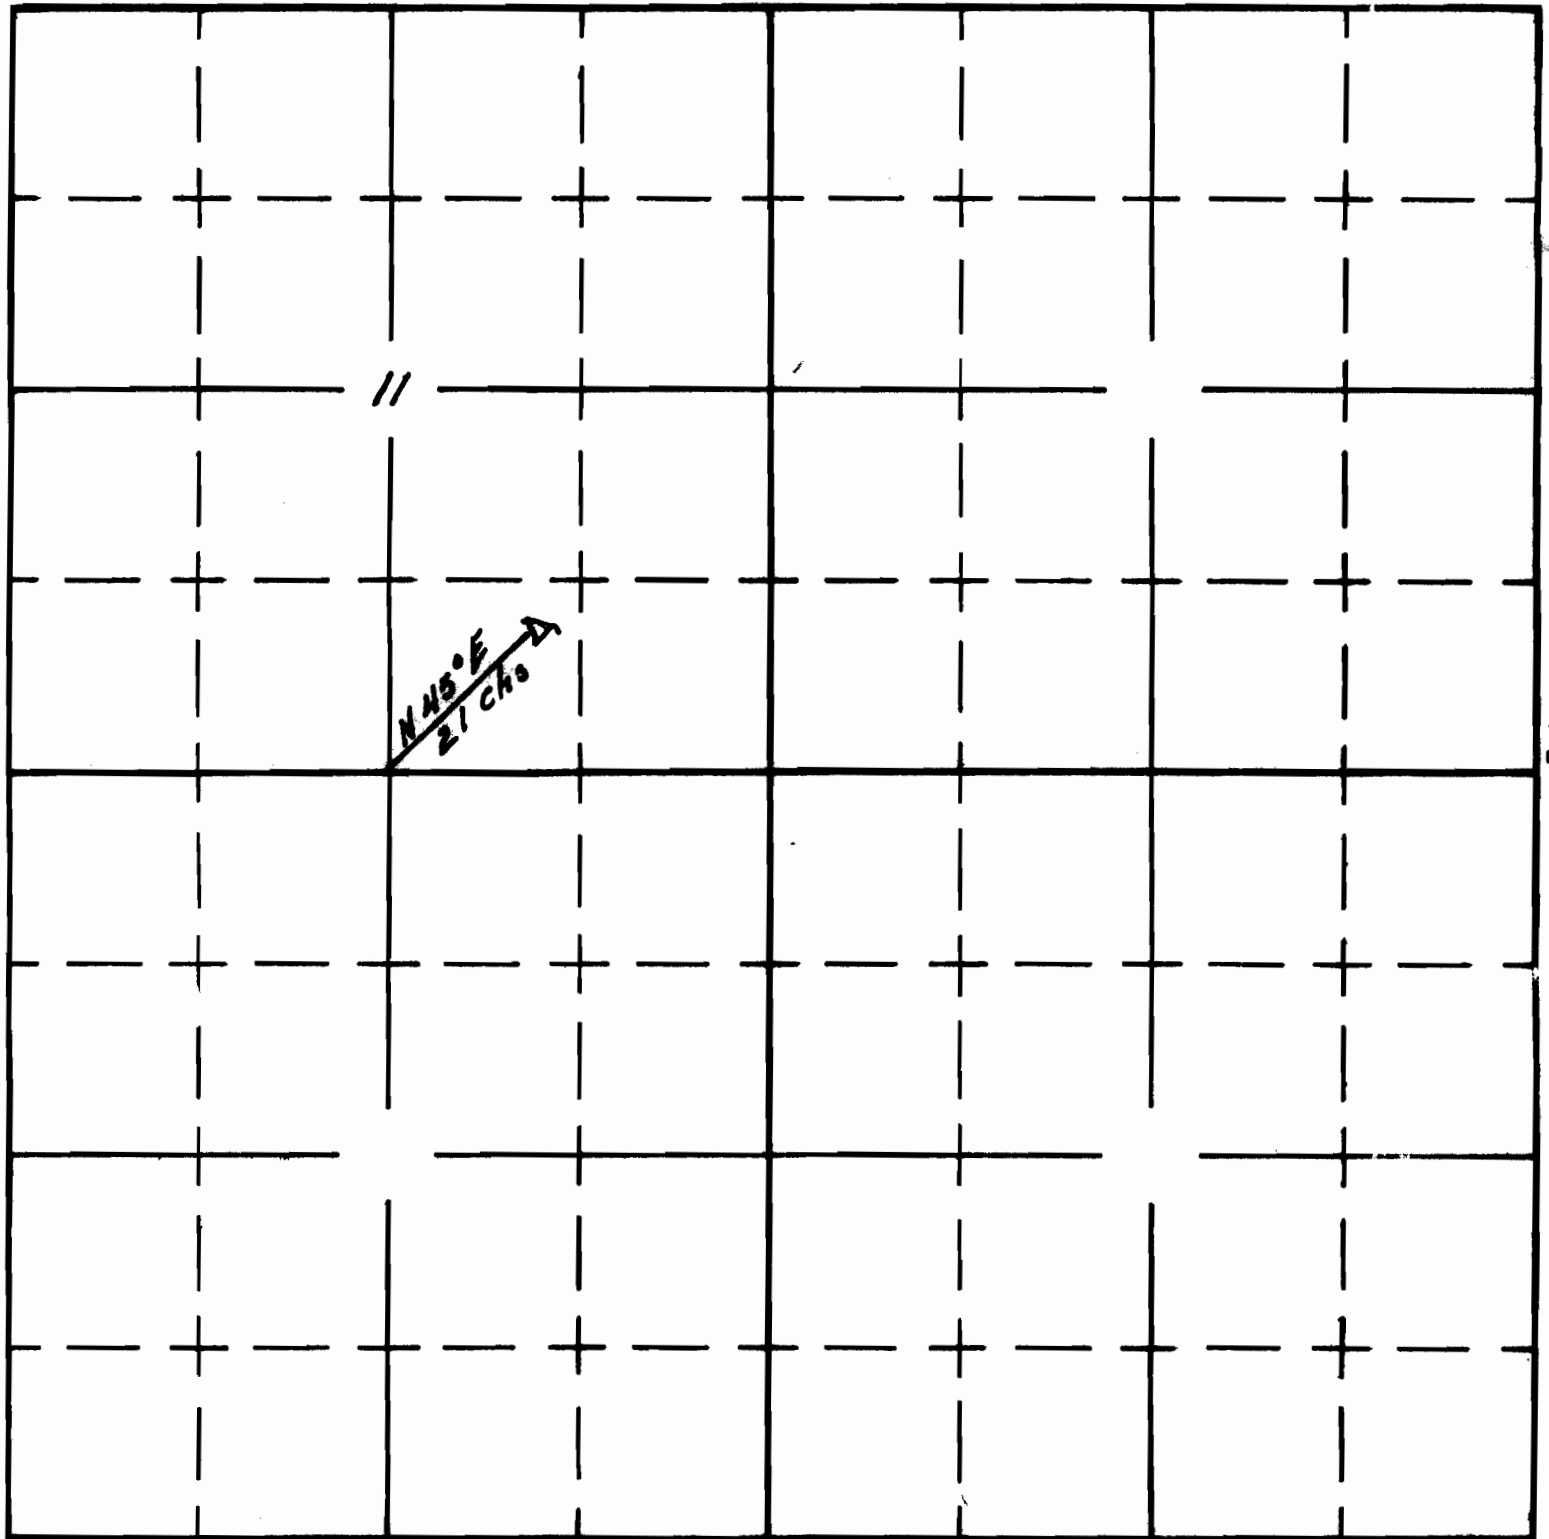

South

APPLICATION No. R-34682

PERMIT No. R-2793