

BLM
PLS. No. 50-1-658


UNITED STATES
DEPARTMENT OF THE INTERIOR
BUREAU OF LAND MANAGEMENT

SECTION 17
SW 1/4 SW 1/4

Oregon State Water Filings

TOWNSHIP 38 S, RANGE 26 E, W. M.

North

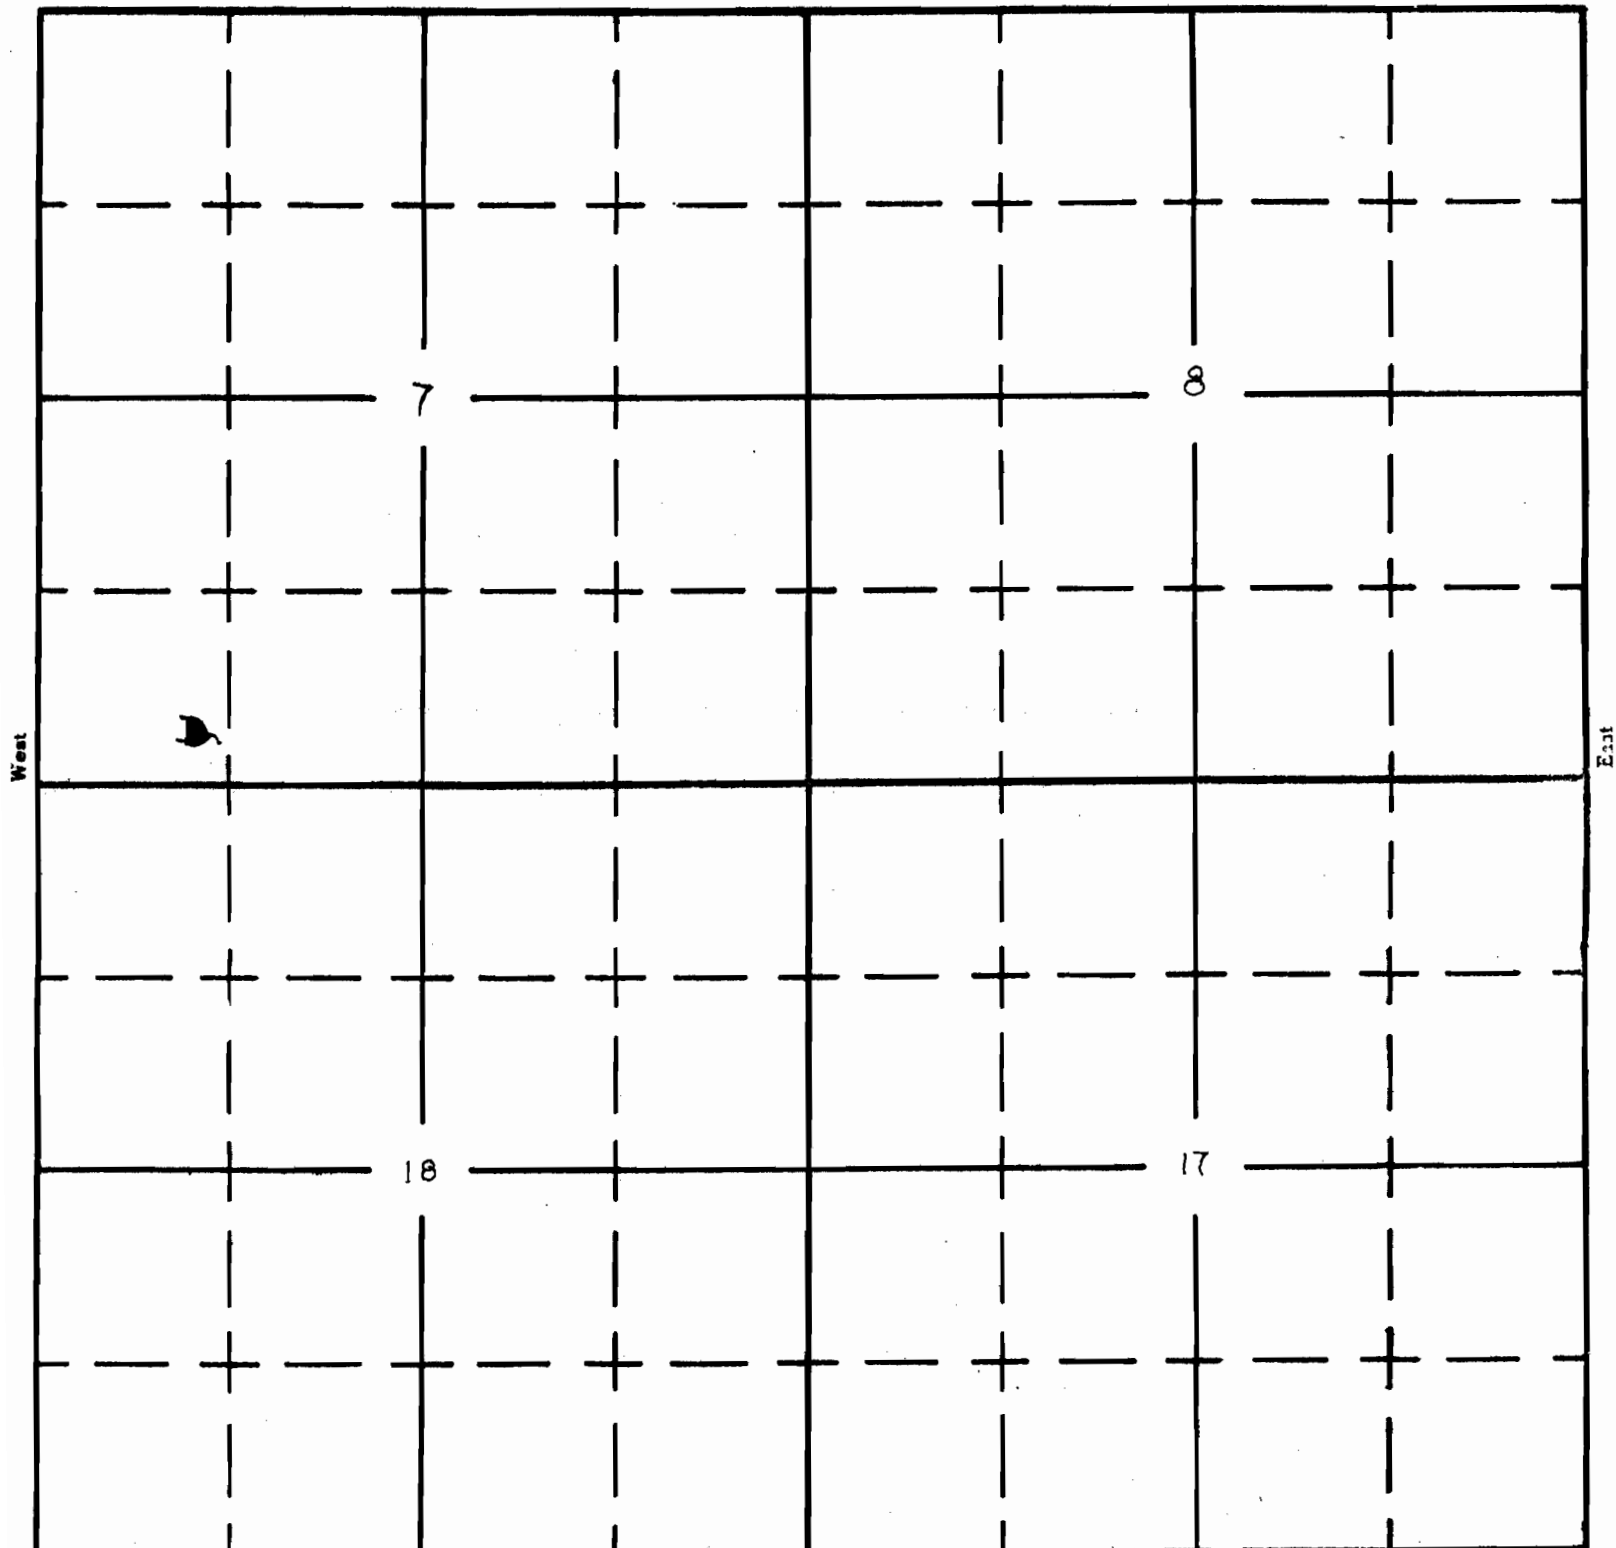

NO corner found within reasonable distance.
Location by corner projection from Oregon State Highway
Quad maps to aerial photos.

APPLICATION No. R-34700

PERMIT No. R-2799