

UNITED STATES
DEPARTMENT OF THE INTERIOR
BUREAU OF LAND MANAGEMENT


SECTION

NE⁴NE⁴ 20

Oregon State Water Filings

TOWNSHIP 38-S, RANGE 26-E, W. M.

North

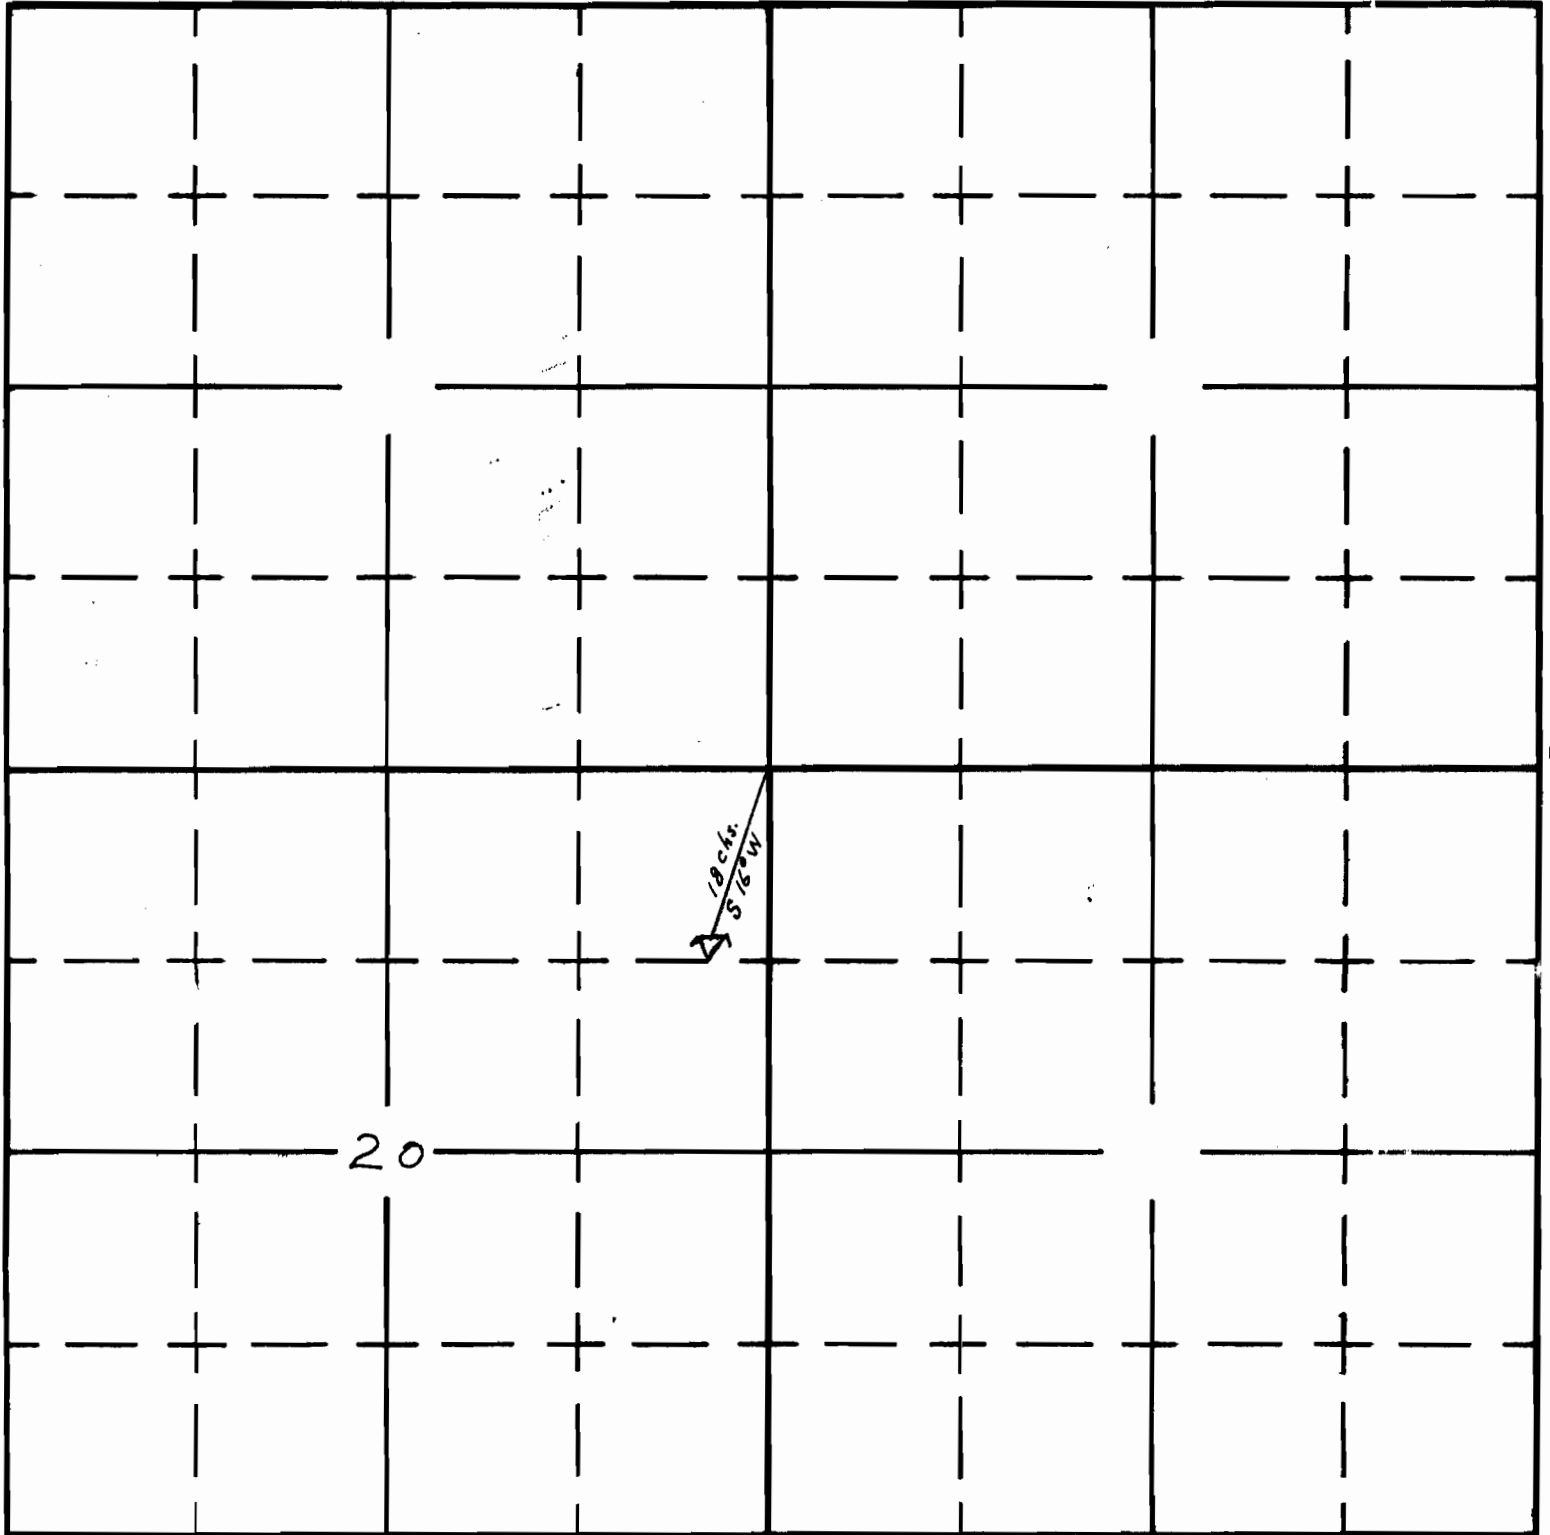

No corner found Located by aerial photo
And OSHD quad sheet

South

APPLICATION No. R-34702

PERMIT No. R-2801