

Form AI-187
March 1961

UNITED STATES
DEPARTMENT OF THE INTERIOR
BUREAU OF LAND MANAGEMENT

SECTION

SWNE⁴ Sec. 2


Oregon State Water Filings

TOWNSHIP 38S, RANGE 29E, W. M.

Corner Not Found.

Tied in with aerial photos OSHA Quad maps

North

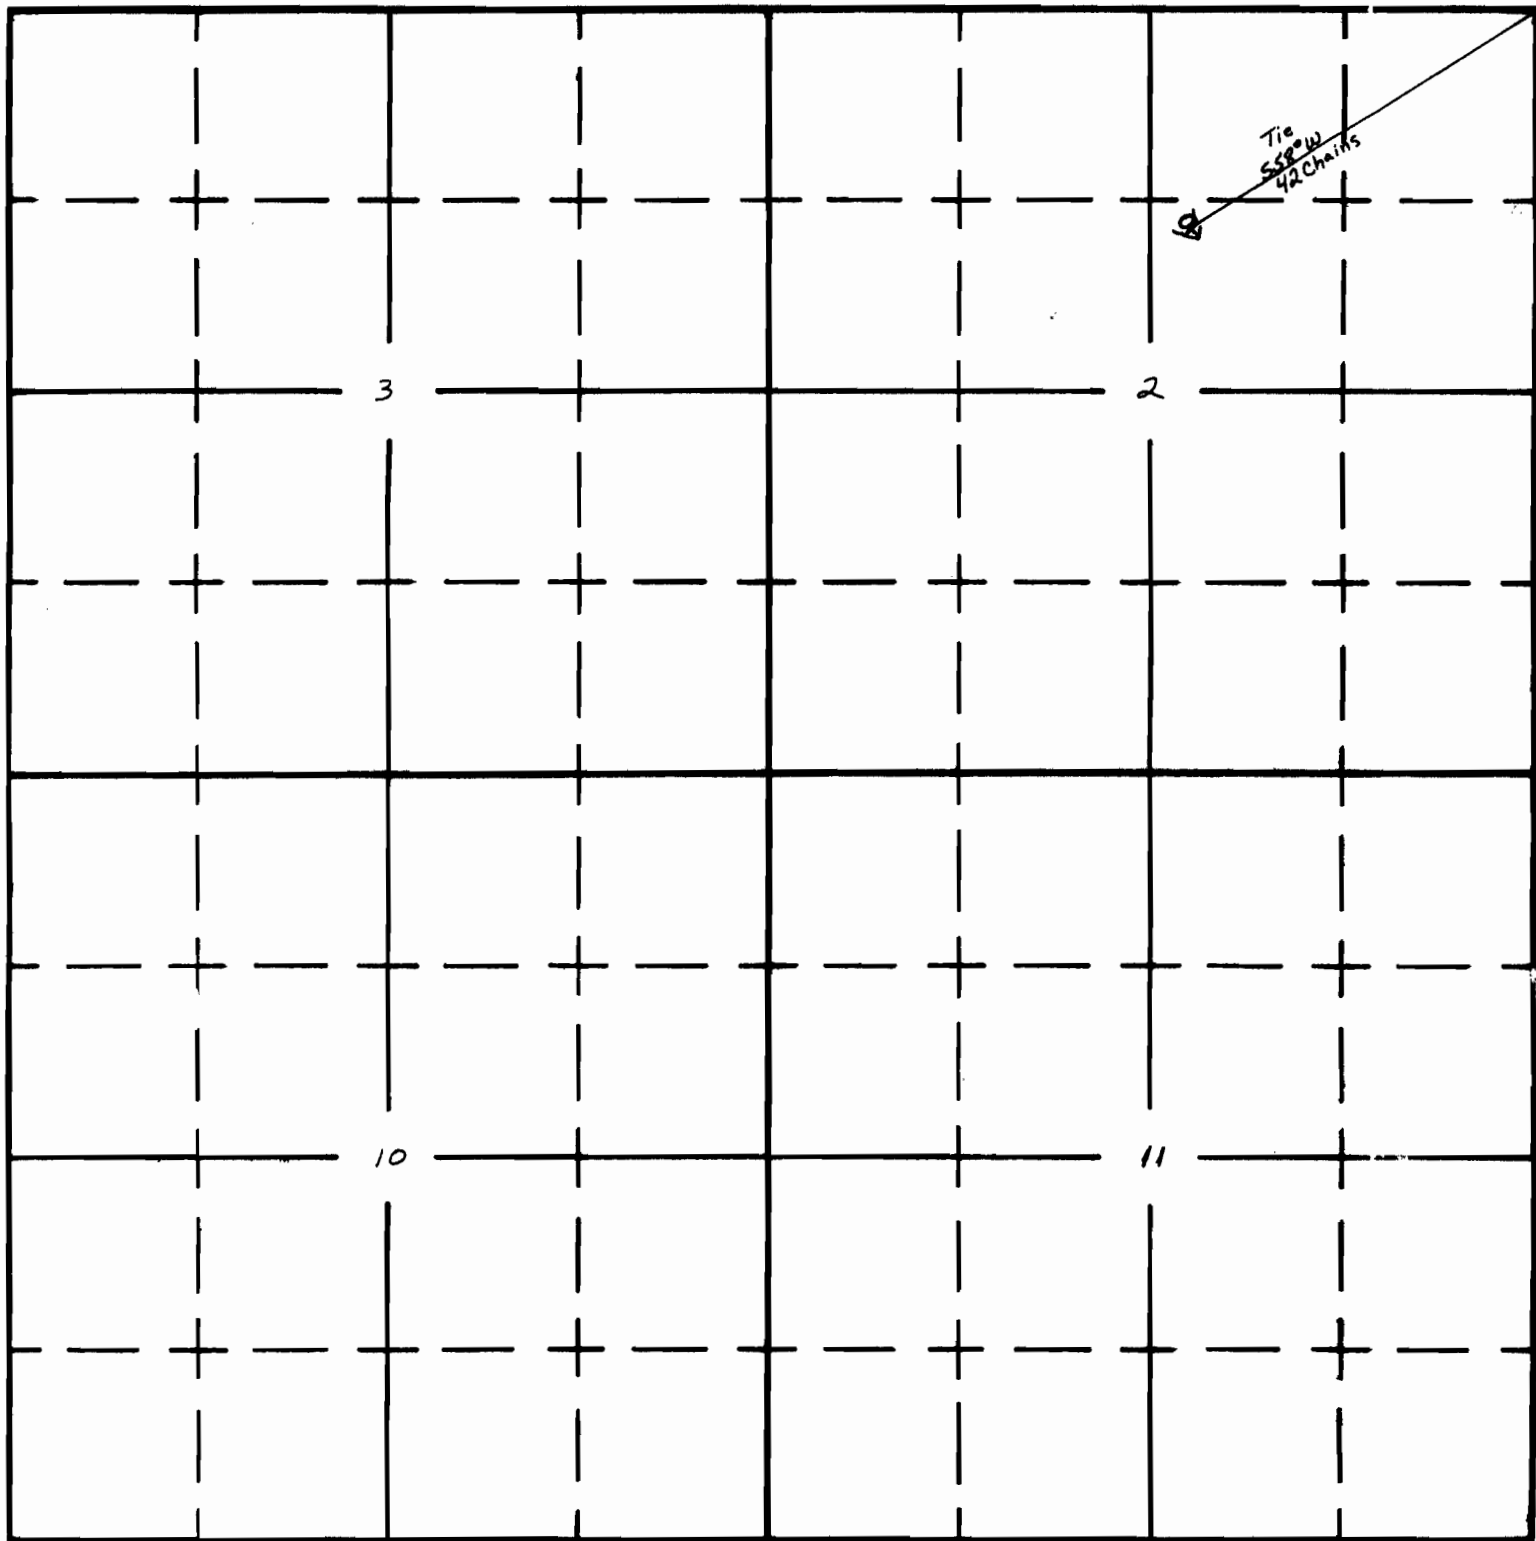

South

APPLICATION No. P-34705

PERMIT No. R-2804