

UNITED STATES
DEPARTMENT OF THE INTERIOR
BUREAU OF LAND MANAGEMENT


SECTION

3

Oregon State Water Filings

TOWNSHIP 37S, RANGE 29E, W. M.

North

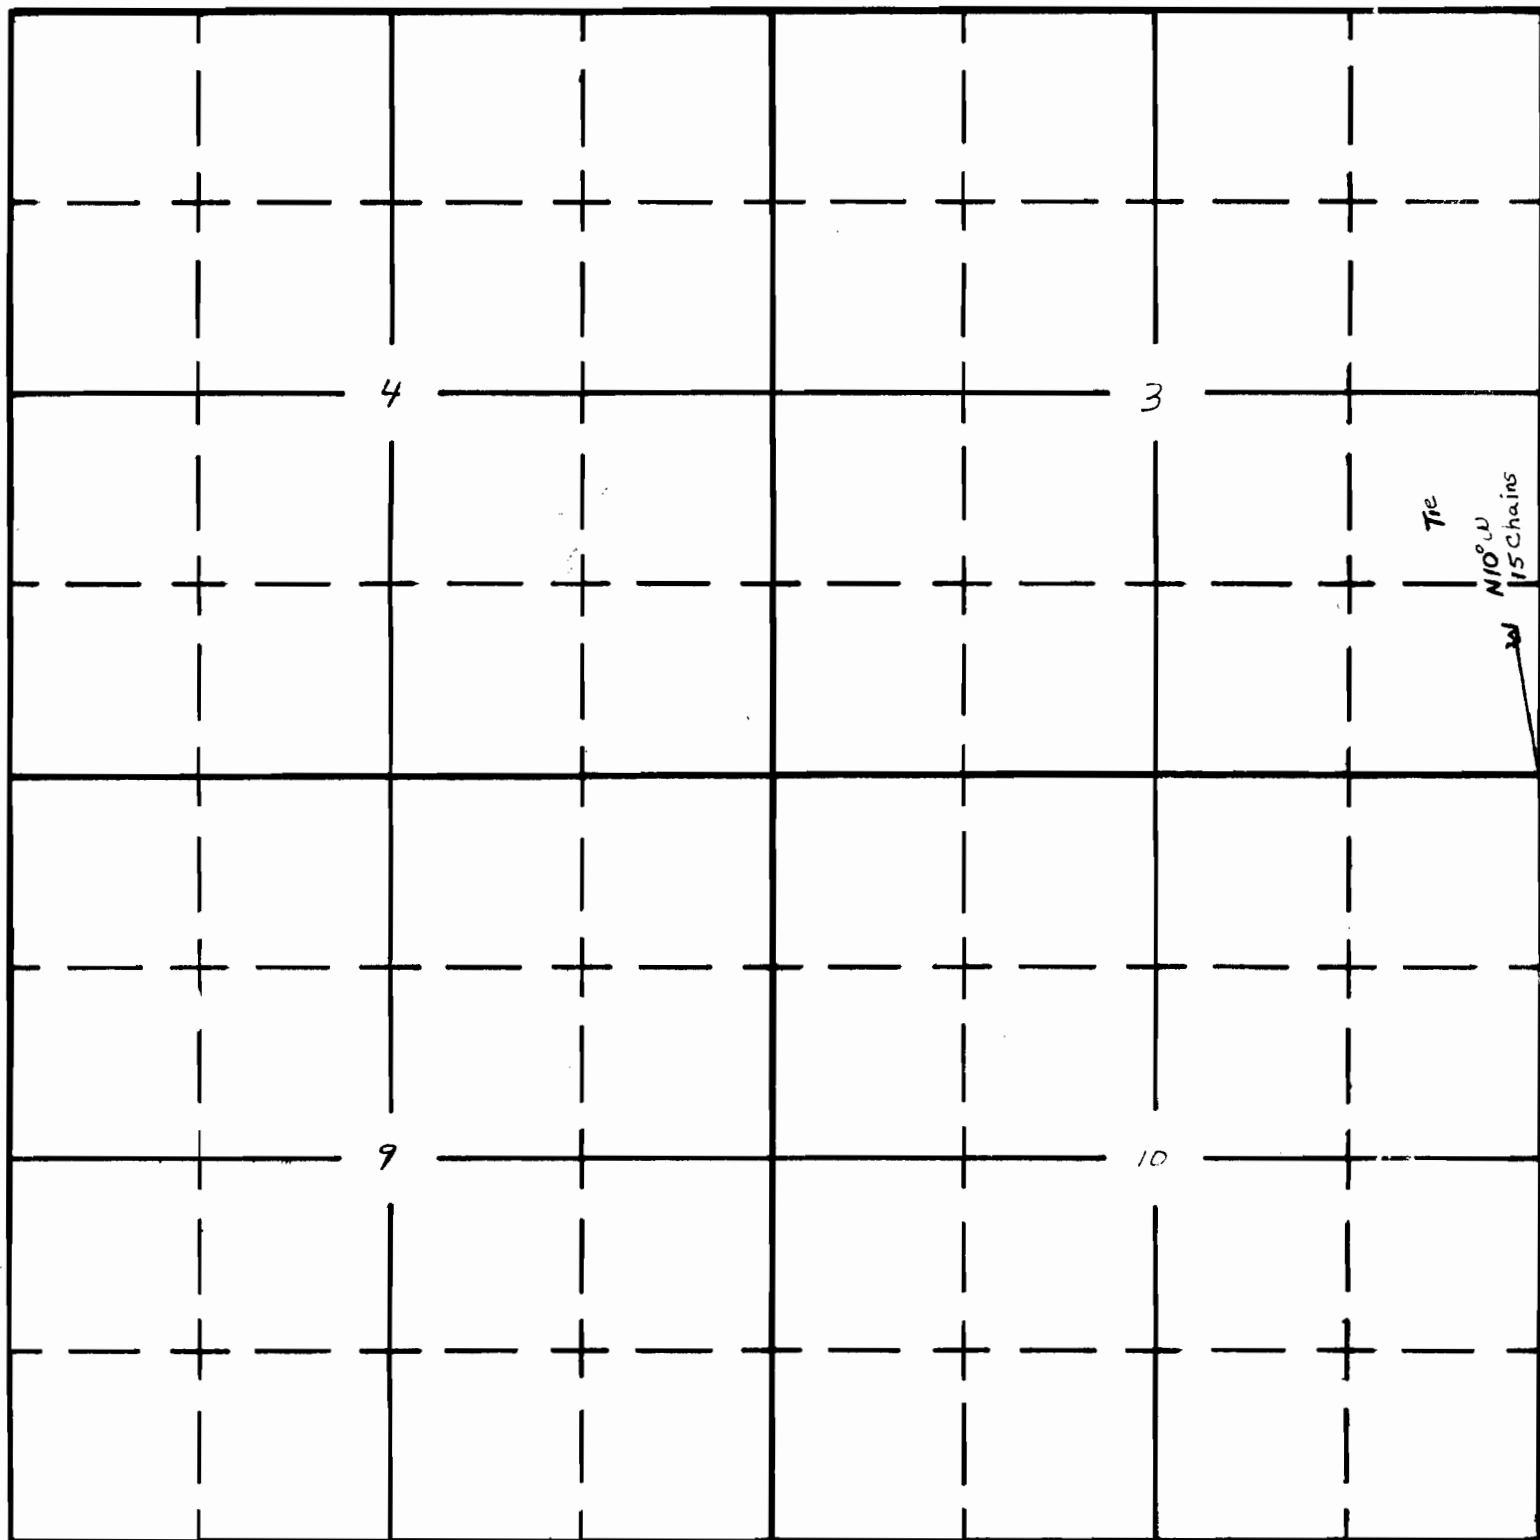

No CORNER FOUND

South

Tied in with aerial photos and Oregon State Highway Quad maps

APPLICATION No. R-34706

PERMIT No. R-2805