

UNITED STATES
DEPARTMENT OF THE INTERIOR
BUREAU OF LAND MANAGEMENT


SECTION

18

Oregon State Water Filings

TOWNSHIP 38S, RANGE 24E, W. M.

North

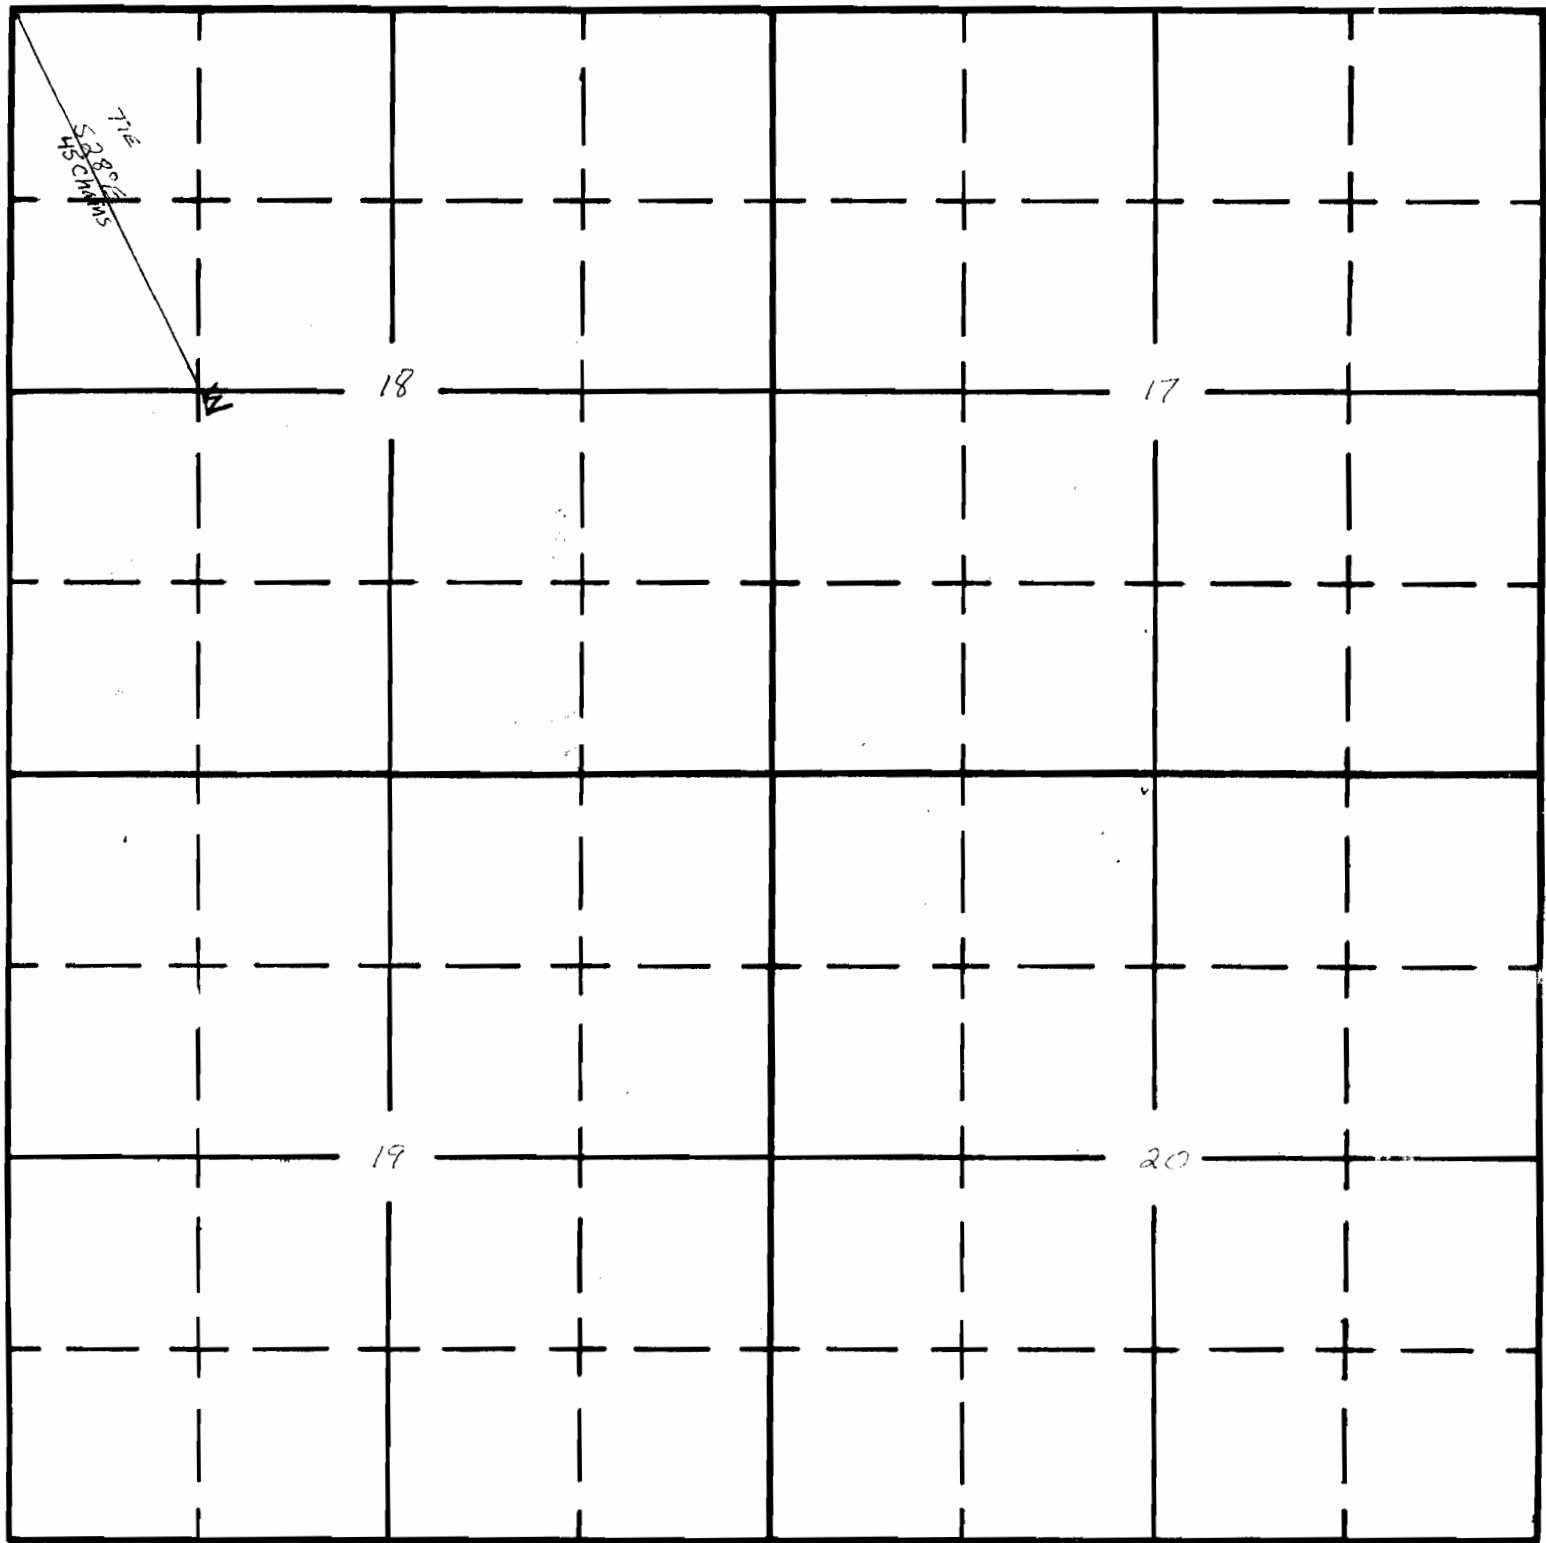

No CORNER Found

South

Tied in with aerial Photos and Oregon State Highway Quad maps

APPLICATION No. R-34712

PERMIT No. R-2811