

Form A1-187
March 1961


UNITED STATES
DEPARTMENT OF THE INTERIOR
BUREAU OF LAND MANAGEMENT

SECTION

19

Oregon State Water Filings

TOWNSHIP 30-S, RANGE 27-E, W. M.

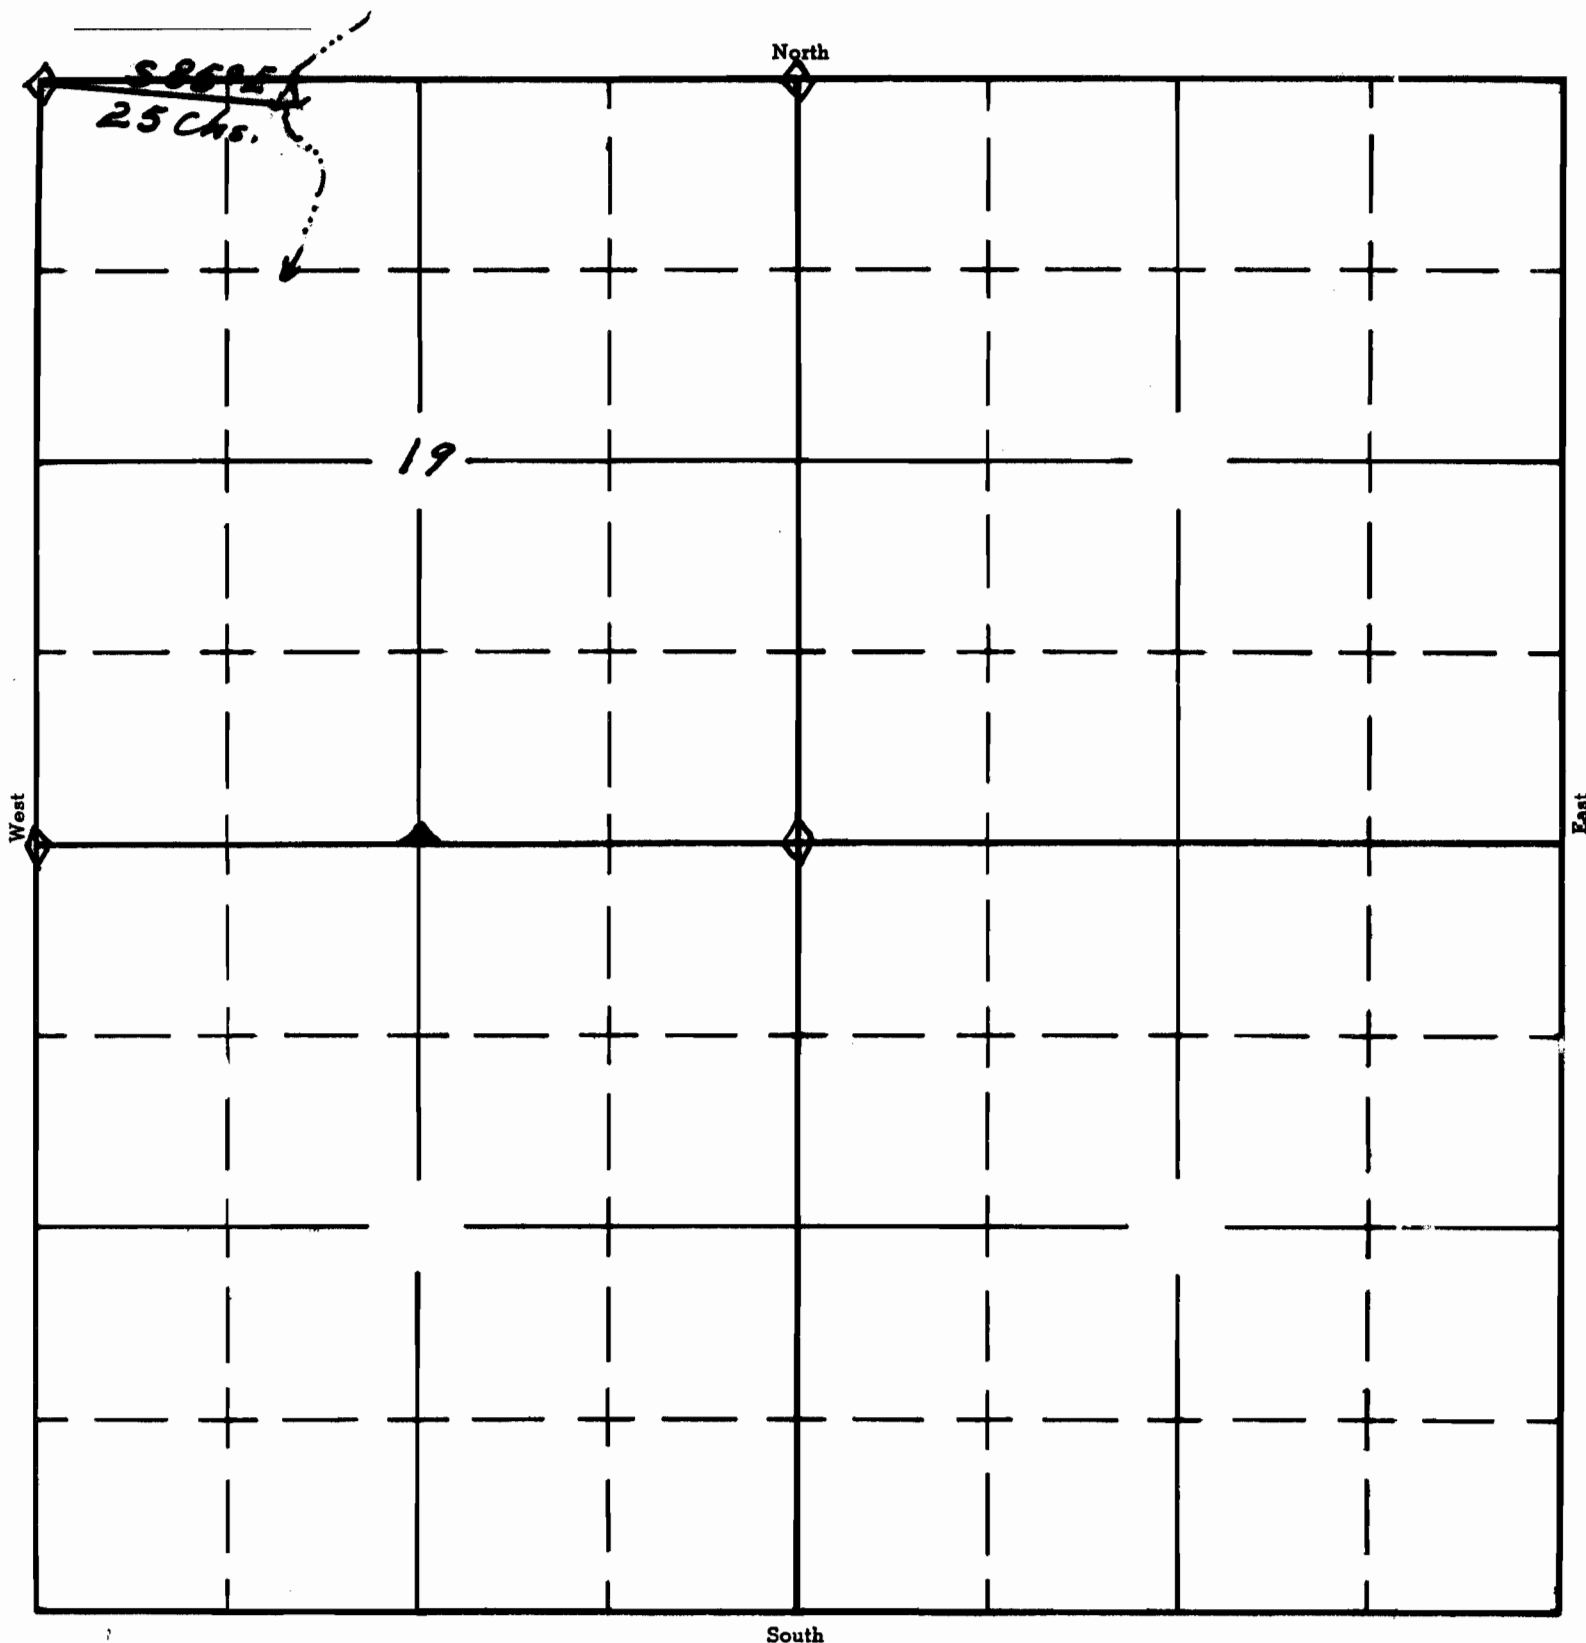

APPLICATION No. R-35077
PERMIT No. R-2818