

Form A1-187
March 1961

UNITED STATES
DEPARTMENT OF THE INTERIOR
BUREAU OF LAND MANAGEMENT

SECTION


10

SW $\frac{1}{4}$ SW $\frac{1}{4}$

Oregon State Water Filings

TOWNSHIP 36 S, RANGE 20 E, W. M.

North

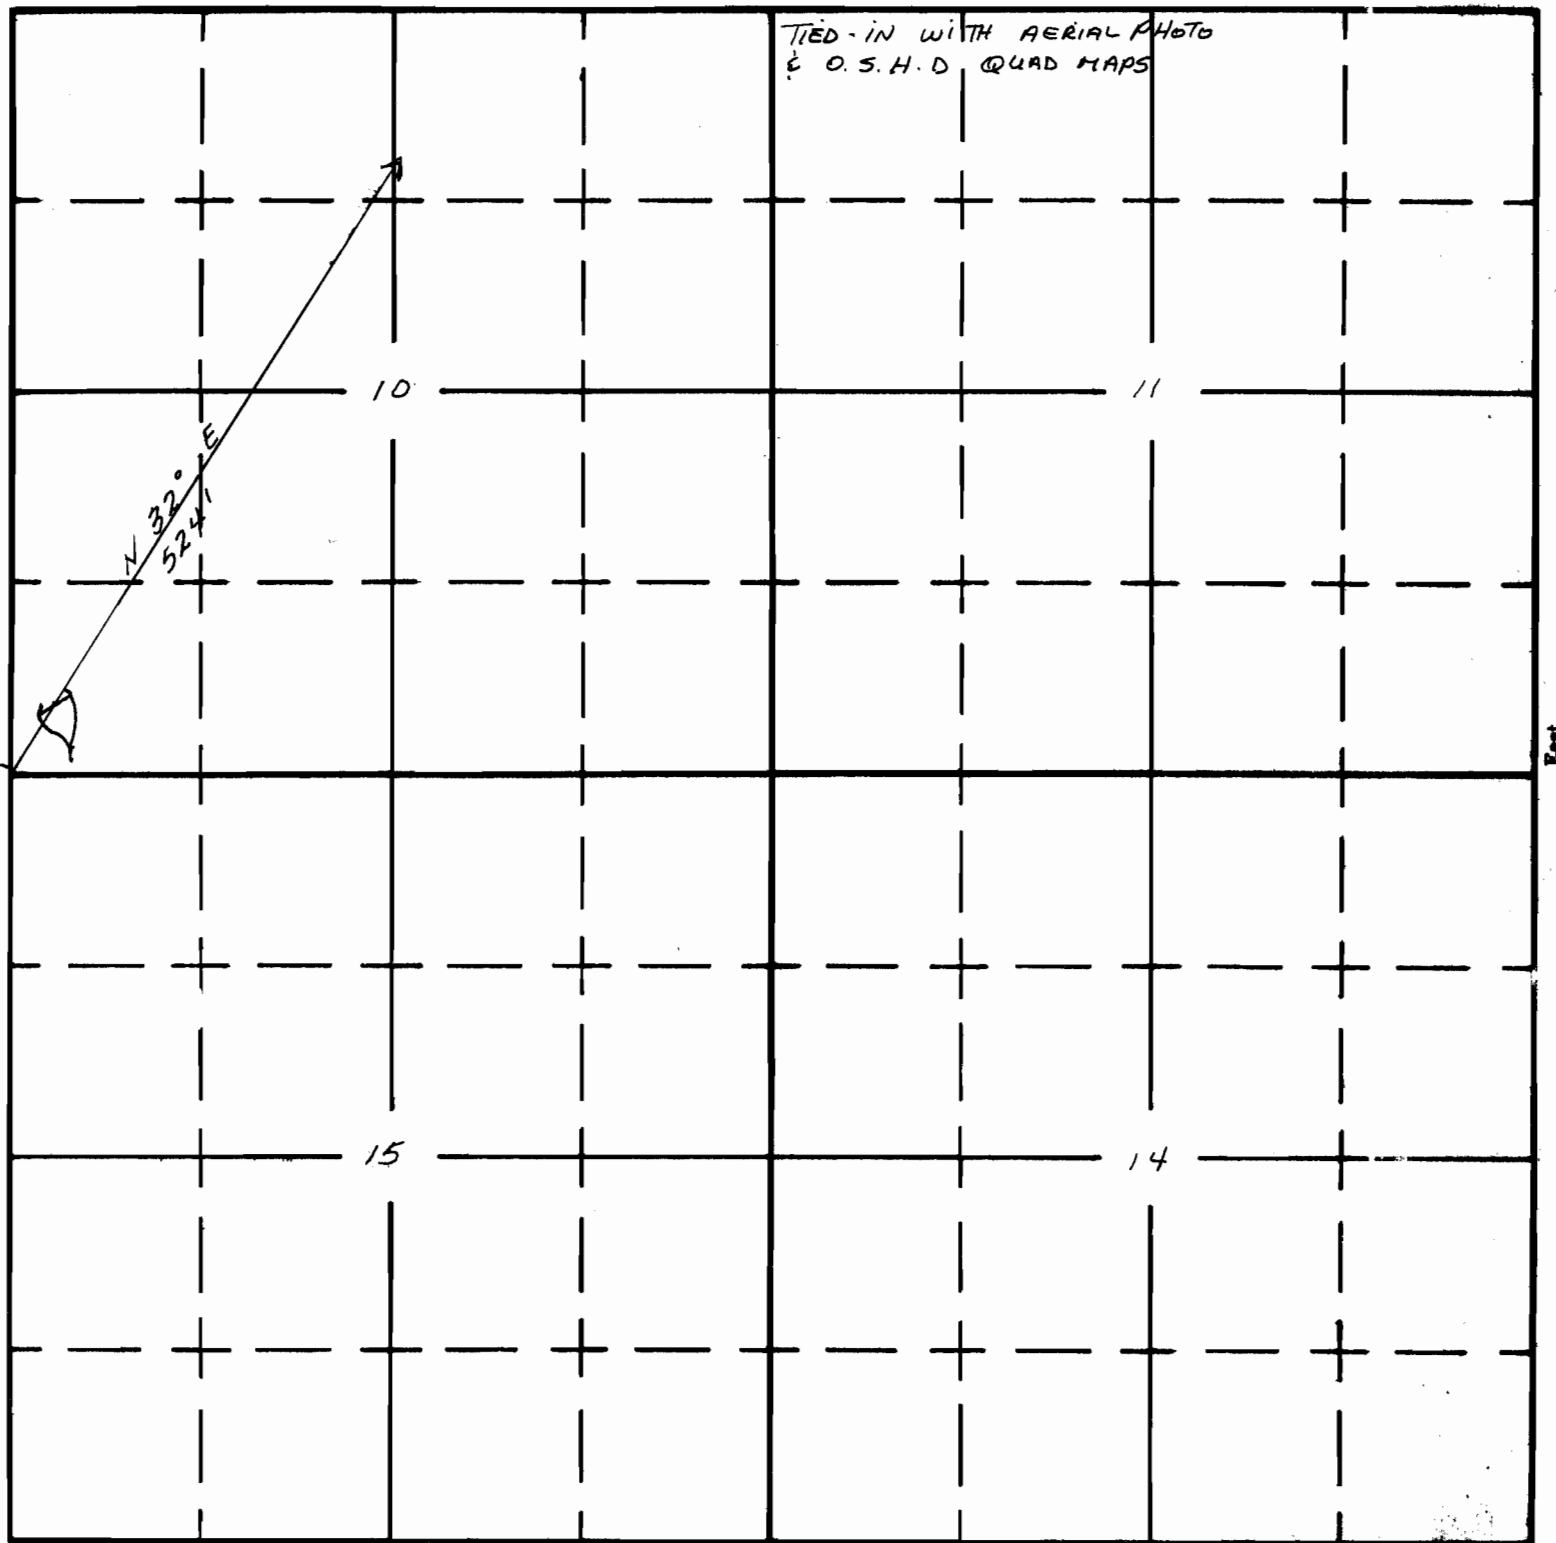

South

APPLICATION No. R-35130
PERMIT No. R-2837