

4 A1-187
March 1961

UNITED STATES
DEPARTMENT OF THE INTERIOR
BUREAU OF LAND MANAGEMENT

SECTION

8


NE 1/4 SW 1/4

Oregon State Water Filings

TOWNSHIP 25S, RANGE 21E, W. M.

North

Tied in with aerial Photo and G.S.M.P.
Quad Maps.

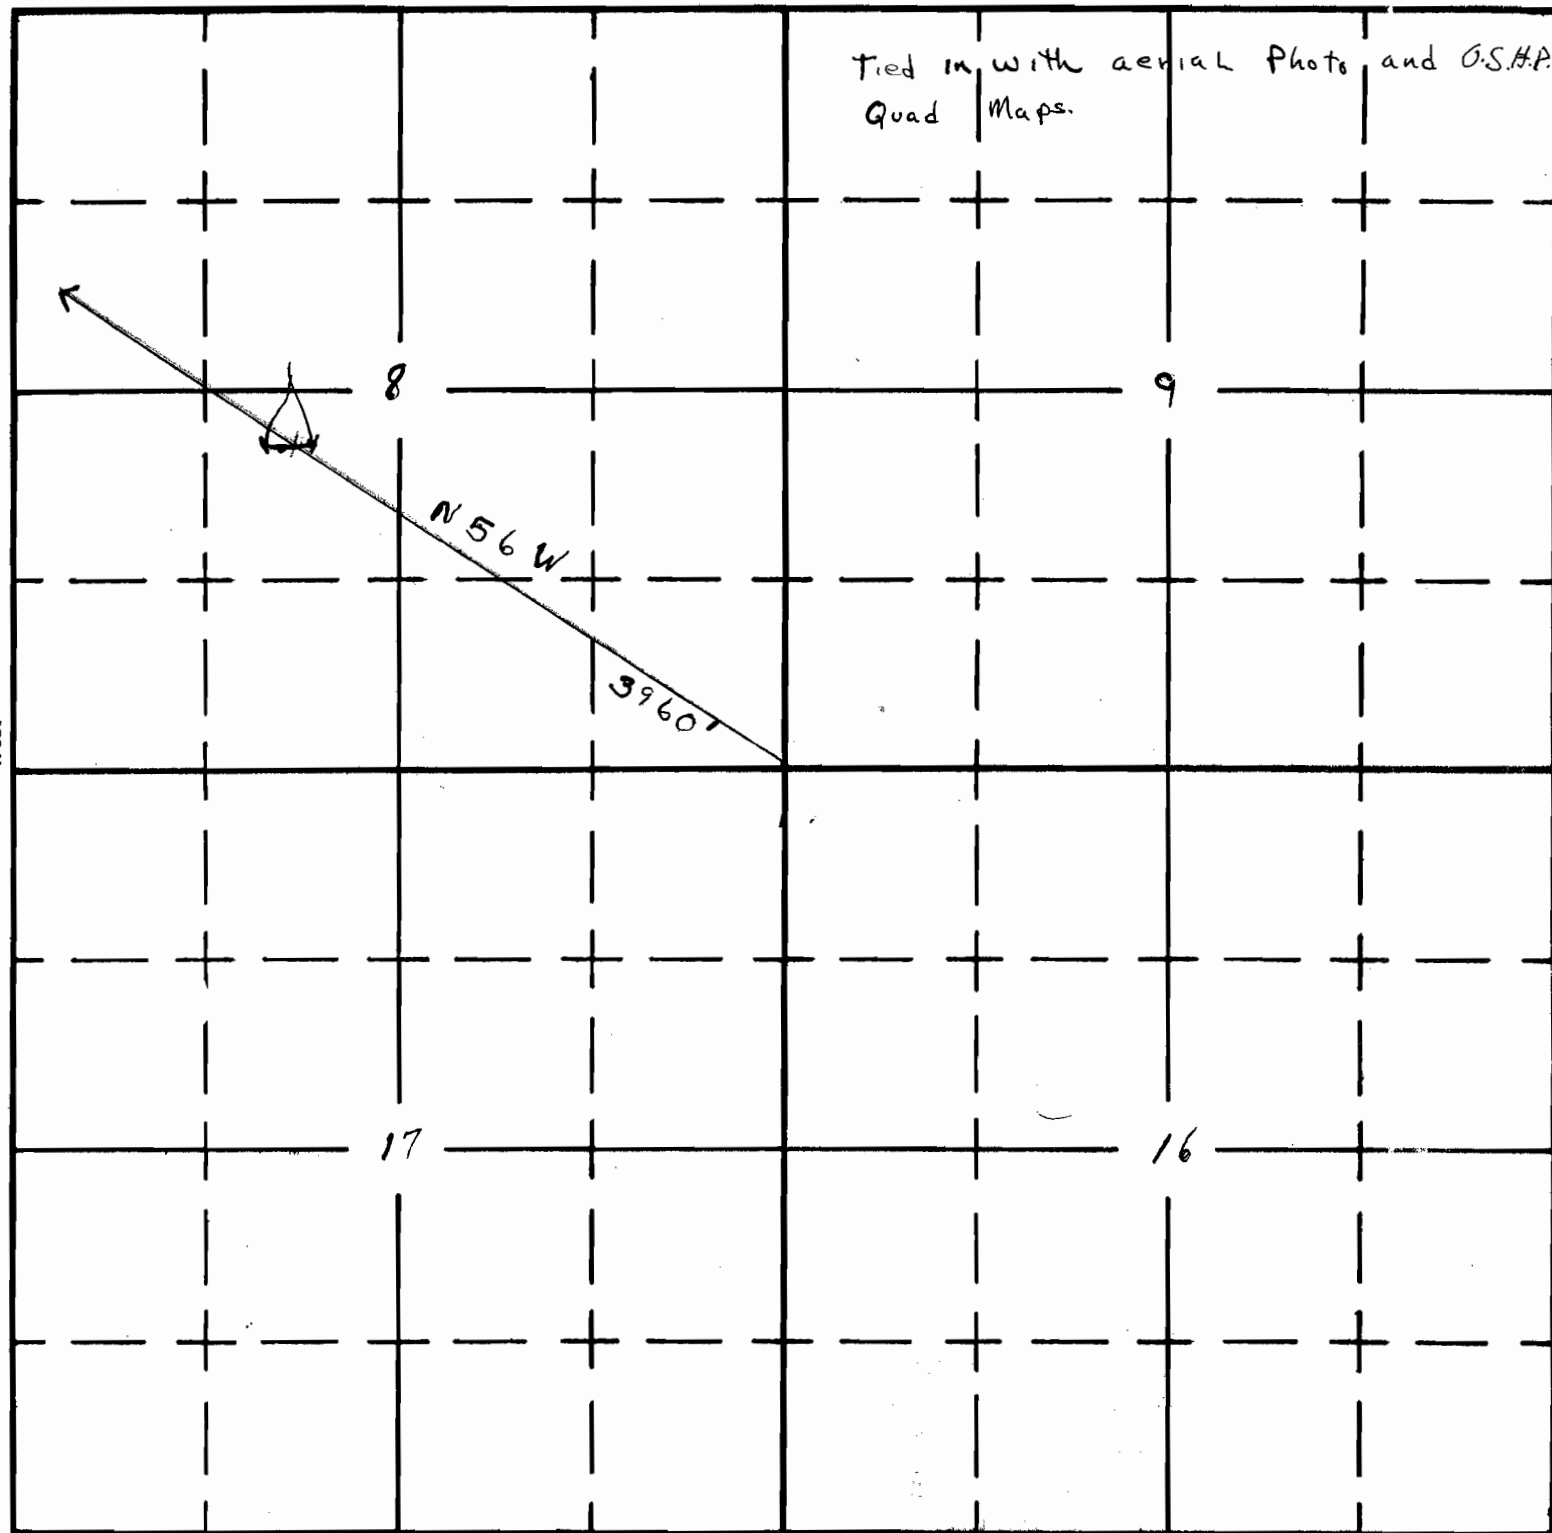

South

APPLICATION No. R-35131
PERMIT No. R-2846