

UNITED STATES
DEPARTMENT OF THE INTERIOR
BUREAU OF LAND MANAGEMENT

SECTION


27

NE 1/4 NW 1/4

Oregon State Water Filings

TOWNSHIP 28S, RANGE 17E, W. M.

North

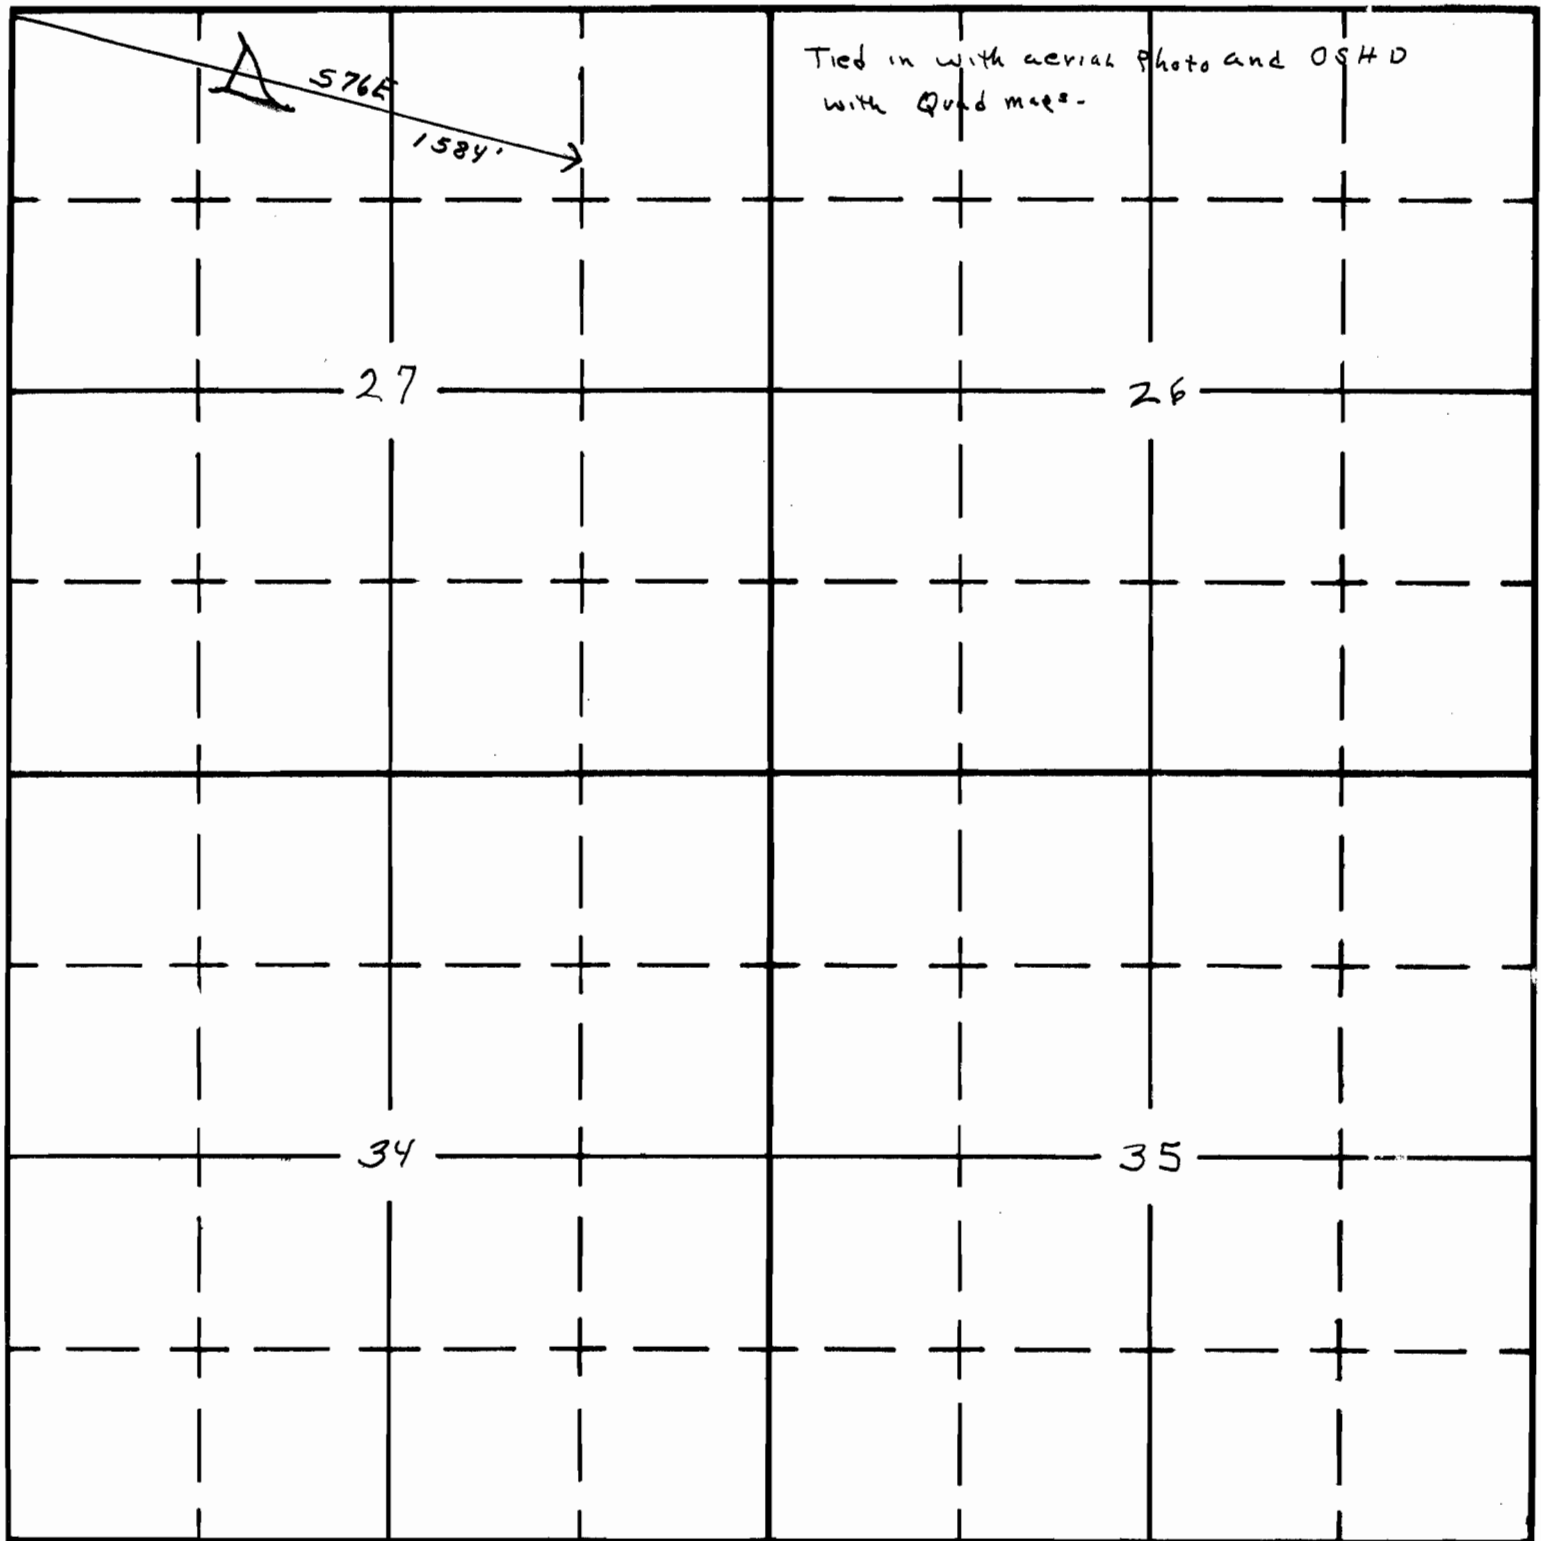

South

APPLICATION No. R-3514Z
PERMIT No. R-2849