

Form A1-187
March 1961

UNITED STATES
DEPARTMENT OF THE INTERIOR
BUREAU OF LAND MANAGEMENT

SECTION


15

Oregon State Water Filings

SE 1/4 NW 1/4

TOWNSHIP 29S, RANGE 17E, W. M.

North

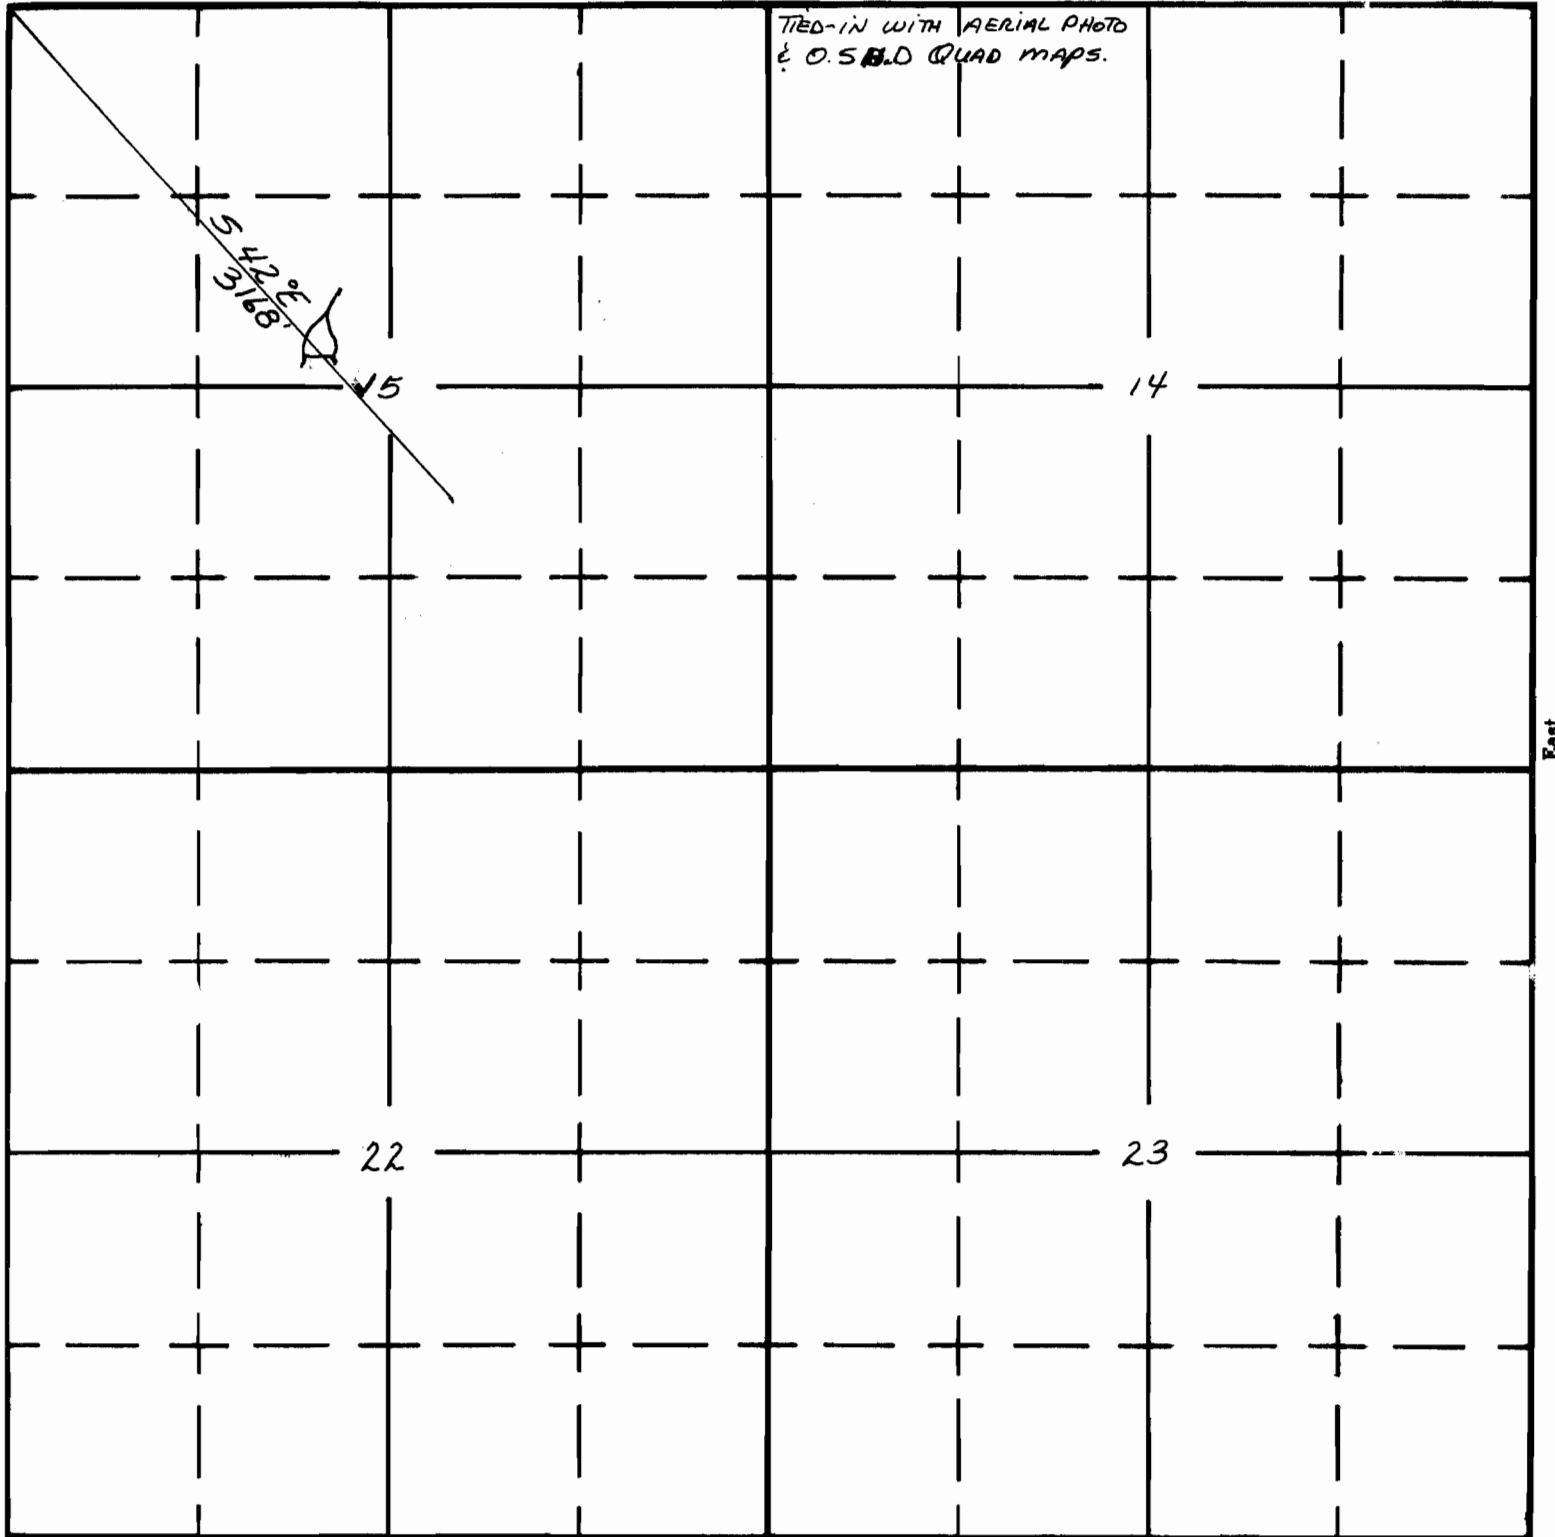

South

APPLICATION No. R-35149
PERMIT No. R-2855