

UNITED STATES
DEPARTMENT OF THE INTERIOR
BUREAU OF LAND MANAGEMENT

SECTION

14

Oregon State Water Filings


TOWNSHIP 27S, RANGE 13 E, W. M.

SW 1/4 SE 1/4

RECEIVED
SEP 8 1961

STATE ENGINEER
ALEX. OREGON

North

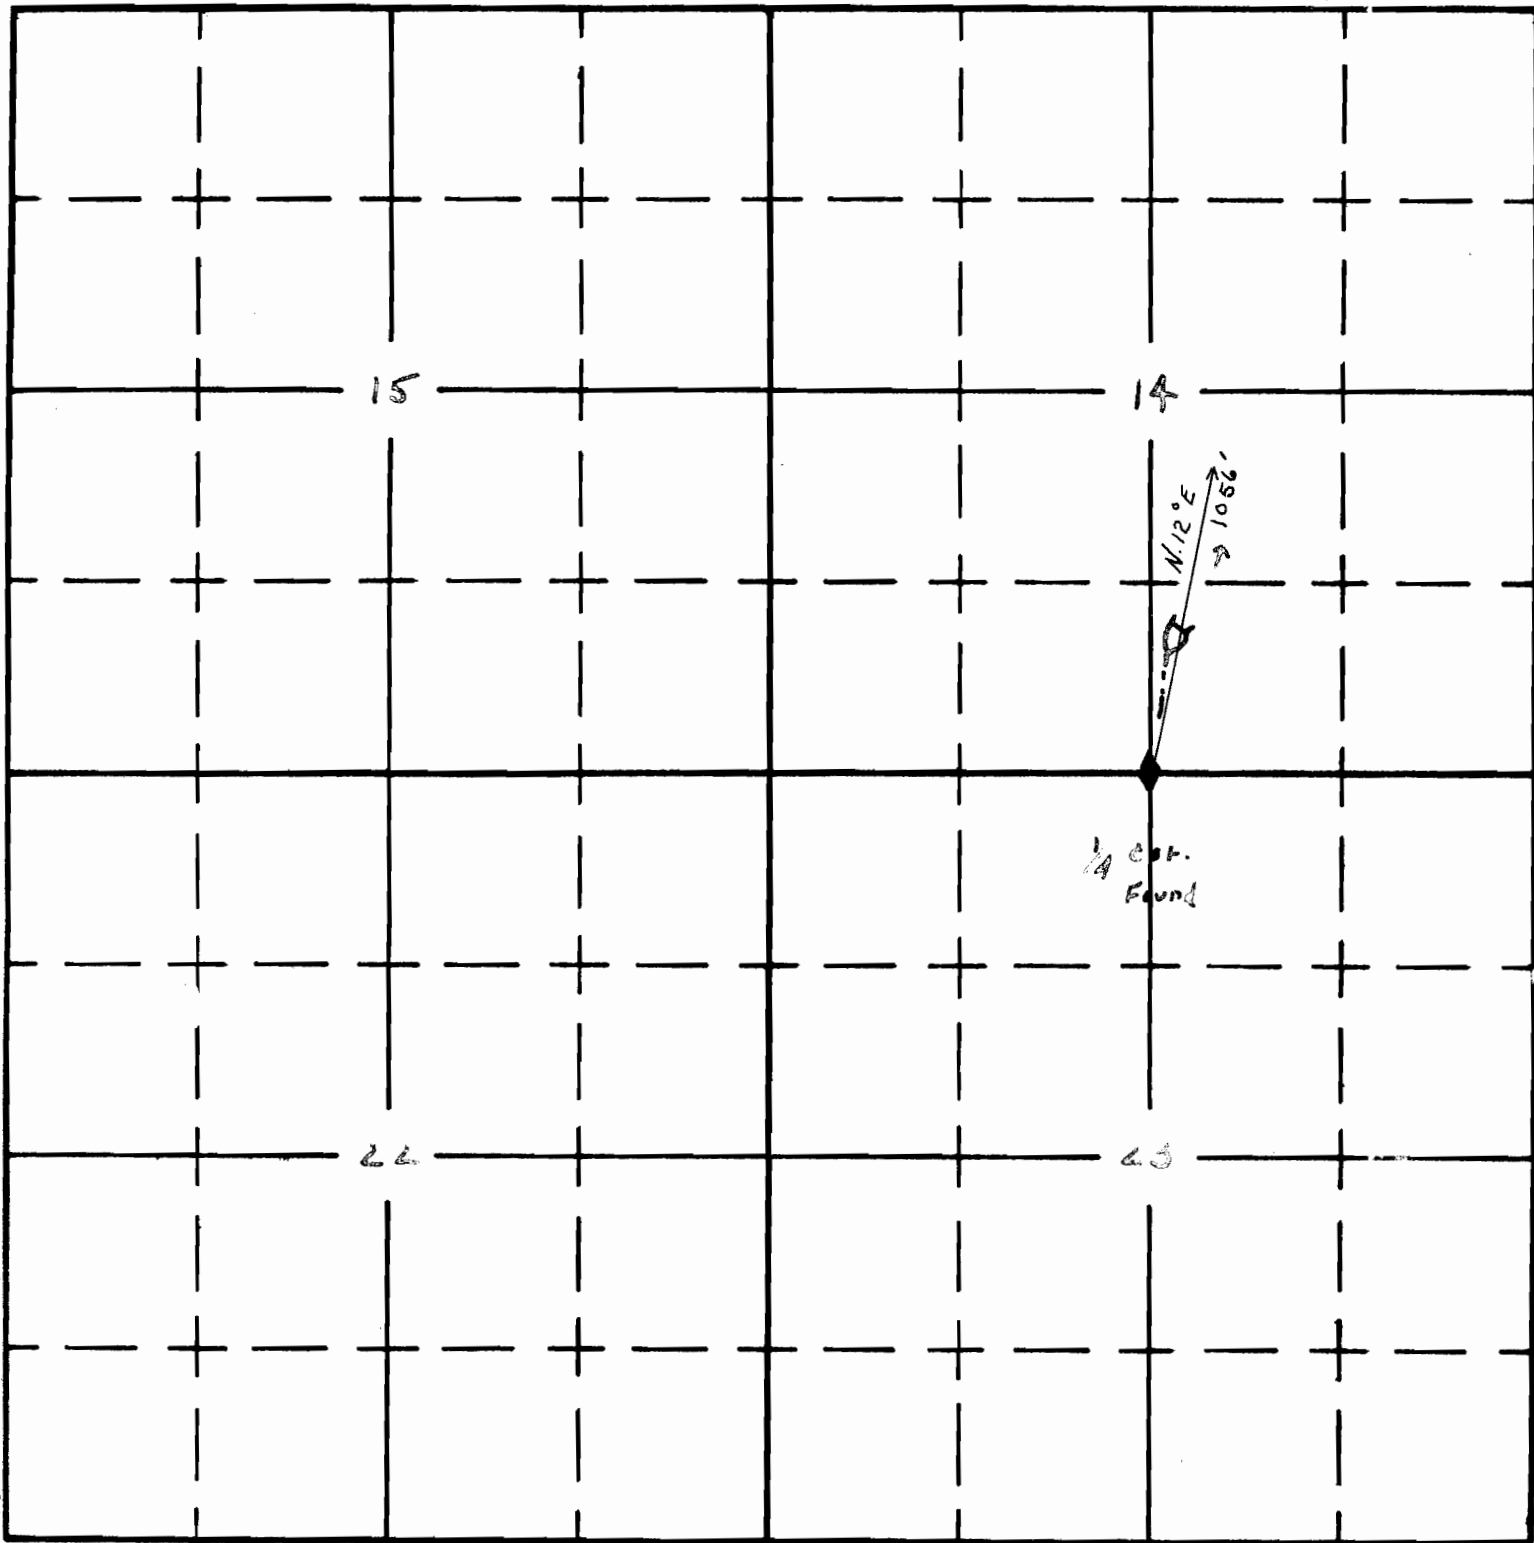

South

APPLICATION No. R-35150

PERMIT No. R-2856