

UNITED STATES
DEPARTMENT OF THE INTERIOR
BUREAU OF LAND MANAGEMENT

SECTION


1

SW $\frac{1}{4}$ SE $\frac{1}{4}$

Oregon State Water Filings

TOWNSHIP 29S, RANGE 16E, W. M.

North

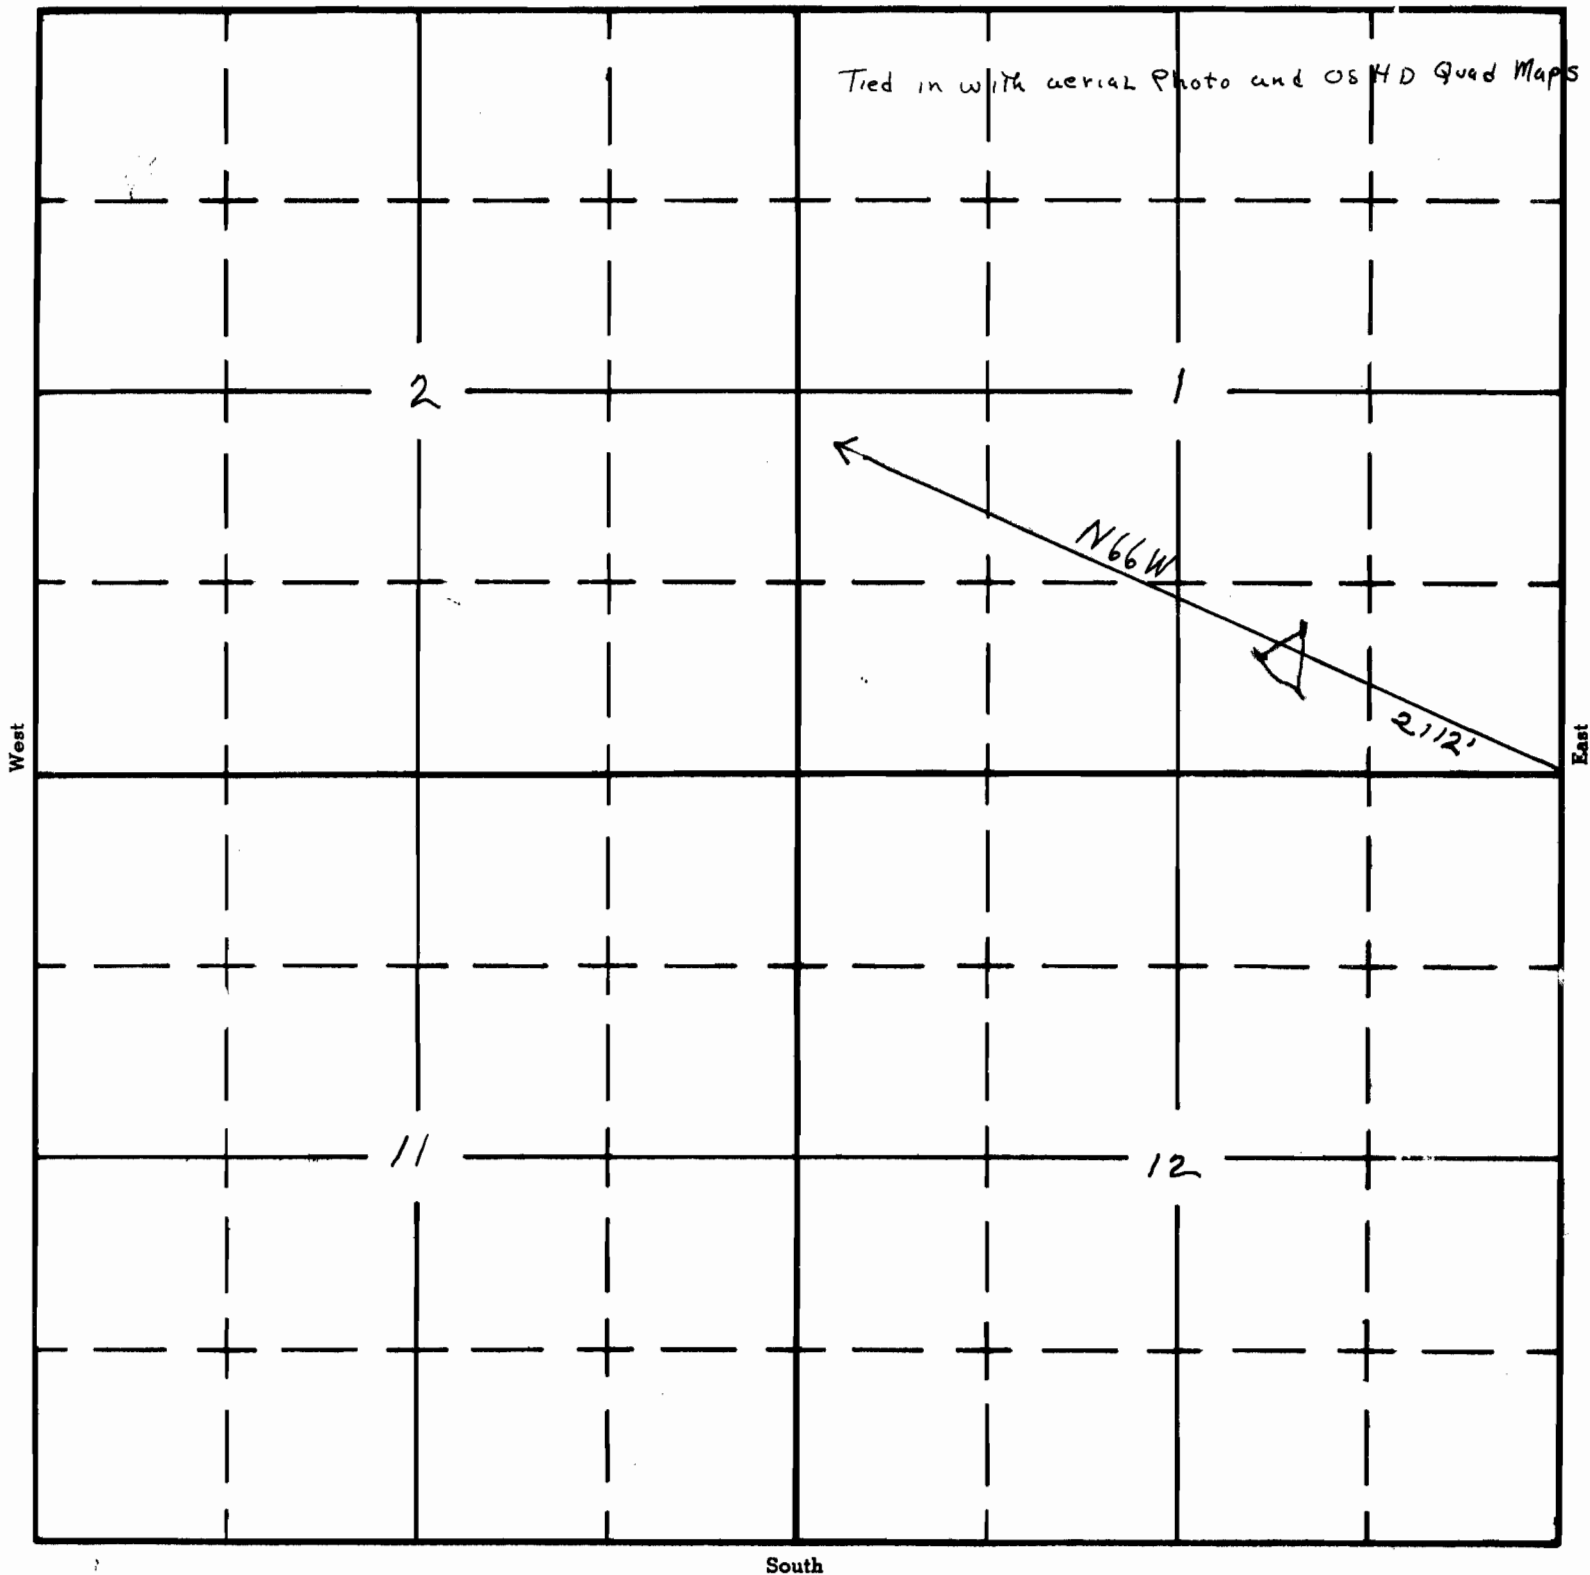

APPLICATION No. R-35158

PERMIT No. R-2861