

Form AI-187
March 1961

UNITED STATES
DEPARTMENT OF THE INTERIOR
BUREAU OF LAND MANAGEMENT


SECTION

NW SE Sec. 3

Oregon State Water Filings

TOWNSHIP 39S, RANGE 26E, W. M.

North

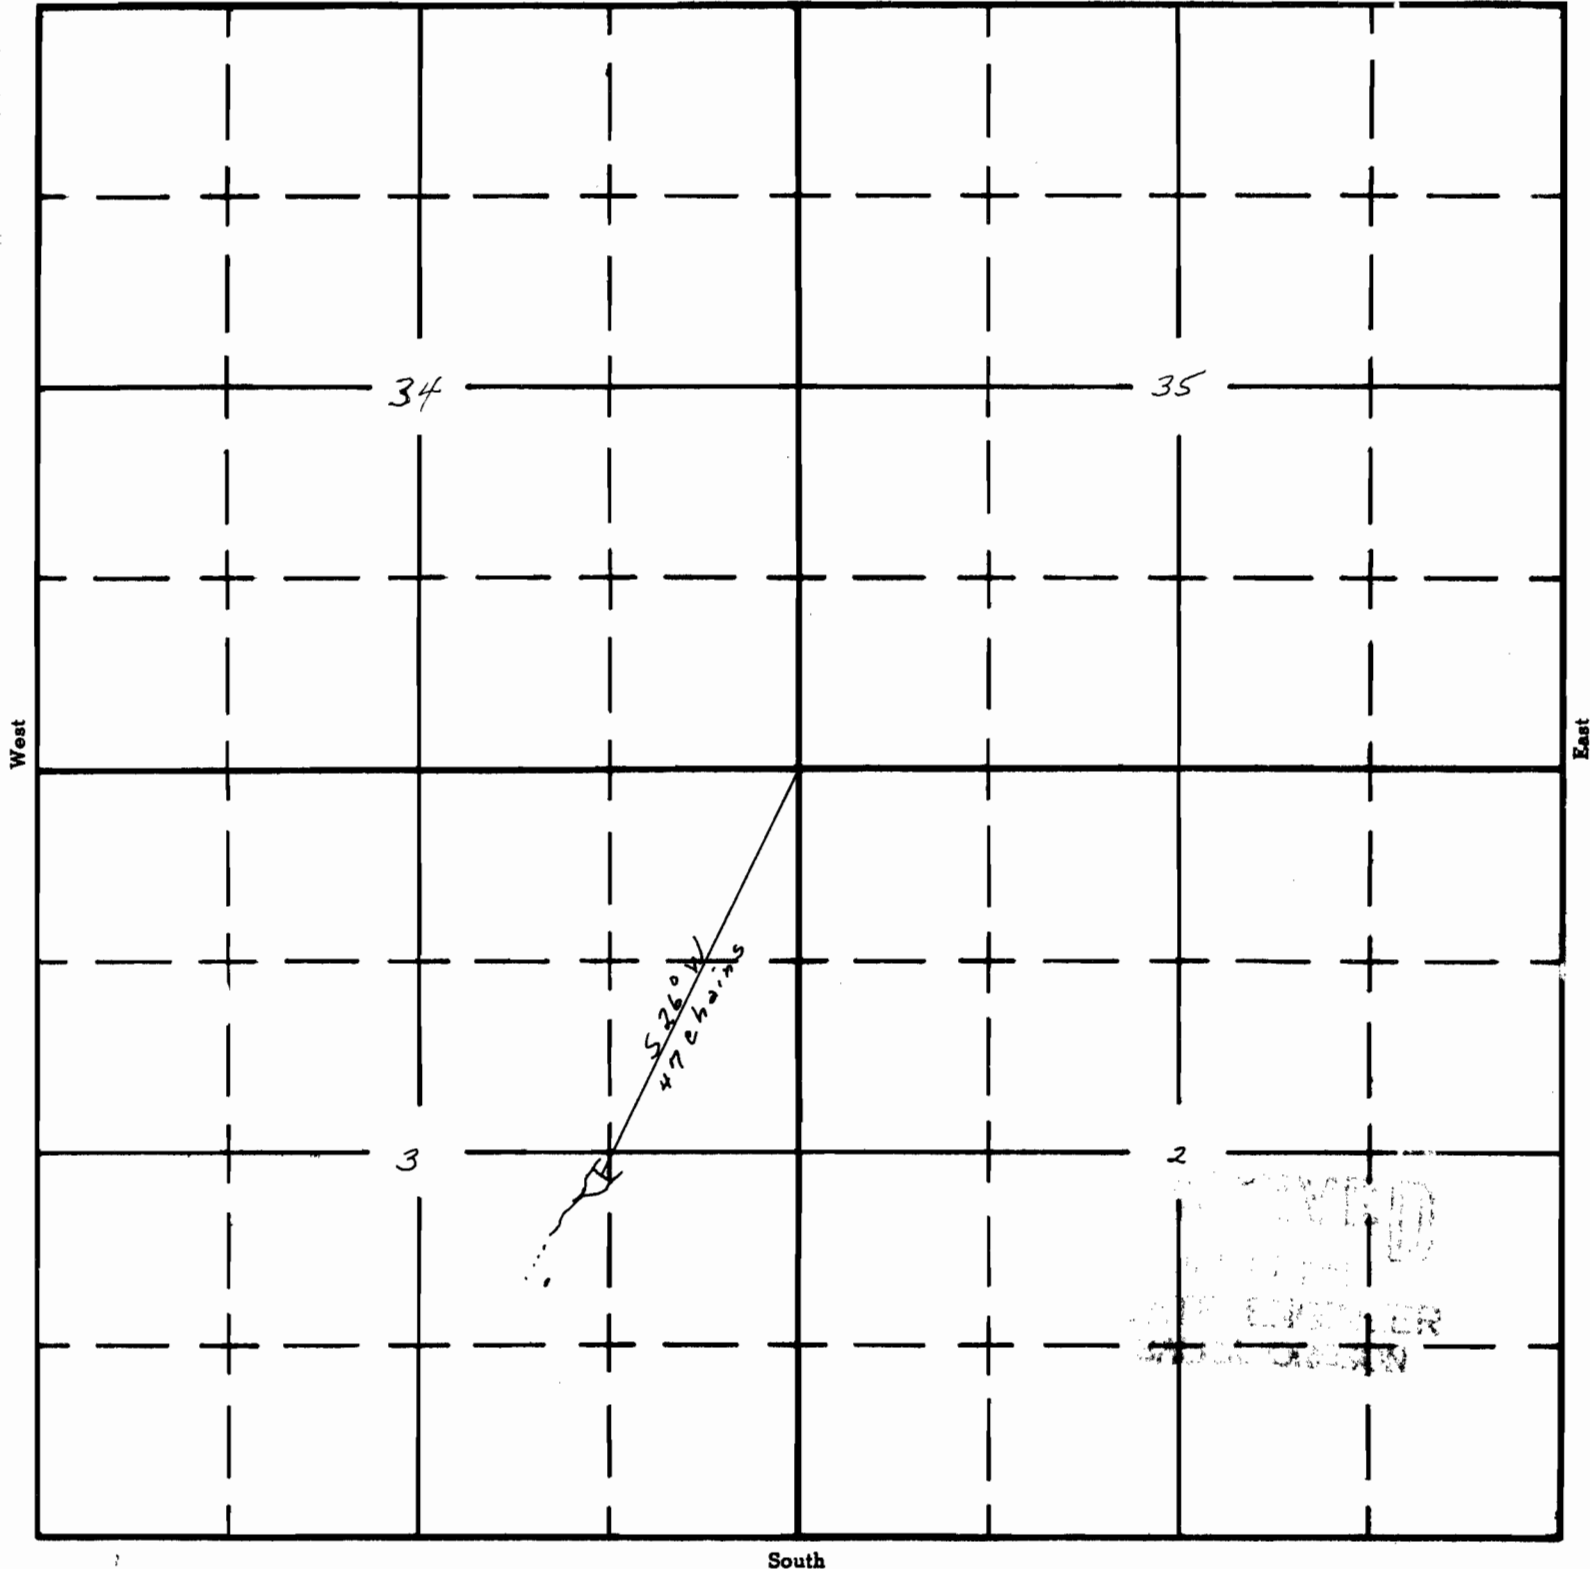

APPLICATION No. R-35161
PERMIT No. R-2963