

Form AI-187  
March 1961

UNITED STATES  
DEPARTMENT OF THE INTERIOR  
BUREAU OF LAND MANAGEMENT

SECTION


15


NE 1/4 SW 1/4

TOWNSHIP 27S, RANGE 13E, W. M.

North

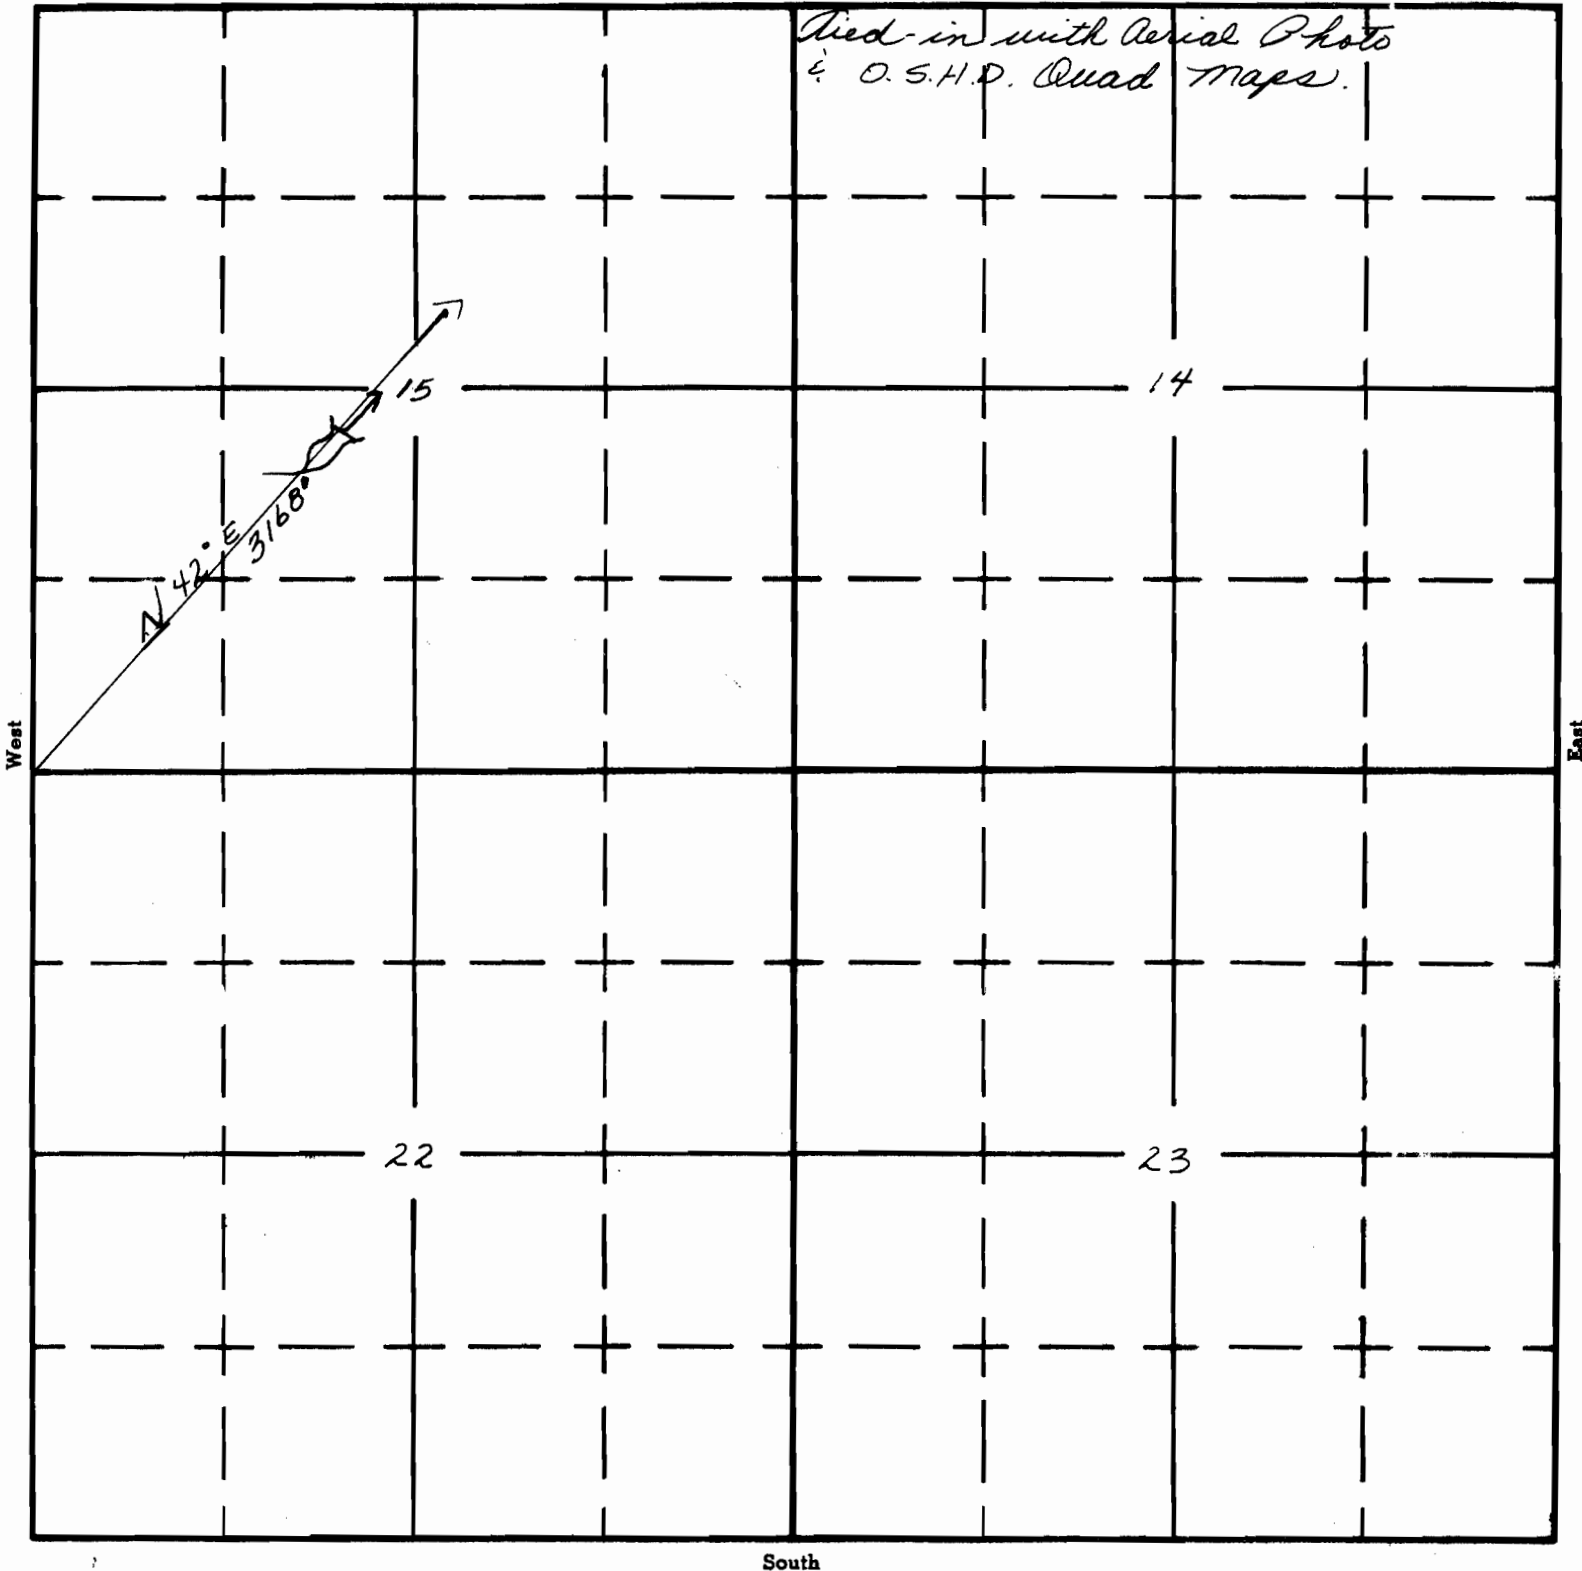

APPLICATION No. R-35234

PERMIT No. R-3002