

Form AI-187
March 1961

UNITED STATES
DEPARTMENT OF THE INTERIOR
BUREAU OF LAND MANAGEMENT

SECTION


29

Oregon State Water Filings

SE 1/4 NW 1/4

TOWNSHIP 30 S, RANGE 21 E, W. M.

North

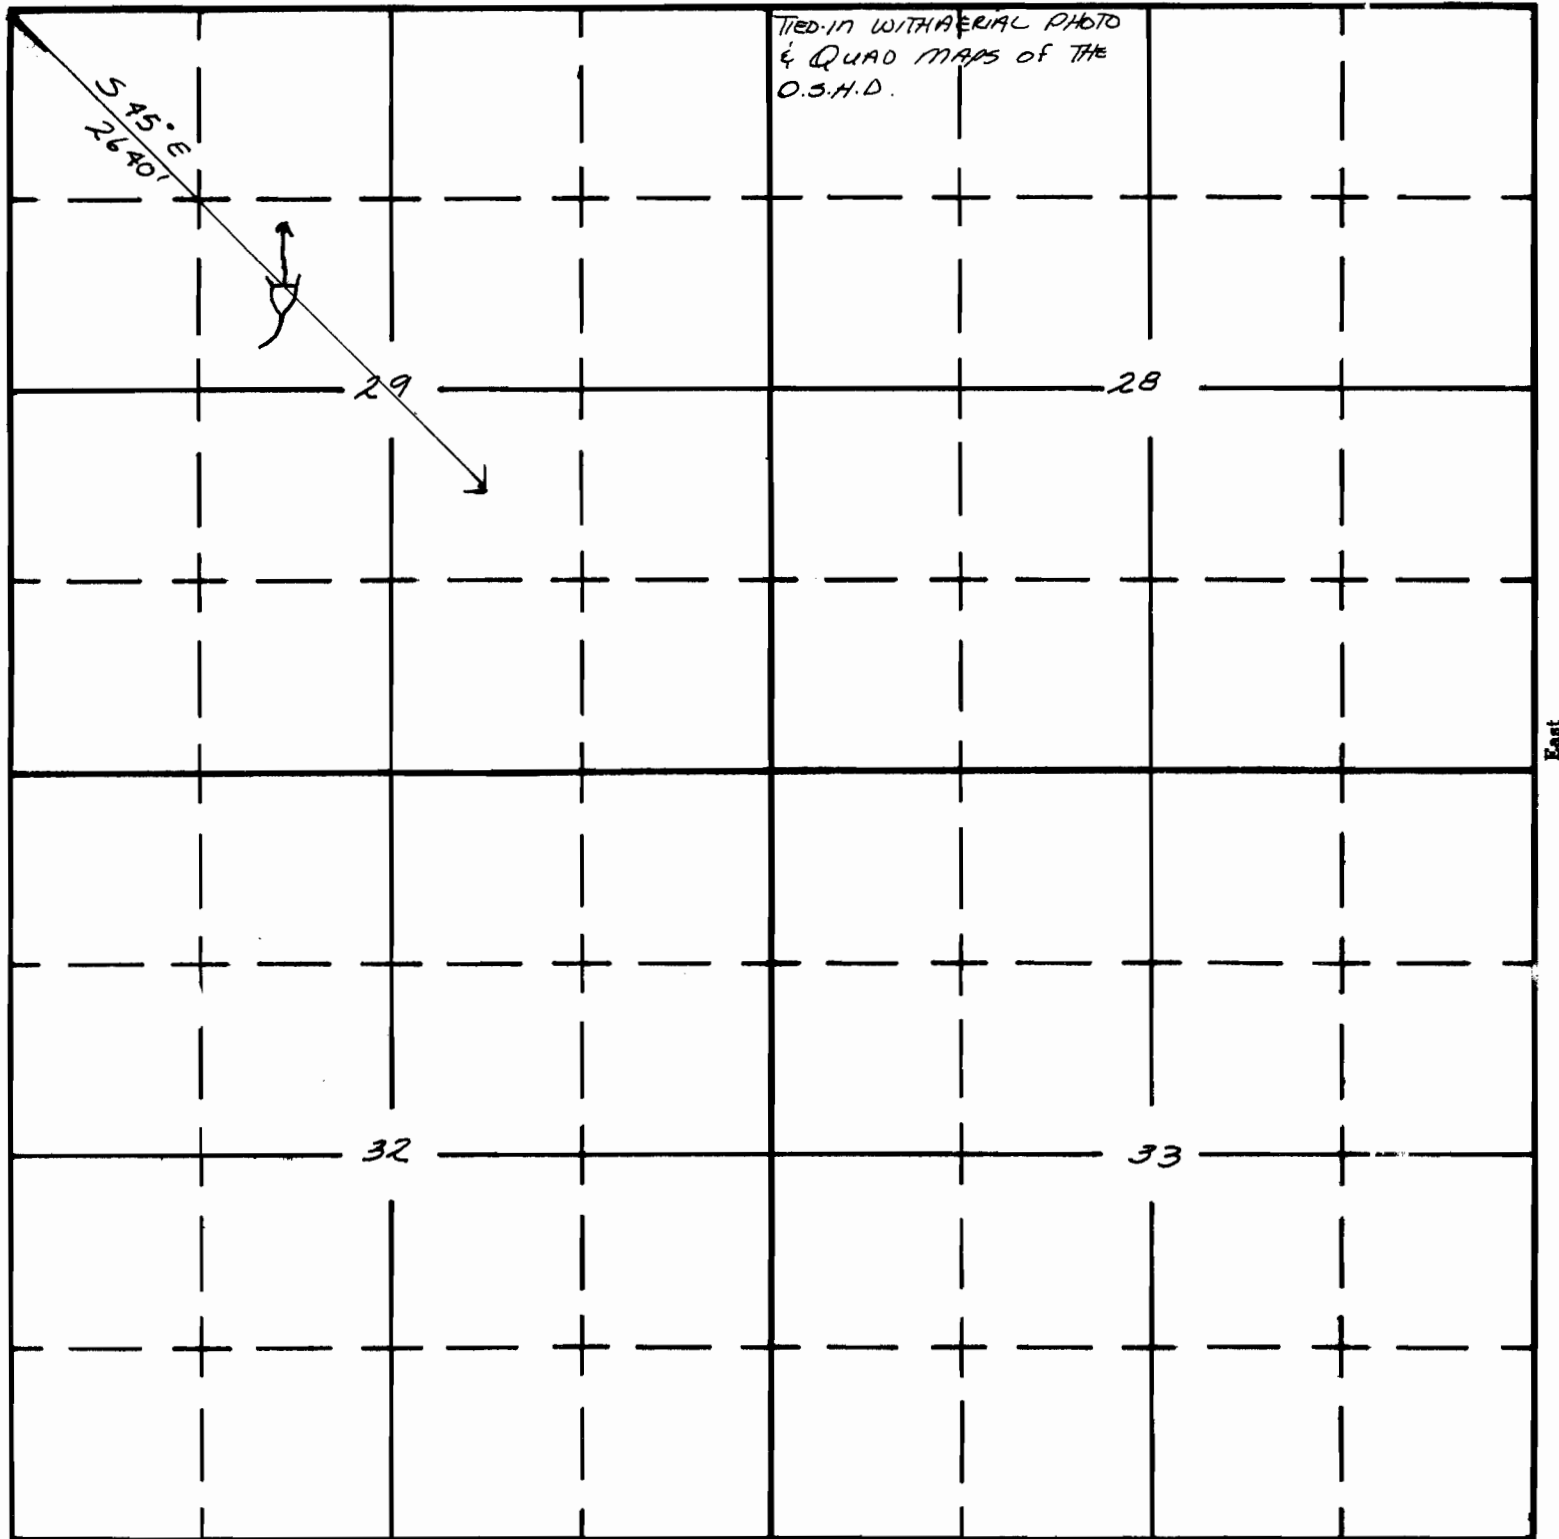

South

APPLICATION No. R-35236
PERMIT No. R-3003