

UNITED STATES
DEPARTMENT OF THE INTERIOR
BUREAU OF LAND MANAGEMENT

SECTION


22

NE $\frac{1}{4}$ NE $\frac{1}{4}$

Oregon State Water Filings

TOWNSHIP 31S, RANGE 21E, W. M.

North

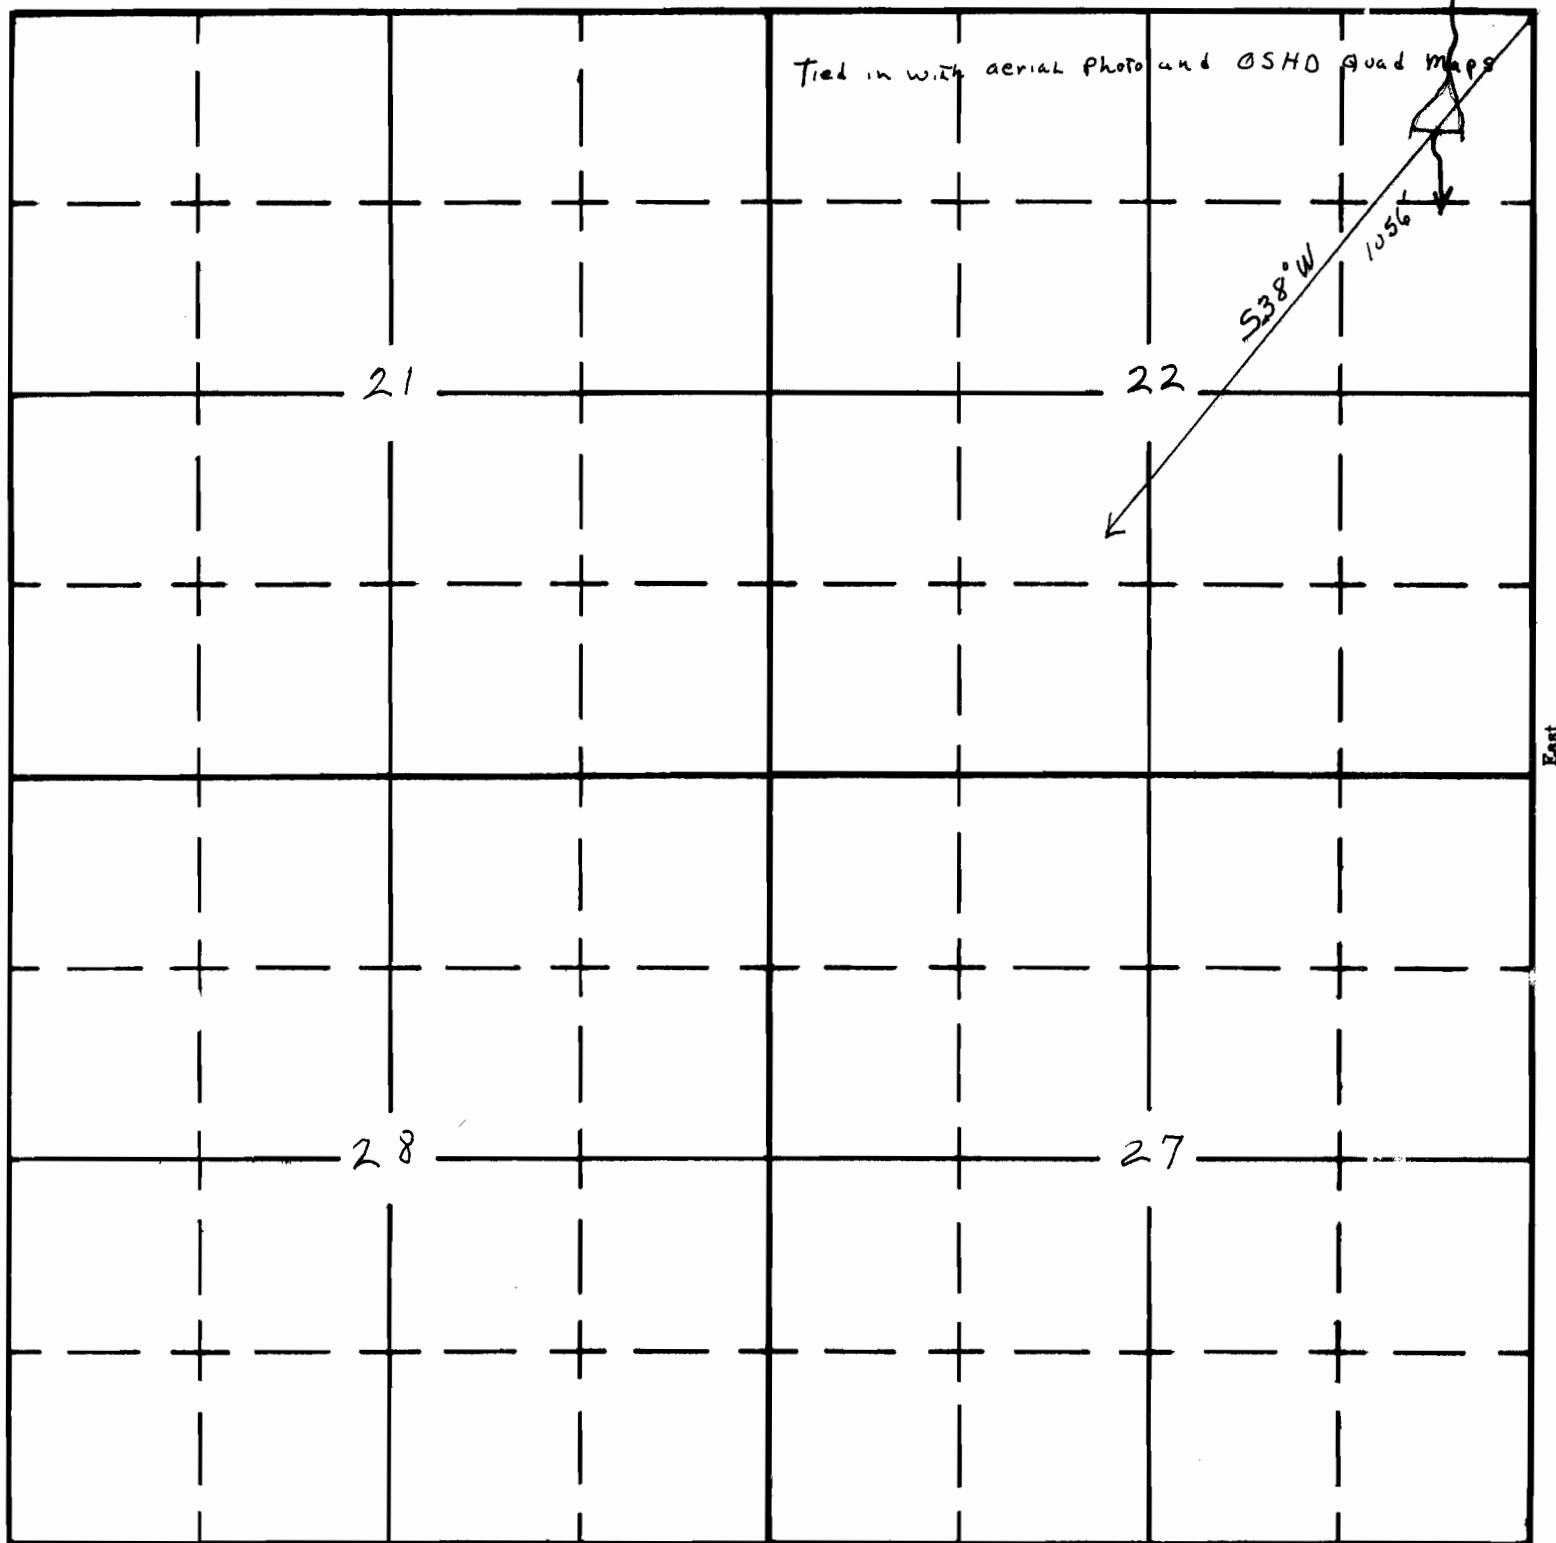

South

APPLICATION No. R-35244
PERMIT No. R-3010