

UNITED STATES
DEPARTMENT OF THE INTERIOR
BUREAU OF LAND MANAGEMENT

SECTION


19

Oregon State Water Filings

NW¹/₄ SW¹/₄

TOWNSHIP 29 S, RANGE 20 E, W. M.

North

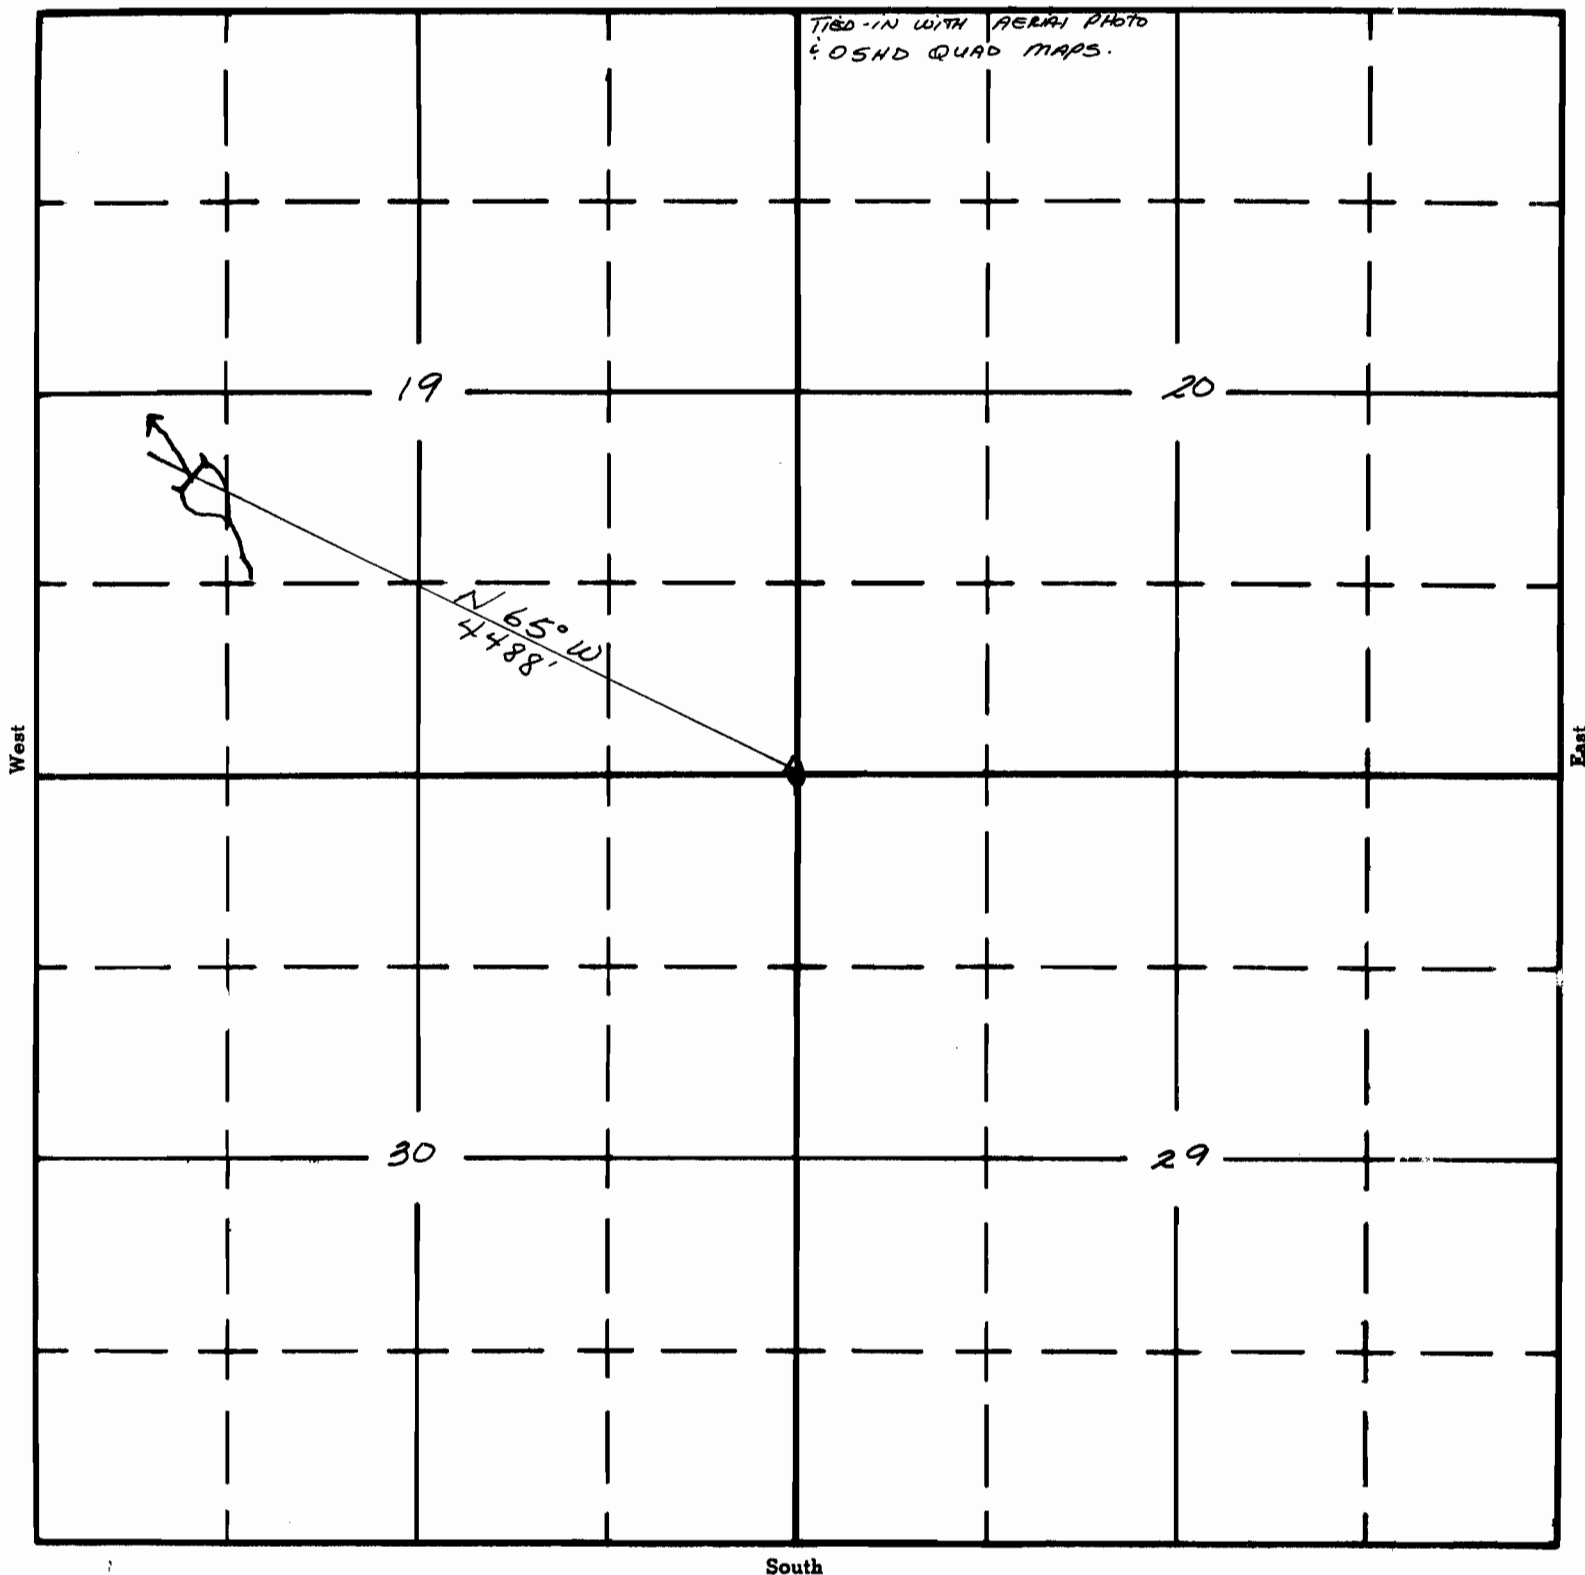

APPLICATION No. R-35247
PERMIT No. R-3013