

UNITED STATES
DEPARTMENT OF THE INTERIOR
BUREAU OF LAND MANAGEMENT

SECTION

6


Oregon State Water Filings

SE 1/4 NE 1/4

TOWNSHIP 30 S, RANGE 20 E, W. M.

RECEIVED
SEP 8 1961
STATE ENGINEER
OREGON

North

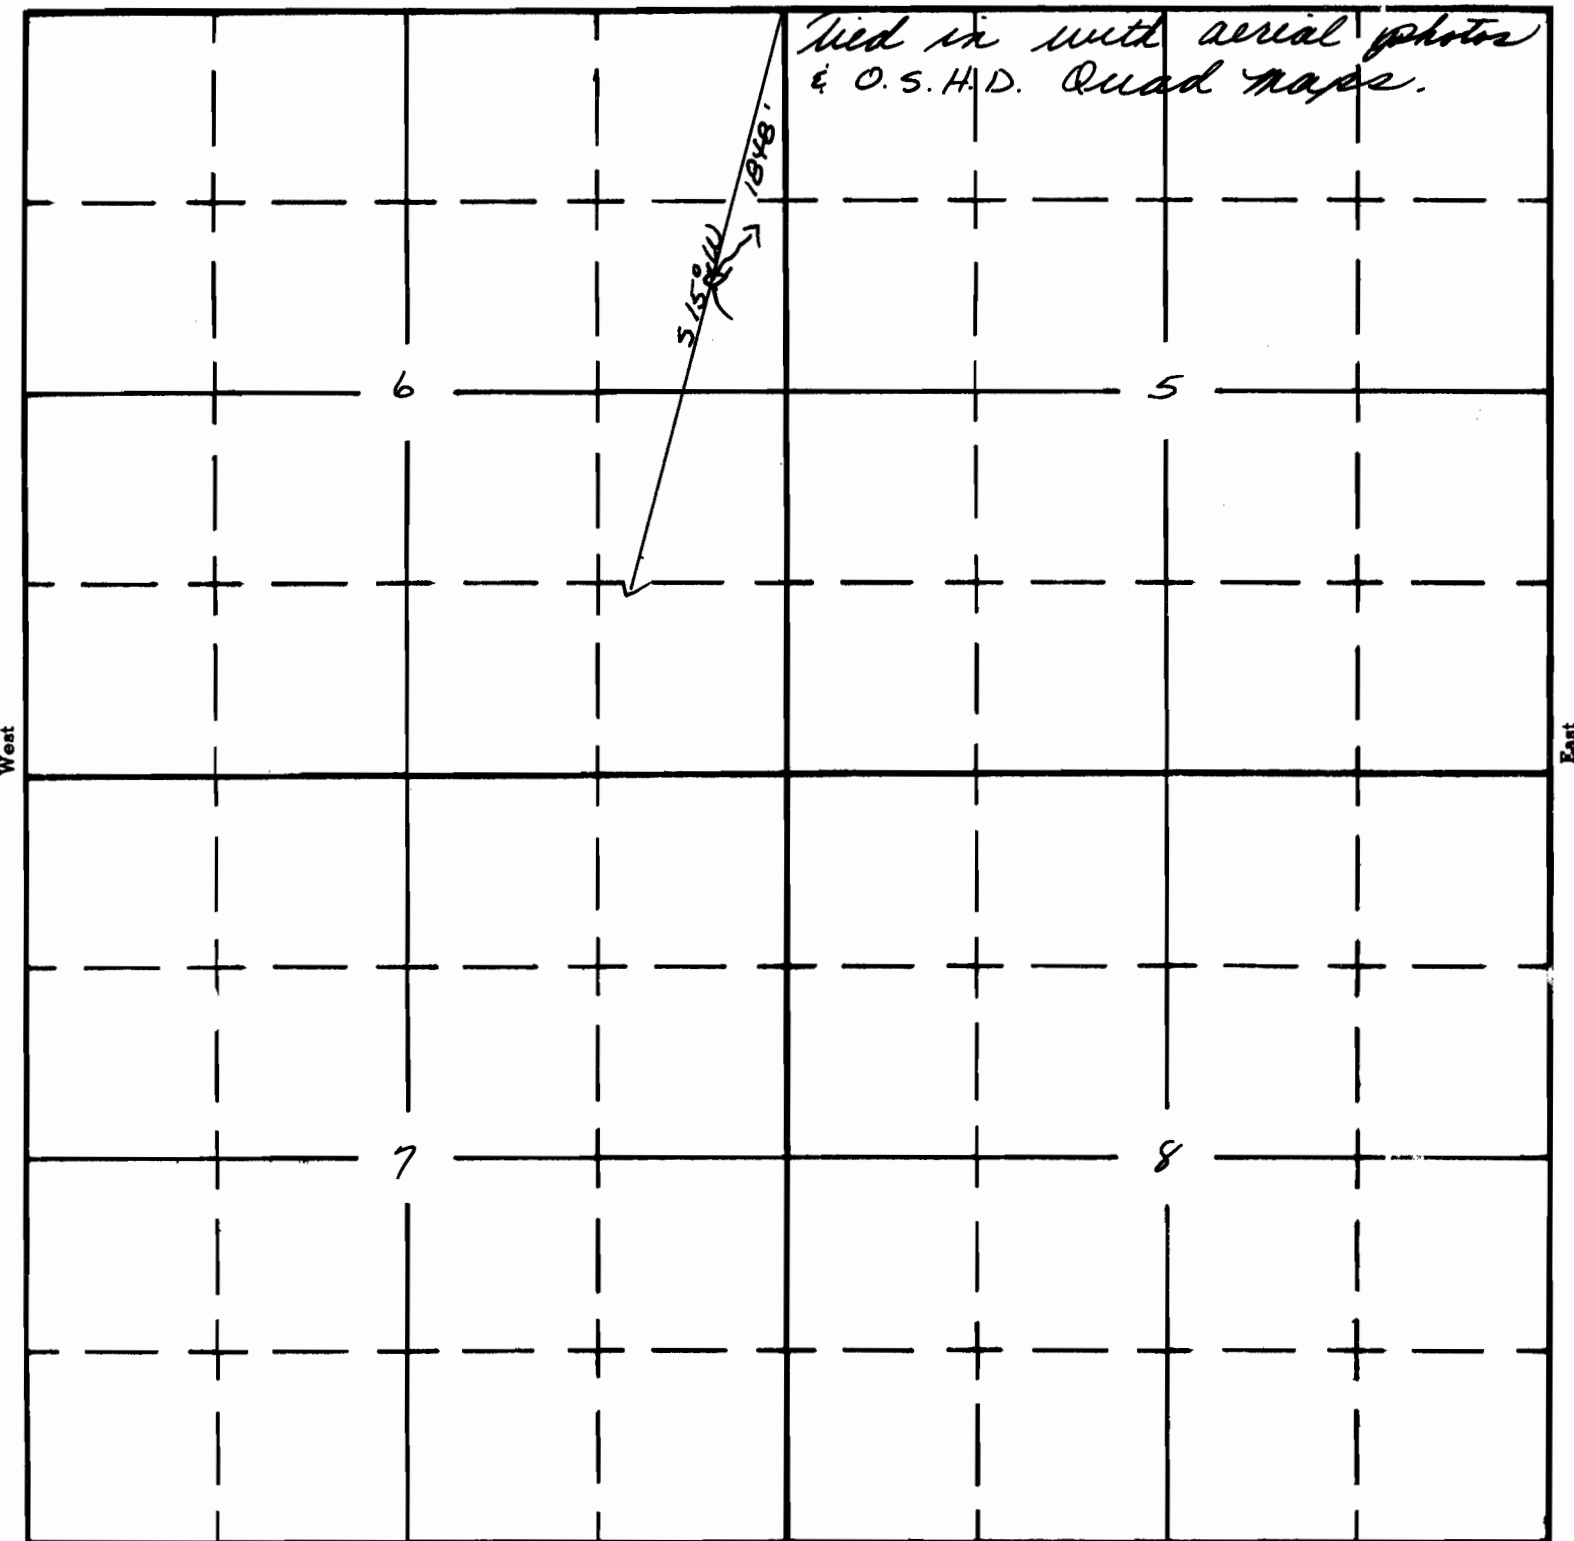

South

APPLICATION No. R-35248
PERMIT No. R-3014