

UNITED STATES
DEPARTMENT OF THE INTERIOR
BUREAU OF LAND MANAGEMENT


SECTION
27

Oregon State Water Filings

SW 1/4 SW 1/4 TOWNSHIP 28 S, RANGE 18 E, W. M.

TIED-IN WITH AERIAL PHOTOS &
OSHD QUAD MAPS

North

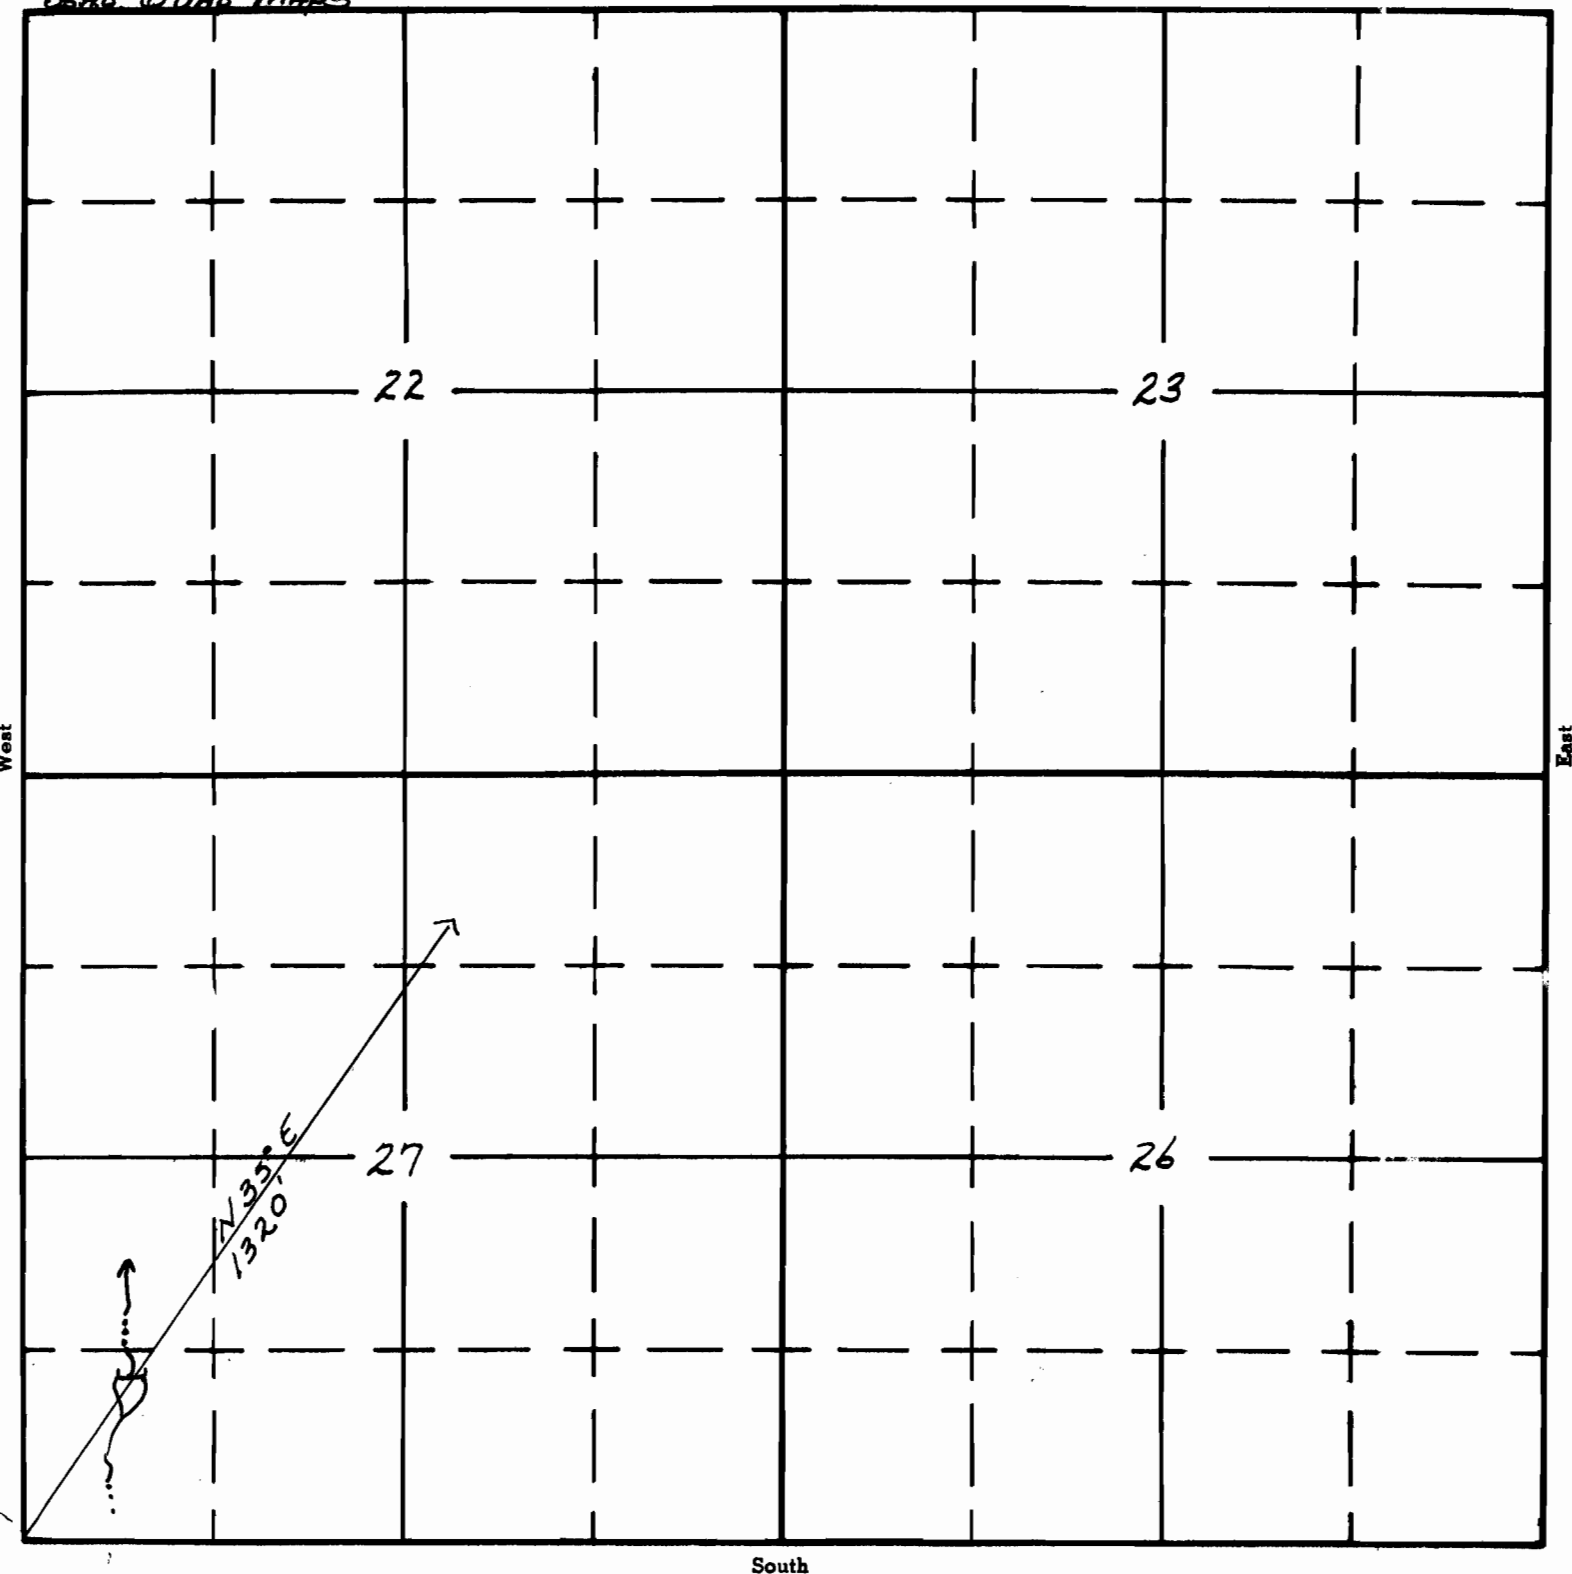

South

APPLICATION No. B-35264
PERMIT No. A-3027