

Form AI-187
March 1961

UNITED STATES
DEPARTMENT OF THE INTERIOR
BUREAU OF LAND MANAGEMENT

SECTION

18


Oregon State Water Filings

SEP 8 1961
STATE ENGINEER

NE 1/4 NE 1/4

TOWNSHIP 4^N, RANGE 1^E, W. M.

North

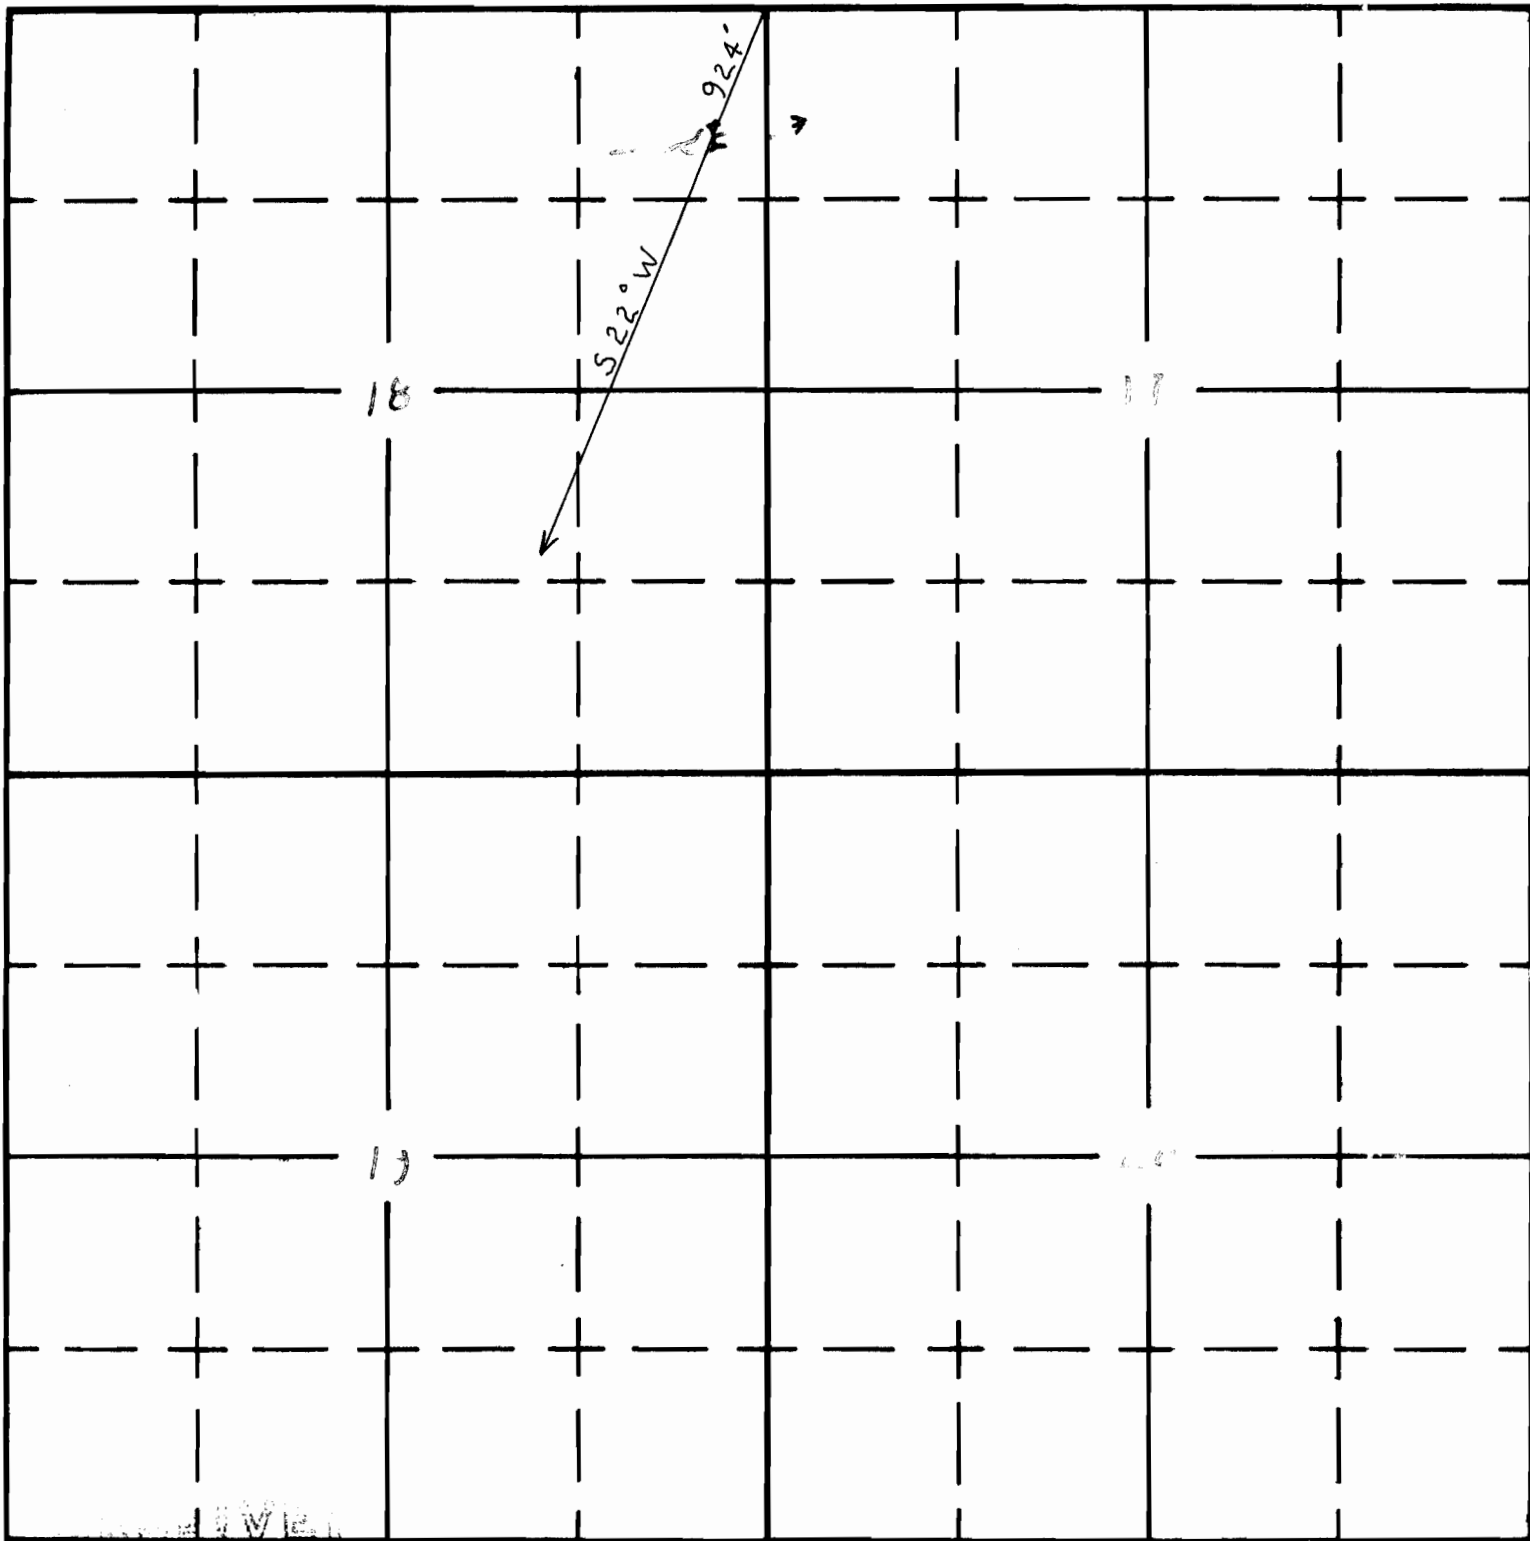

SEP 8 1961
STATE ENGINEER

South

APPLICATION No. R-35281
PERMIT No. R-3039