

Form A1-187
March 1961

UNITED STATES
DEPARTMENT OF THE INTERIOR
BUREAU OF LAND MANAGEMENT

SECTION

3


Oregon State Water Filings

NE 1/4 SE 1/4

TOWNSHIP 24S, RANGE 10E, W. M.

SEP 8 1961
STATE ENGINEER

North

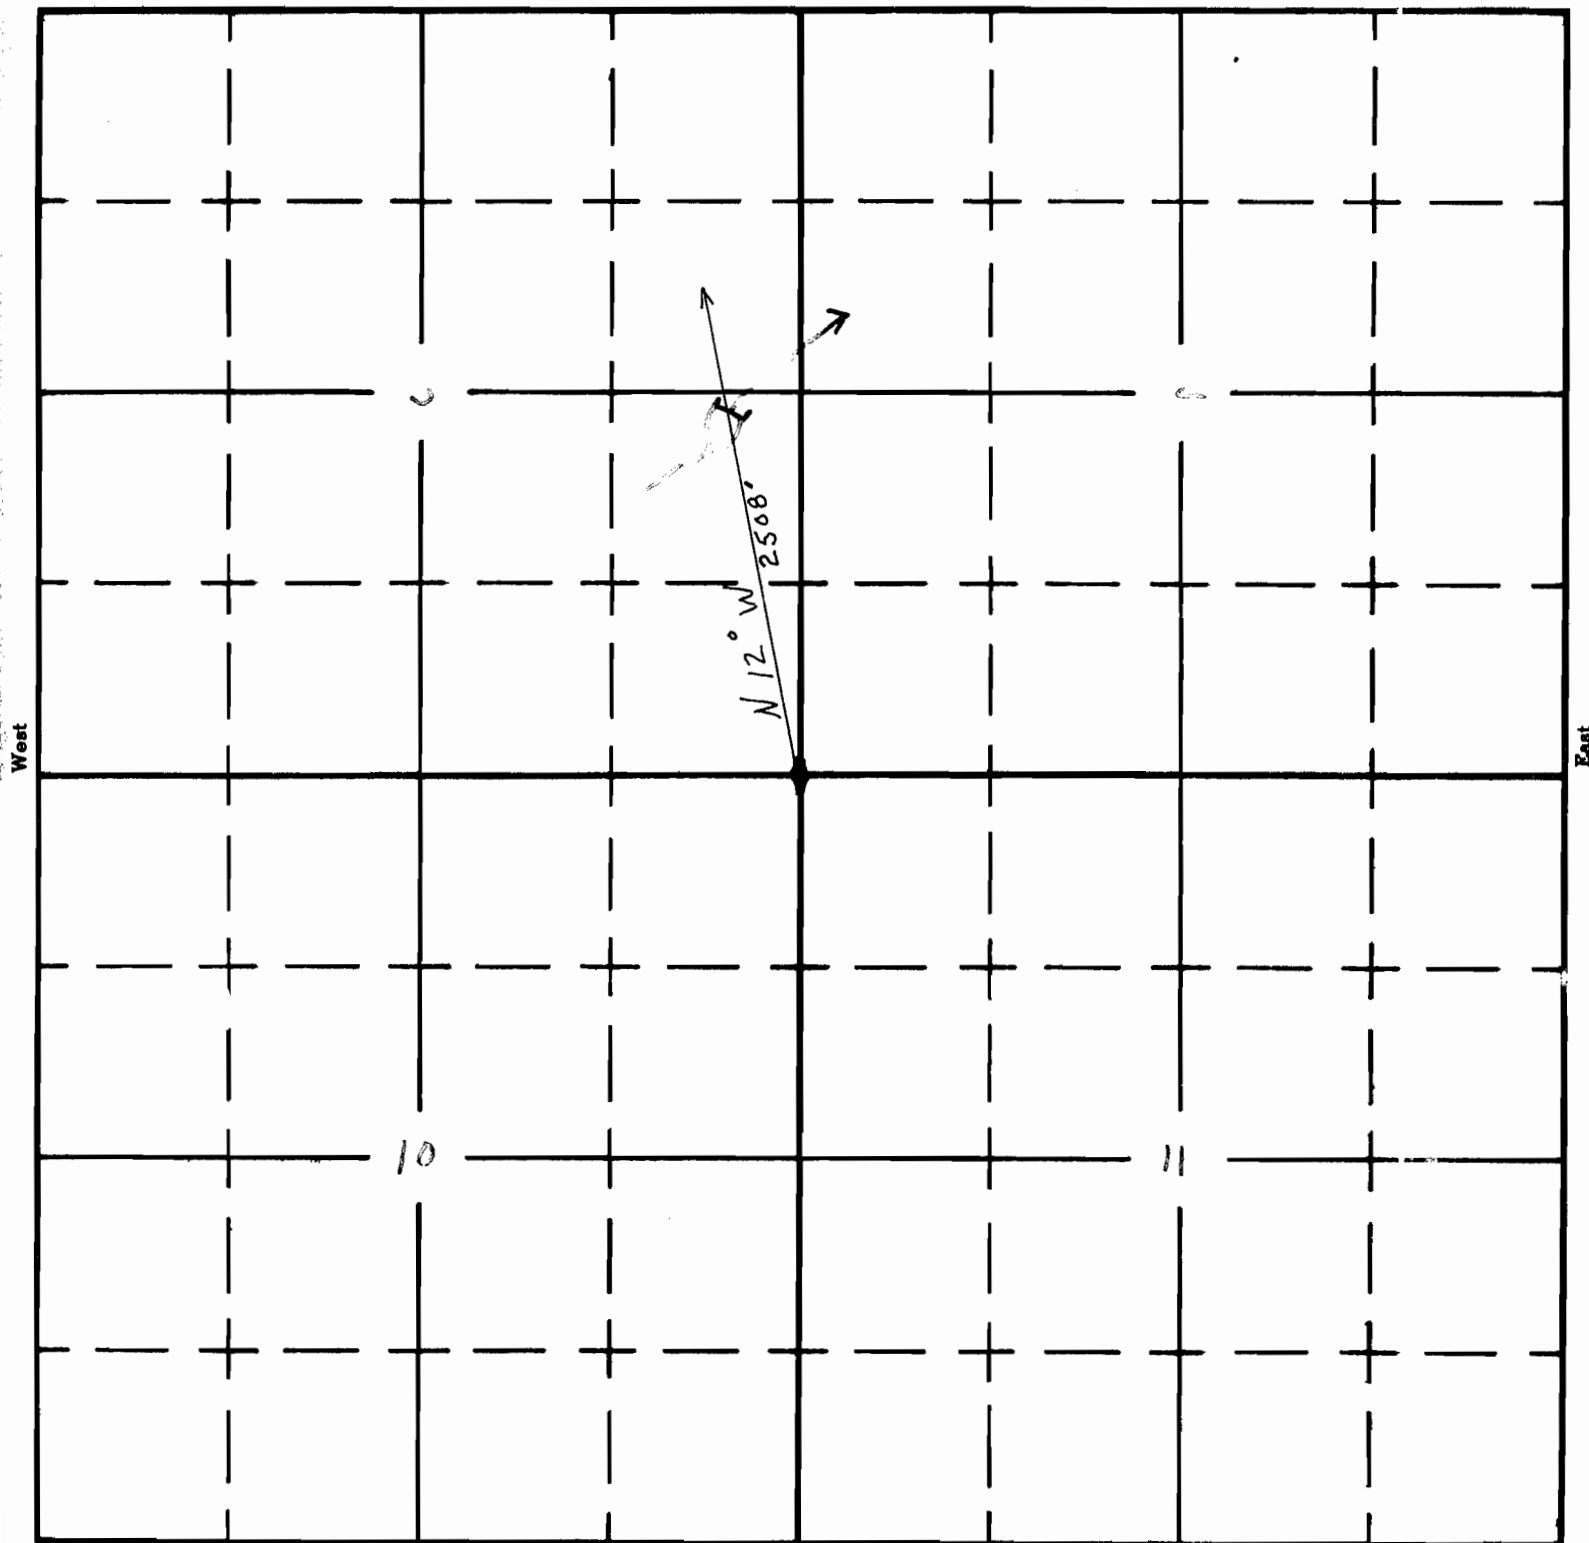

South

APPLICATION No. R-35296
PERMIT No. A-3051