

Form A1-187
March 1961

UNITED STATES
DEPARTMENT OF THE INTERIOR
BUREAU OF LAND MANAGEMENT

SECTION

1


Oregon State Water Filings

11'4" - 11'4"

TOWNSHIP 4 S, RANGE 10 E, W. M.

W1210
SEP 8 1961
STATE ENGINEER

North

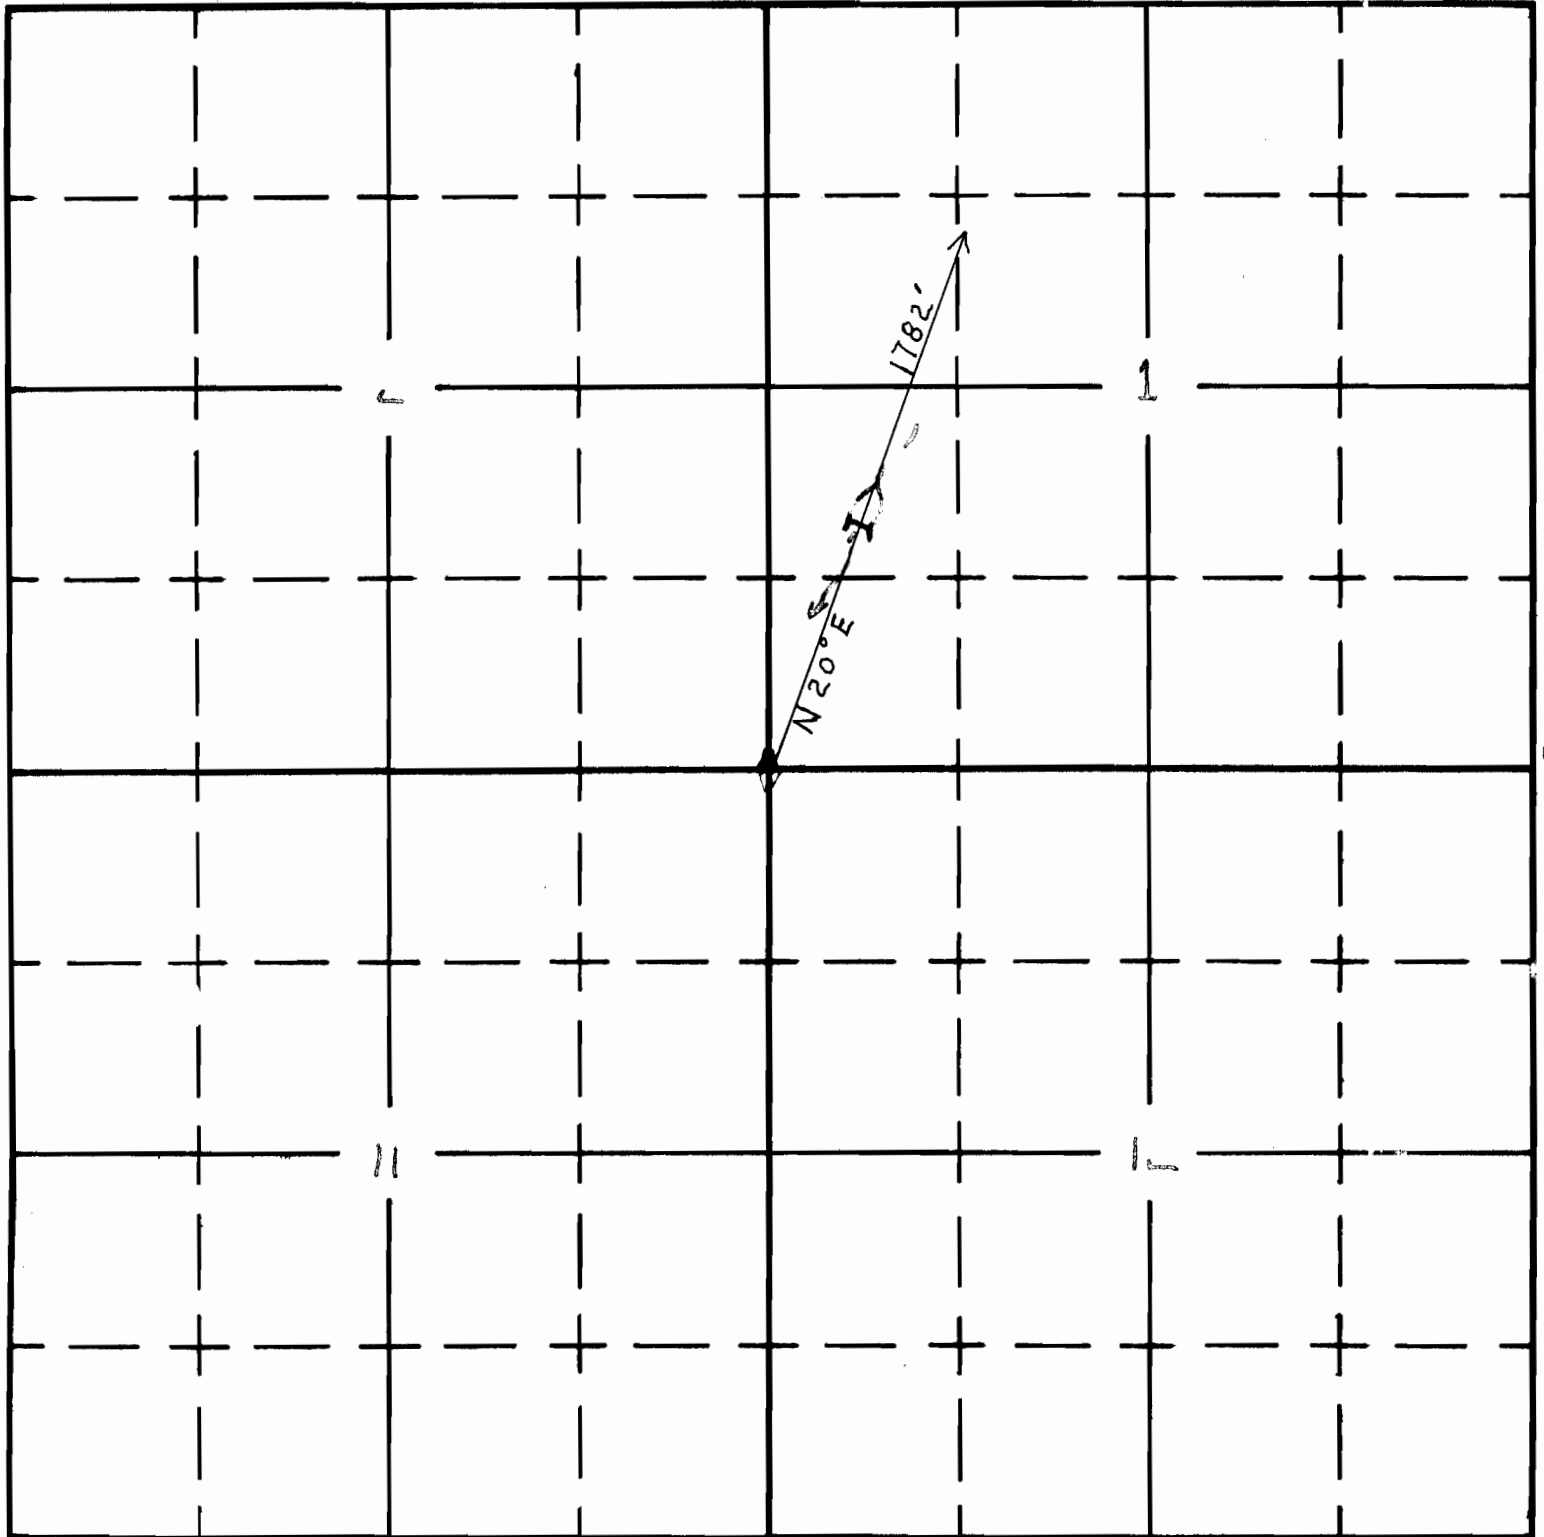

South

APPLICATION No. R-35297

PERMIT No. R-3052