

Form AI-187
March 1961

UNITED STATES
DEPARTMENT OF THE INTERIOR
BUREAU OF LAND MANAGEMENT

SECTION


SE 1/4 SW 1/4

Oregon State Water Filings

19

TOWNSHIP 22 S, RANGE 32 E, W. M.

North

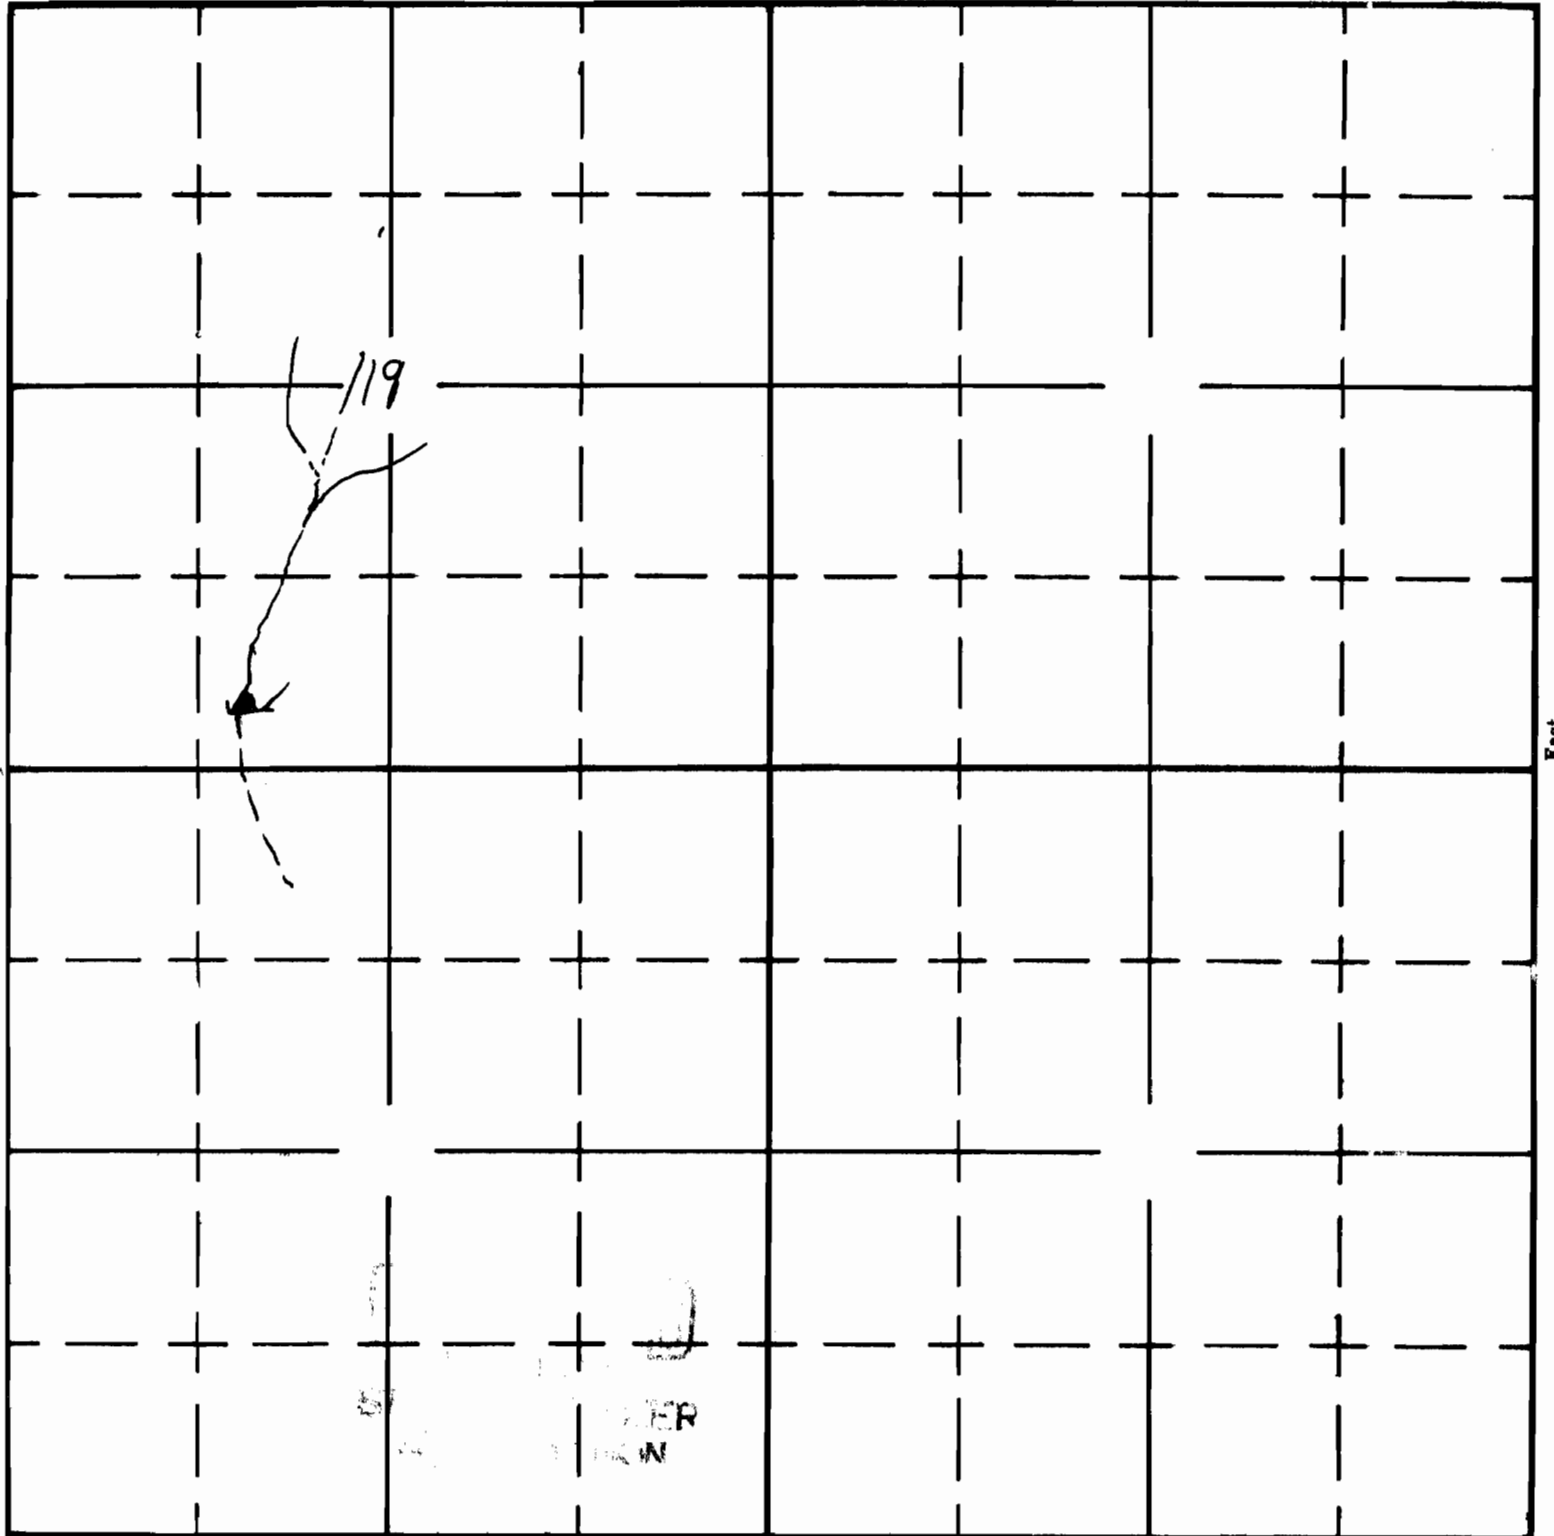

APPLICATION No. R-35329
PERMIT No. R-3095