


Form AI-187
March 1961

UNITED STATES
DEPARTMENT OF THE INTERIOR
BUREAU OF LAND MANAGEMENT

SECTION 2
NE 1/4 SE 1/4

Oregon State Water Filings

TOWNSHIP 29S, RANGE 17E, W. M.

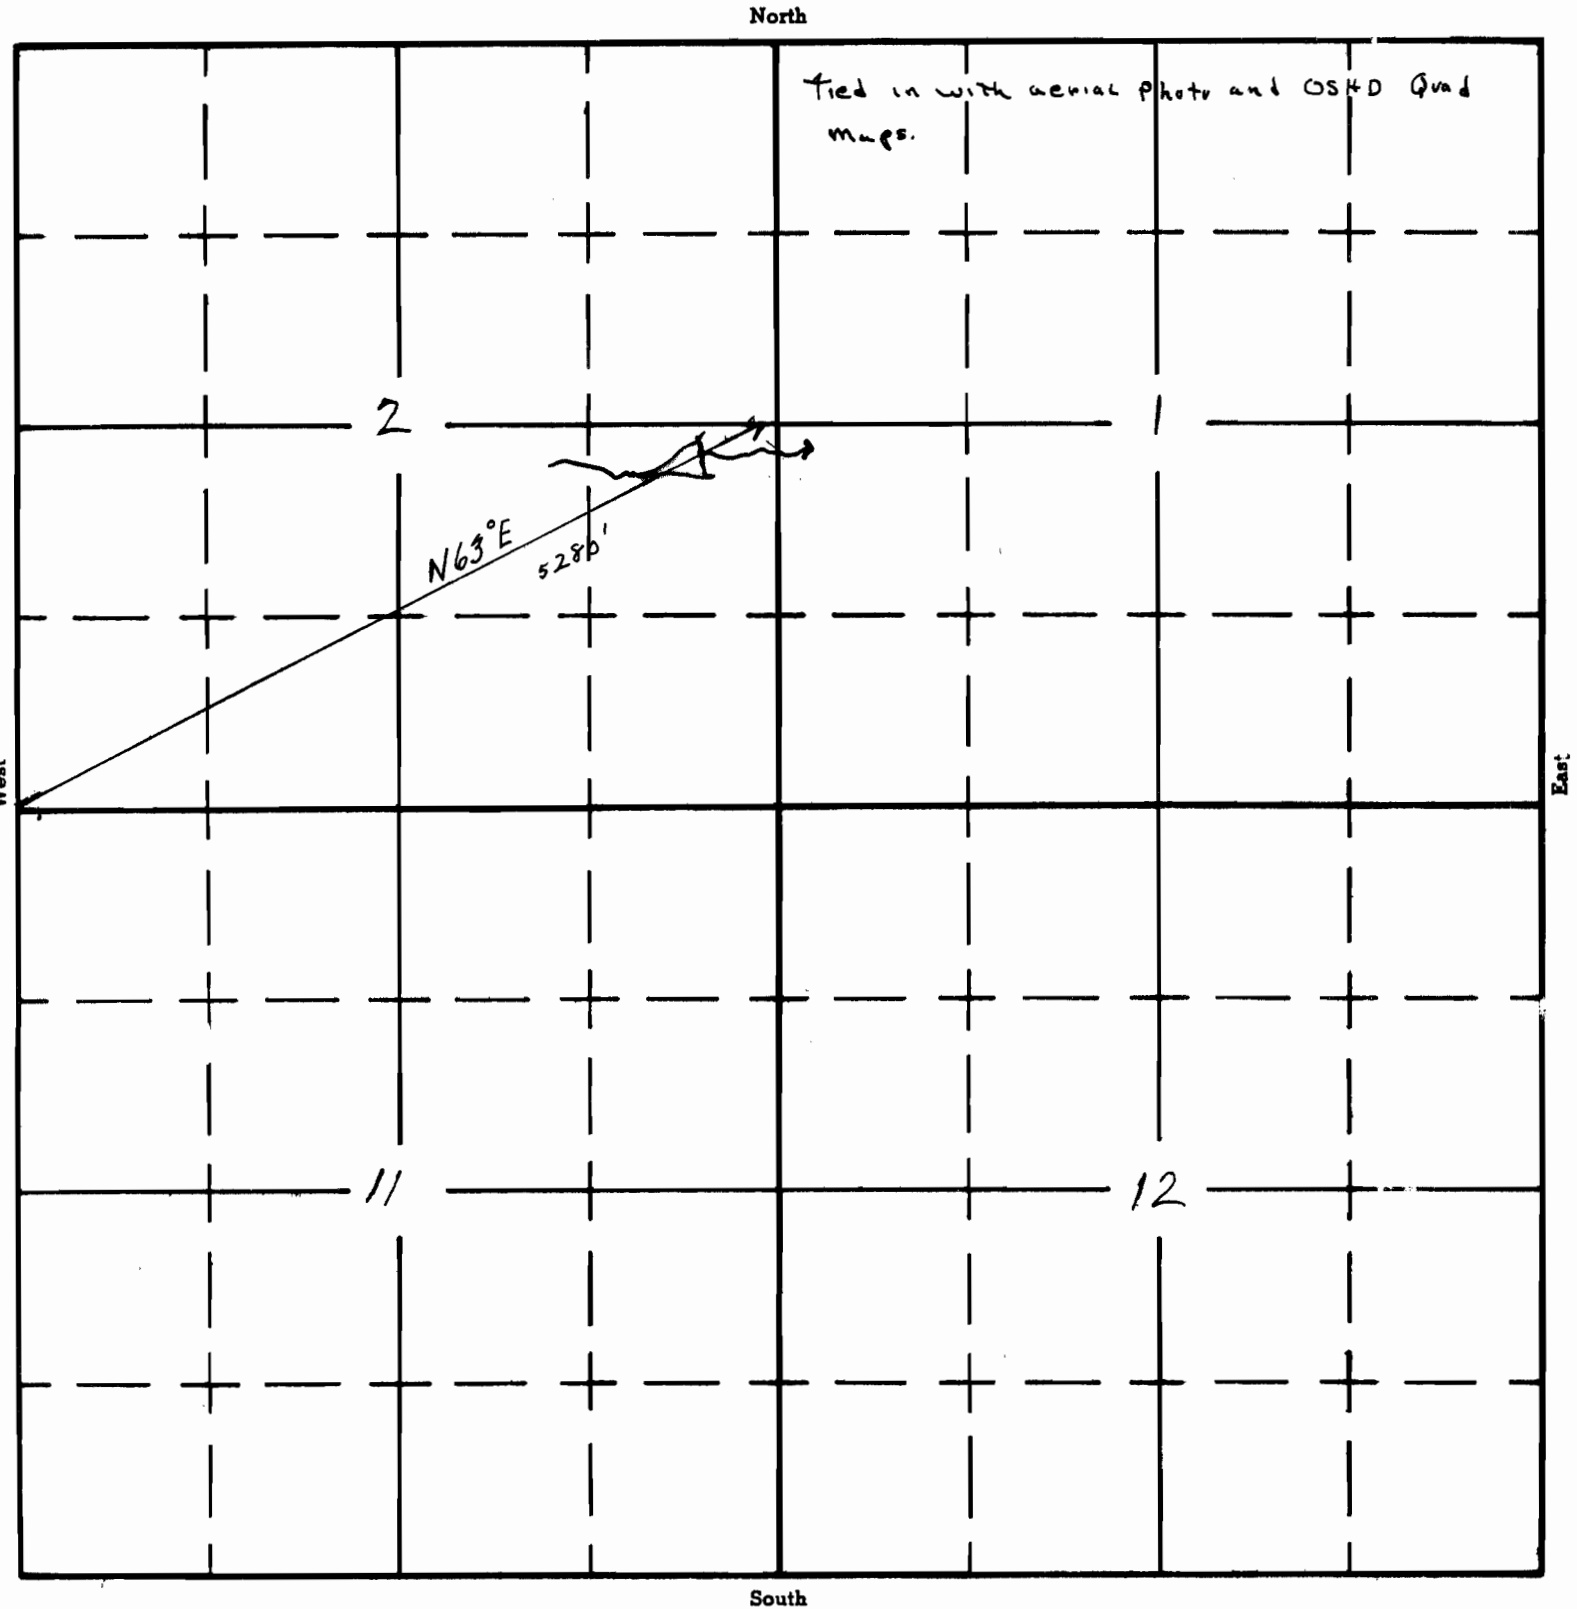

APPLICATION No. A-35262

PERMIT No. A-3128