

UNITED STATES
DEPARTMENT OF THE INTERIOR
BUREAU OF LAND MANAGEMENT


SECTION

Oregon State Water Filings

TOWNSHIP 30-S, RANGE 25-E, W. M.

7

North

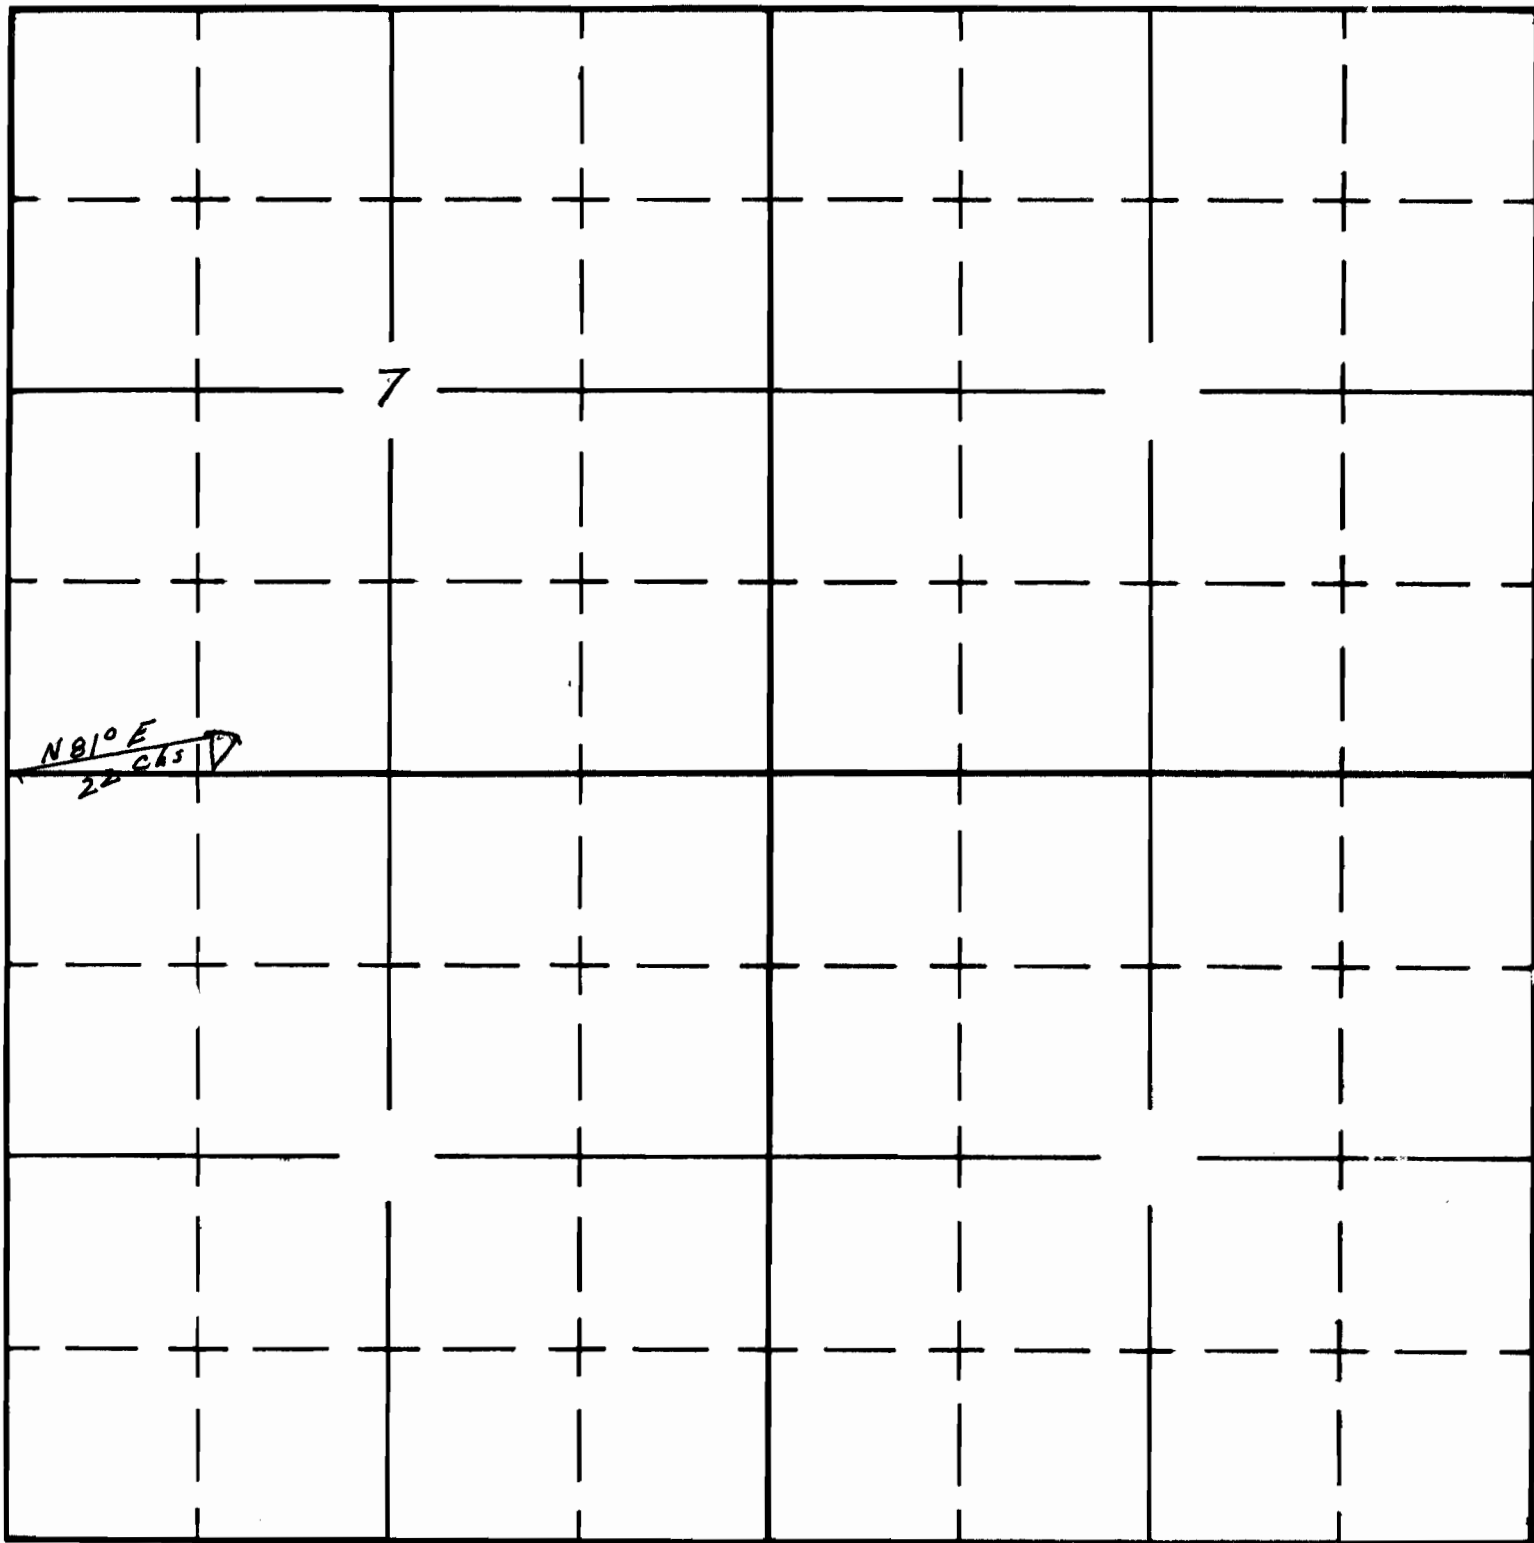

South

APPLICATION No. R-38144
PERMIT No. R-318