


Form AI-187
March 1961

UNITED STATES
DEPARTMENT OF THE INTERIOR
BUREAU OF LAND MANAGEMENT

SECTION
12
SW 1/4 SW 1/4

Oregon State Water Filings

TOWNSHIP 30S, RANGE 23E, W. M.

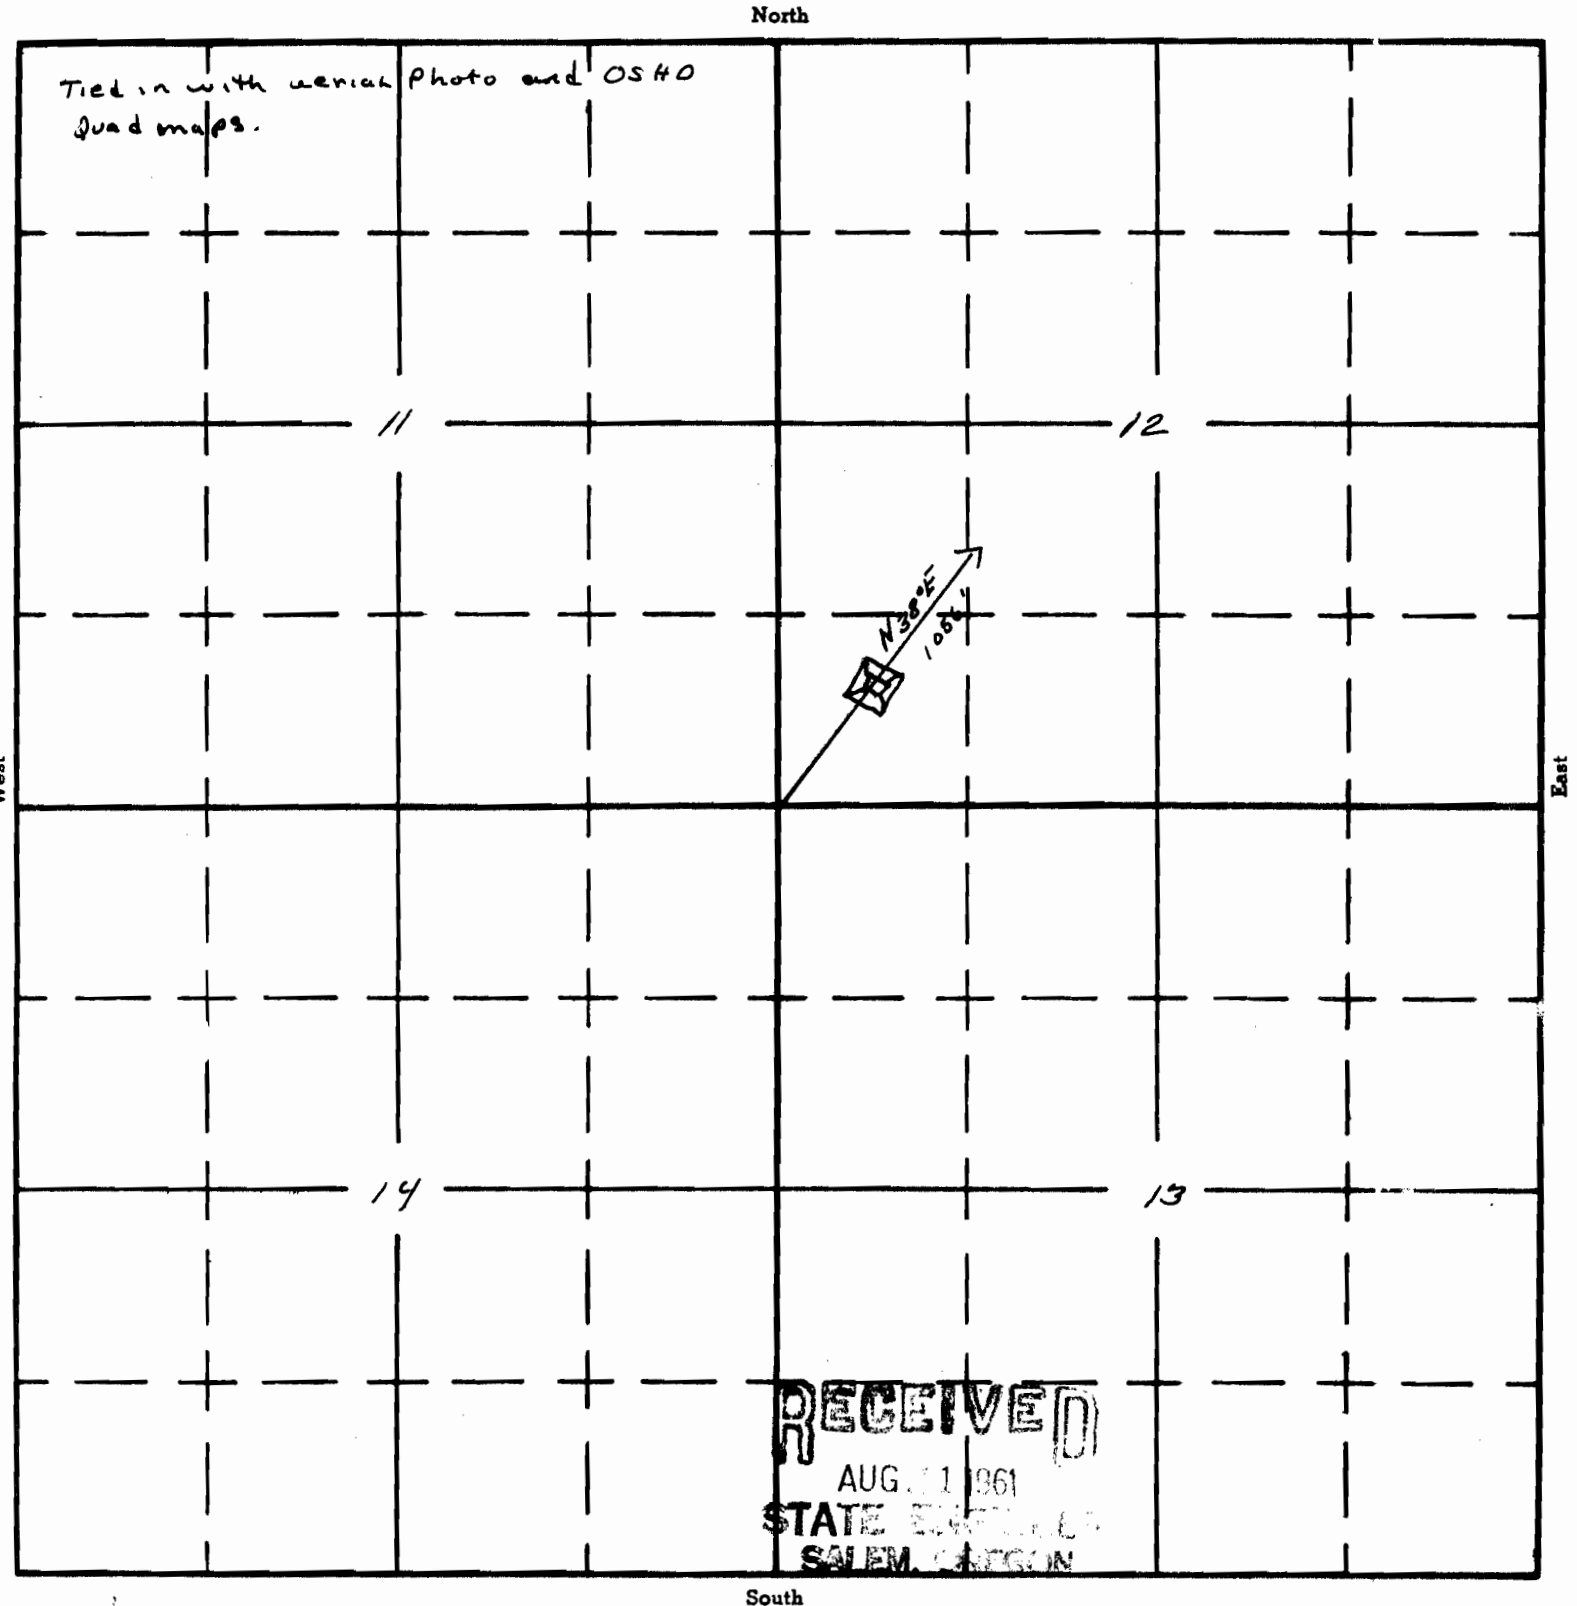

APPLICATION No. A-35963

PERMIT No. R-3535