

UNITED STATES  
DEPARTMENT OF THE INTERIOR  
BUREAU OF LAND MANAGEMENT


SECTION

2 2  
SE 1/4 SW 1/4  
S 1/2 SW 1/4


TOWNSHIP 27 S, RANGE 24 E, W. M.

North

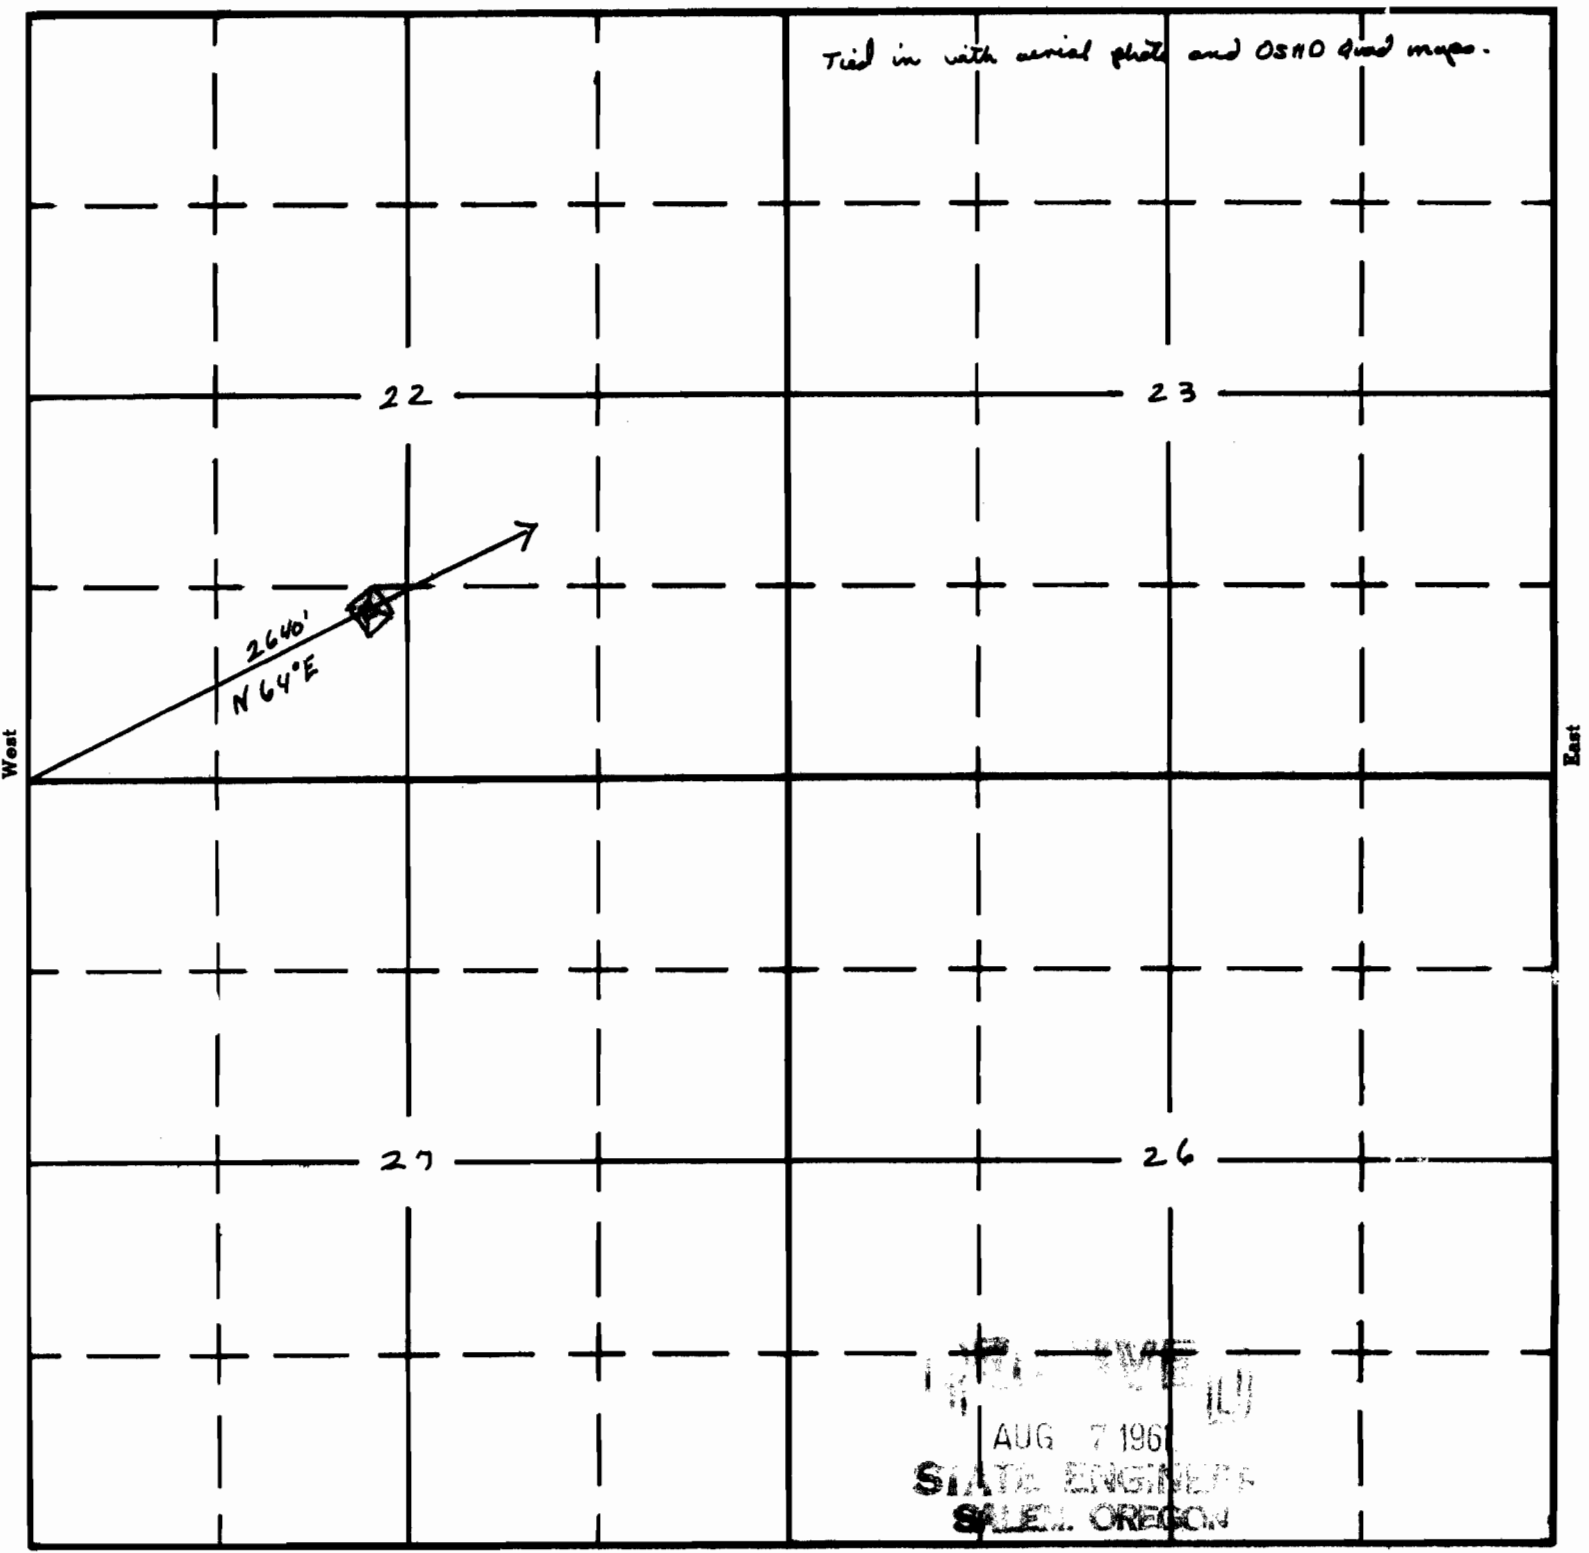

South

APPLICATION No. R-36137  
PERMIT No. R-3568