


UNITED STATES
DEPARTMENT OF THE INTERIOR
BUREAU OF LAND MANAGEMENT

SECTION 18

Oregon State Water Filings

SW 1/4 NW 1/4 TOWNSHIP 37 S., RANGE 29 E., W. M.

Tied in with aerial photos: O.S.H.D. Quad Maps

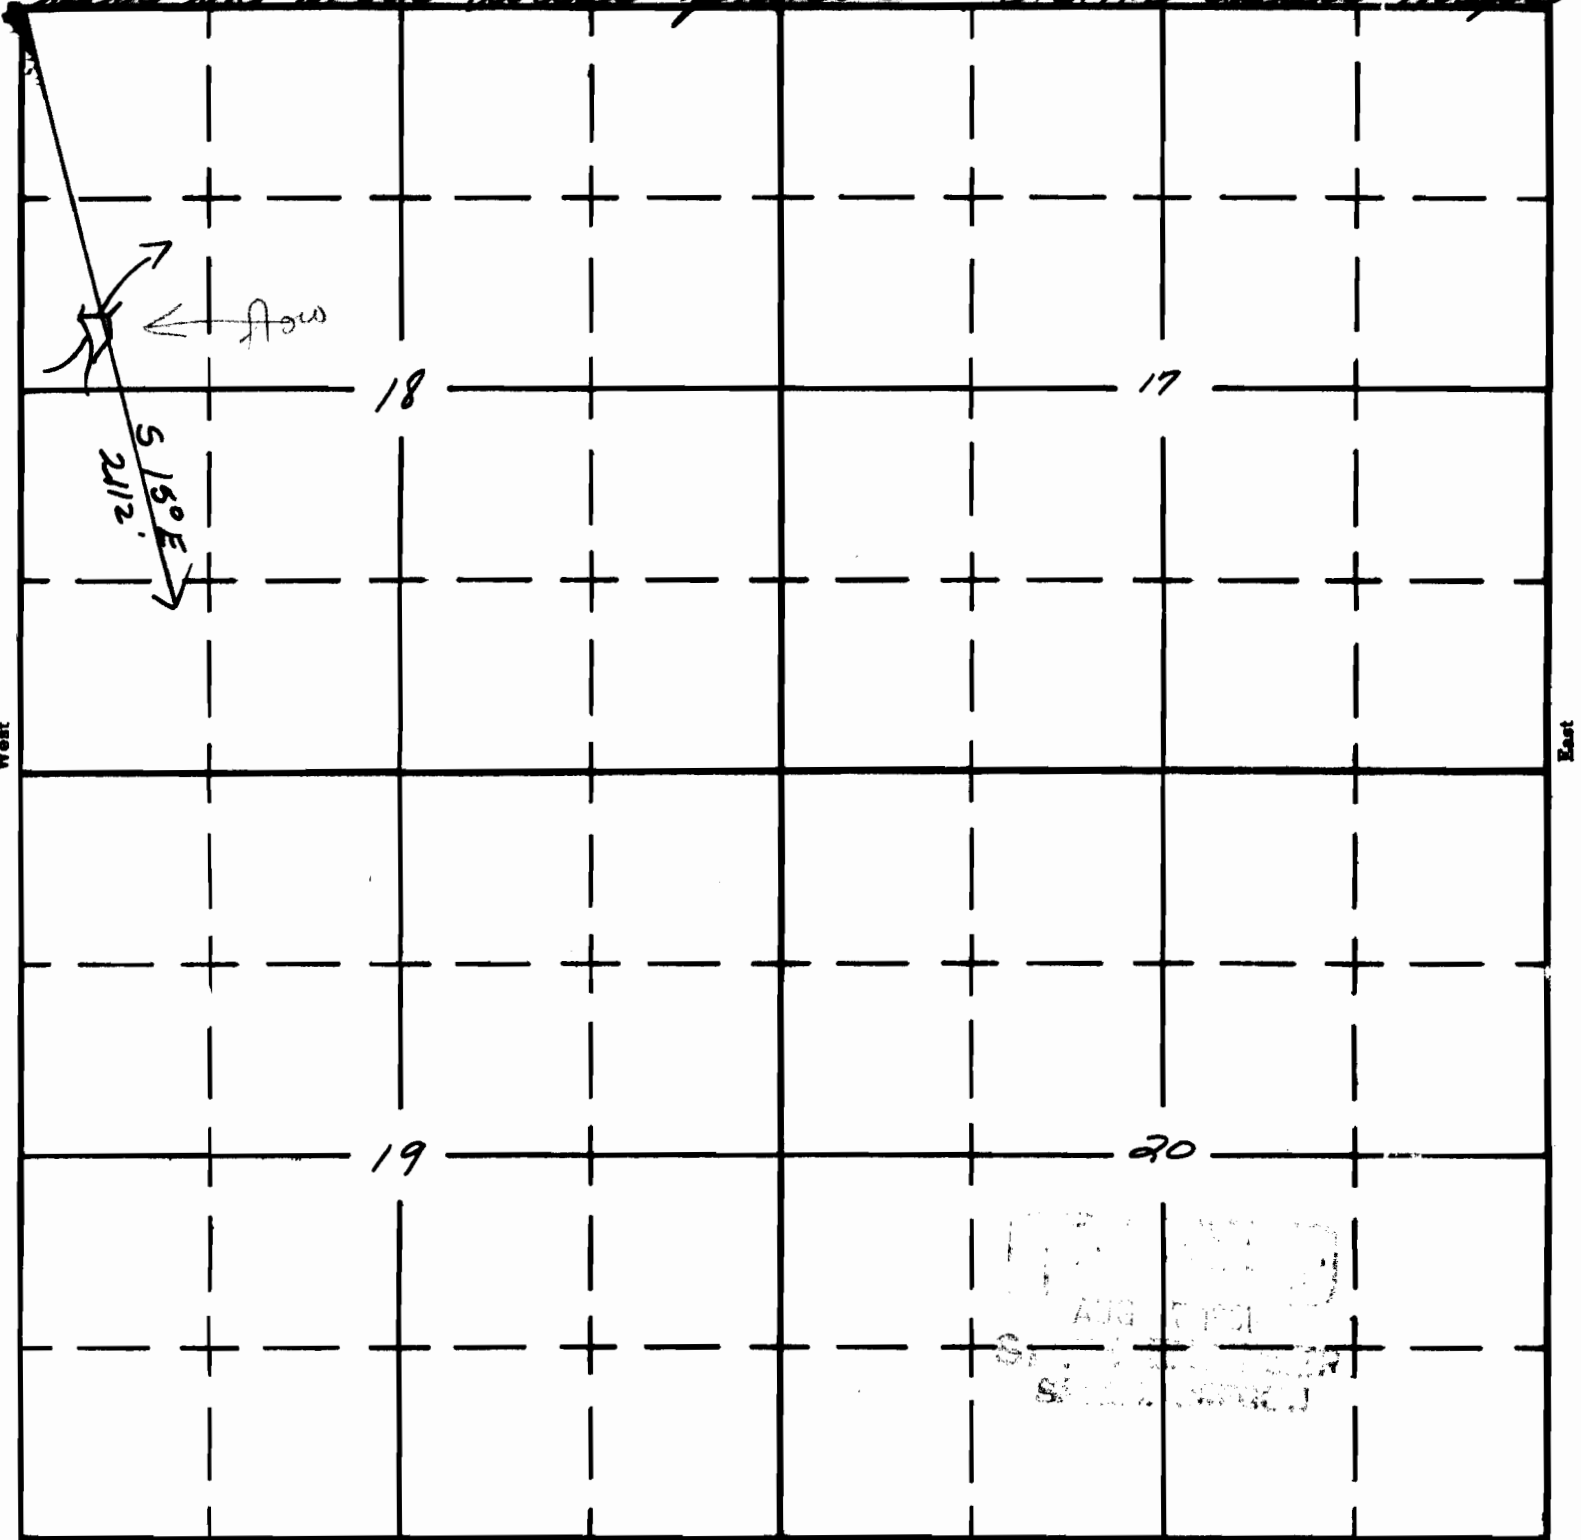

South

APPLICATION No. R-36234

PERMIT No. R-3578