

Form AI-187
March 1961

UNITED STATES
DEPARTMENT OF THE INTERIOR
BUREAU OF LAND MANAGEMENT


SECTION 1

Oregon State Water Filings

SE 1/4 NW 1/4

TOWNSHIP 41S, RANGE 27E, W. M.

TIED IN WITH AERIAL PHOTOS AND D.S.H.D. QUAD MAPS.

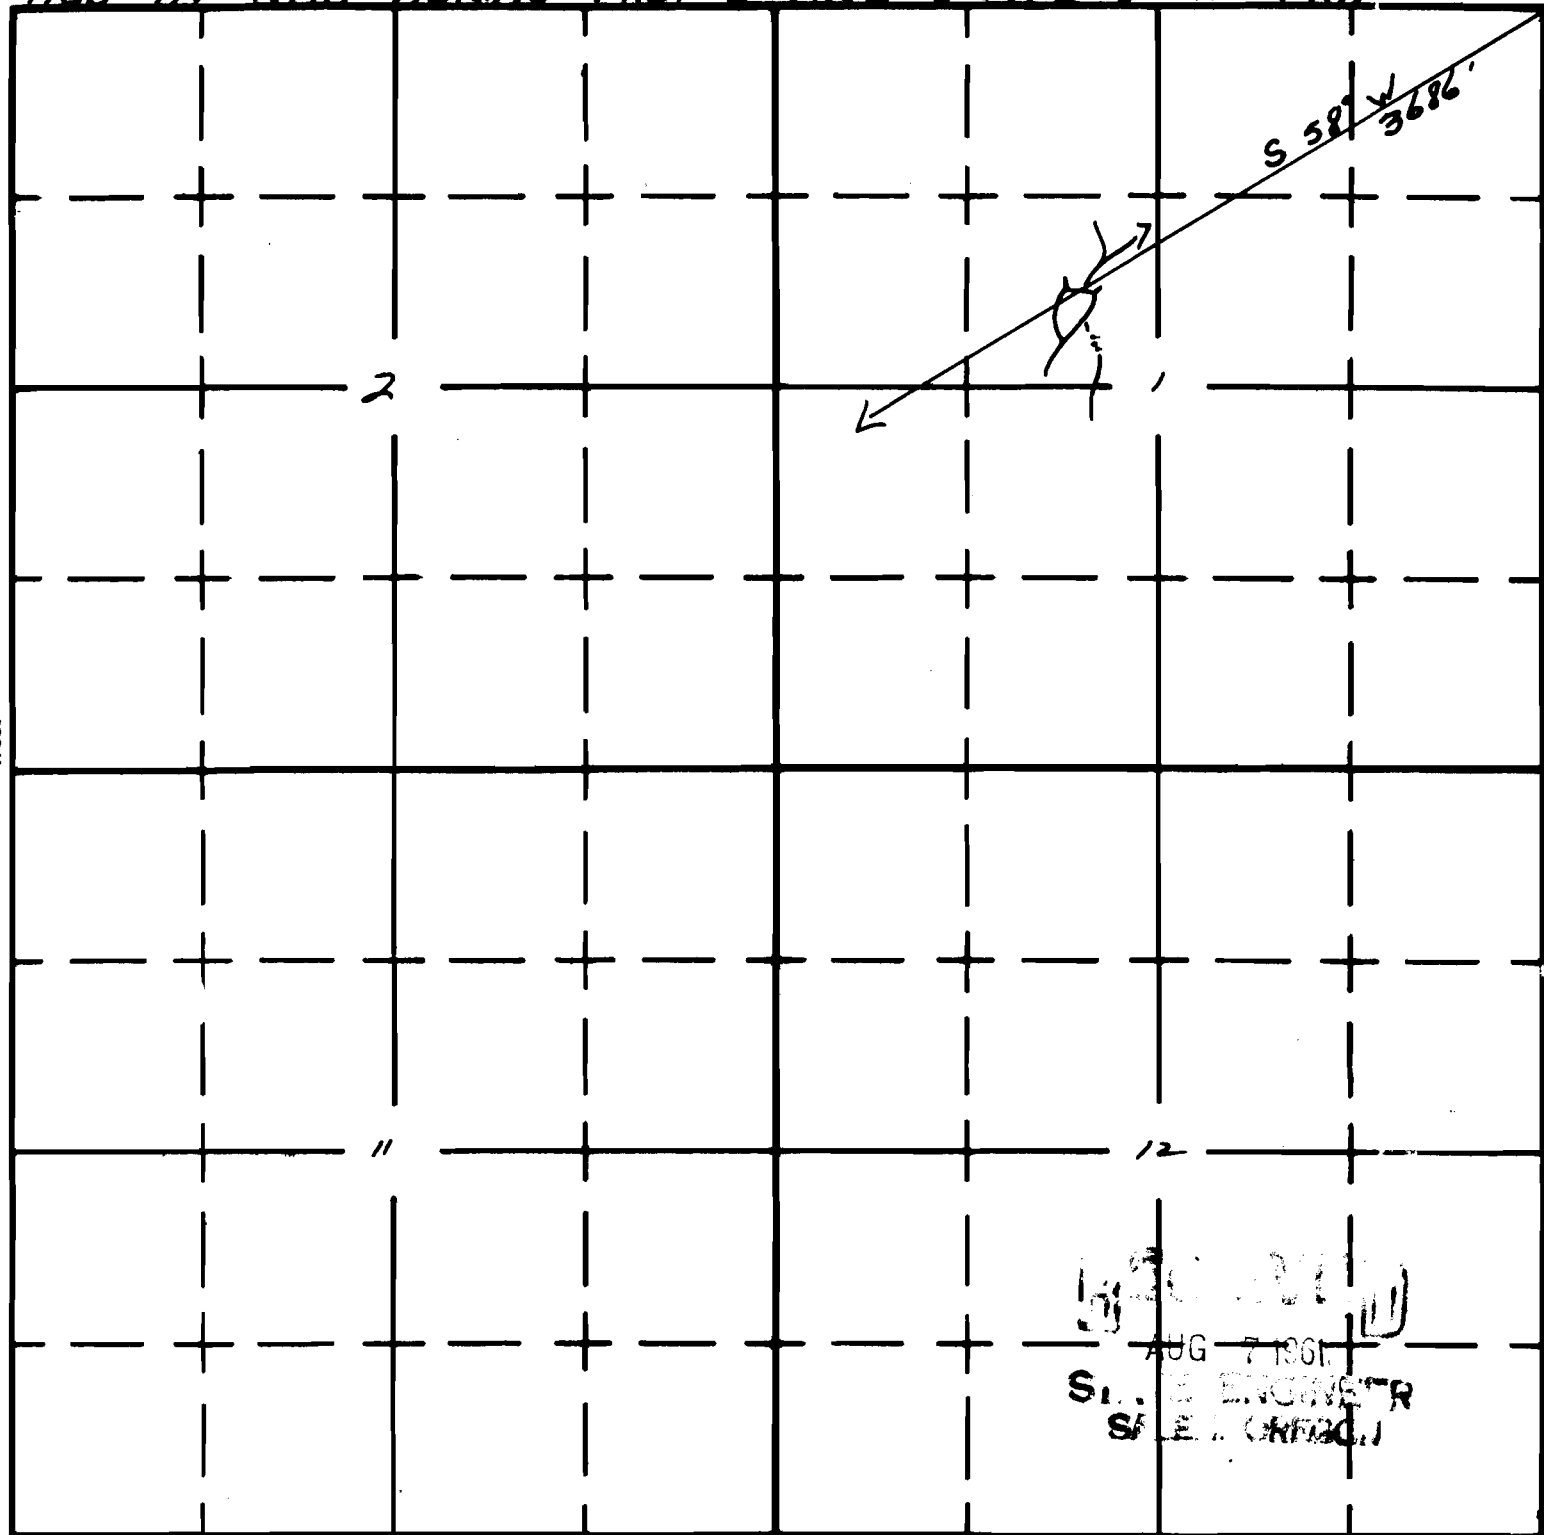

South

APPLICATION No. R-36281

PERMIT No. R-3598