

Form AI-187
March 1961

UNITED STATES
DEPARTMENT OF THE INTERIOR
BUREAU OF LAND MANAGEMENT

SECTION


18

Oregon State Water Filings

NW¹/₄ SE¹/₄

TOWNSHIP 4S, RANGE 26E, W. M.

Tied in with aerial photo : O.S.H.D. Quad Maps

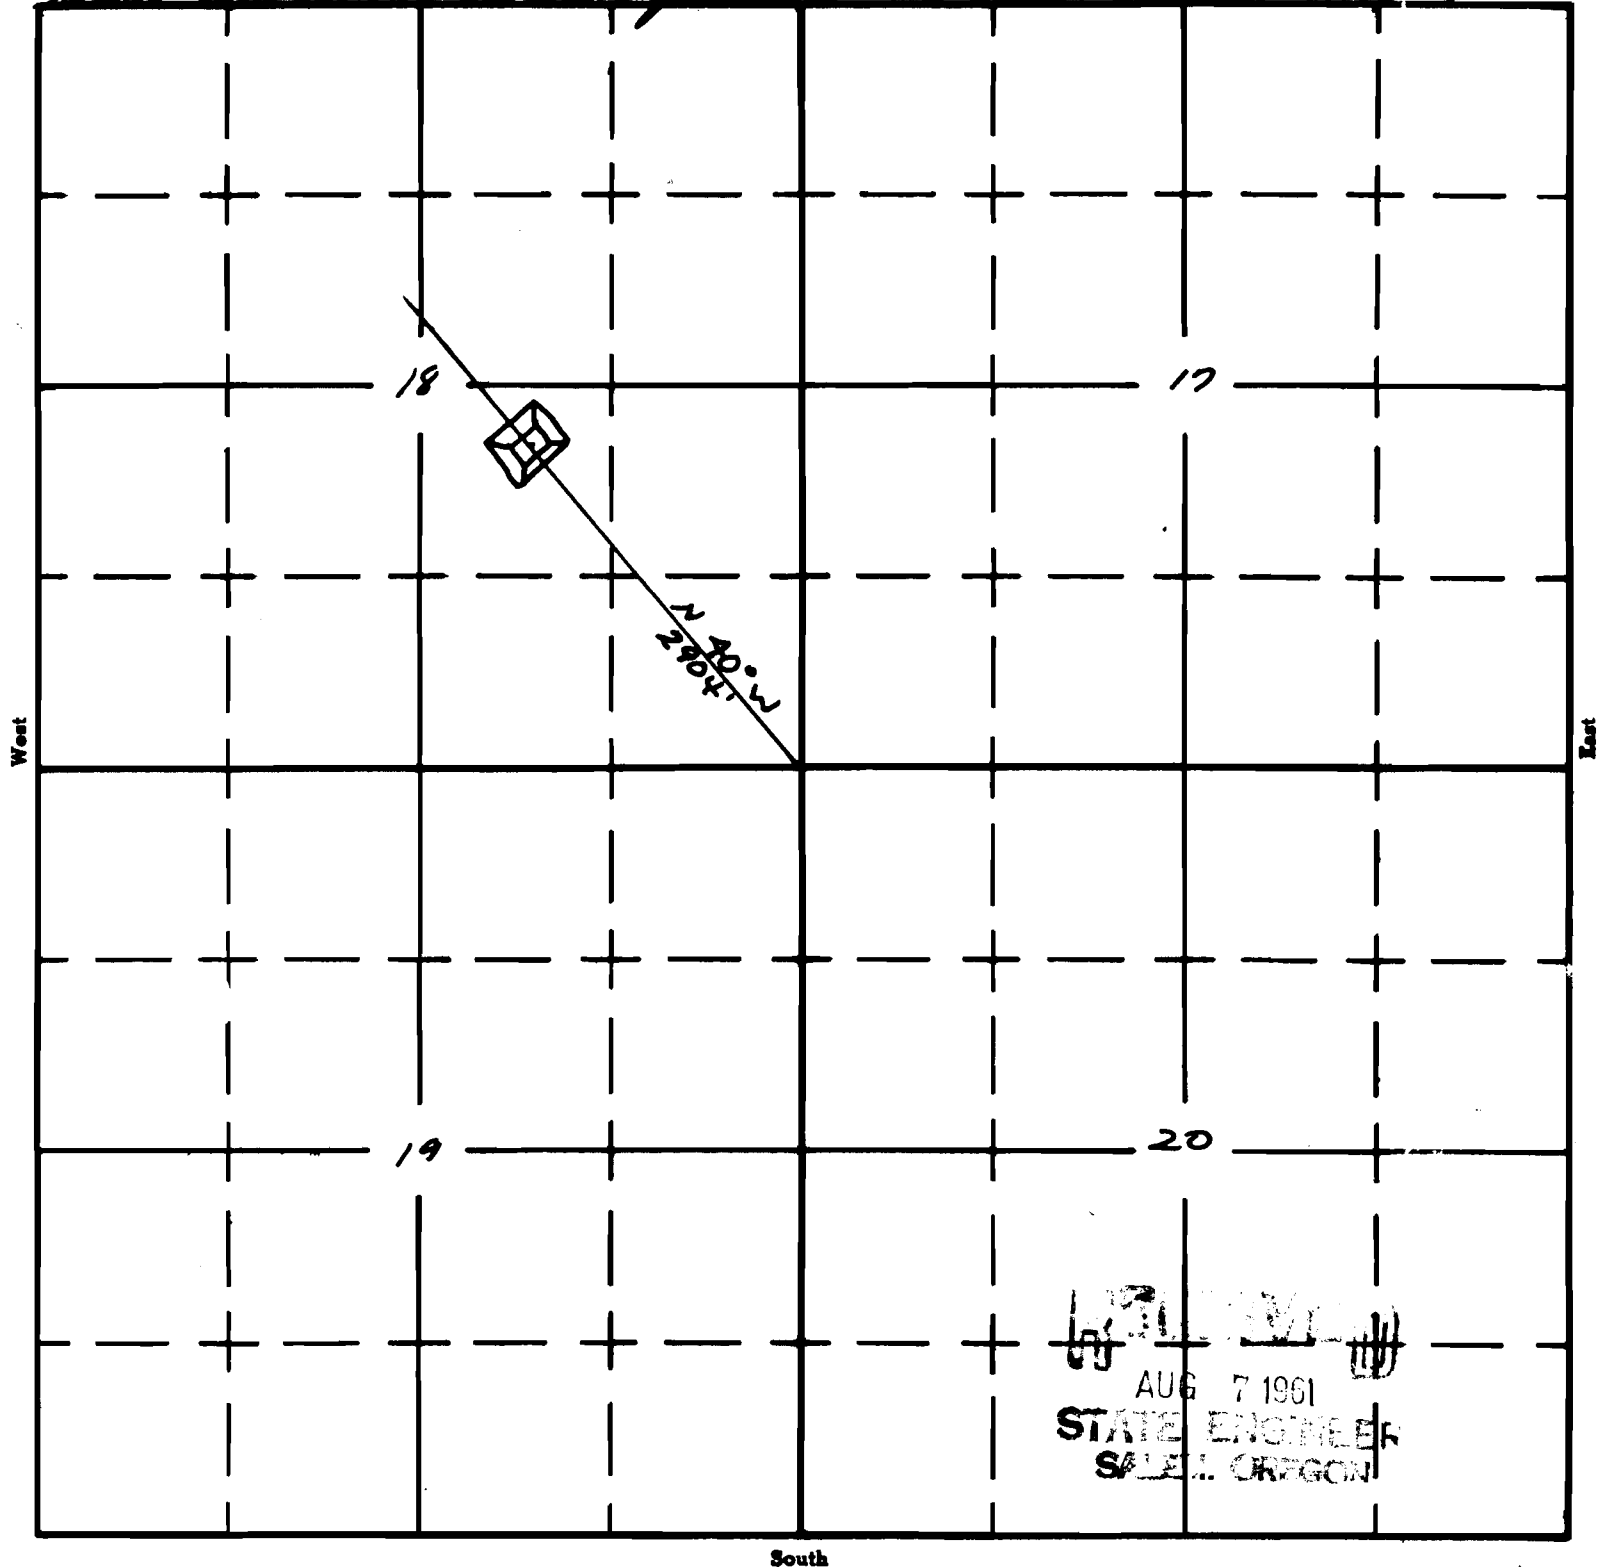

APPLICATION No. R-36321

PERMIT No. R-3619