

Form AI-187
March 1961

UNITED STATES
DEPARTMENT OF THE INTERIOR
BUREAU OF LAND MANAGEMENT

SECTION


29

Oregon State Water Filings

SW¹/₄ SW¹/₄

TOWNSHIP 27S, RANGE 25E, W. M.

Filed in with aerial photo & O.S.H.O. Quad Maps

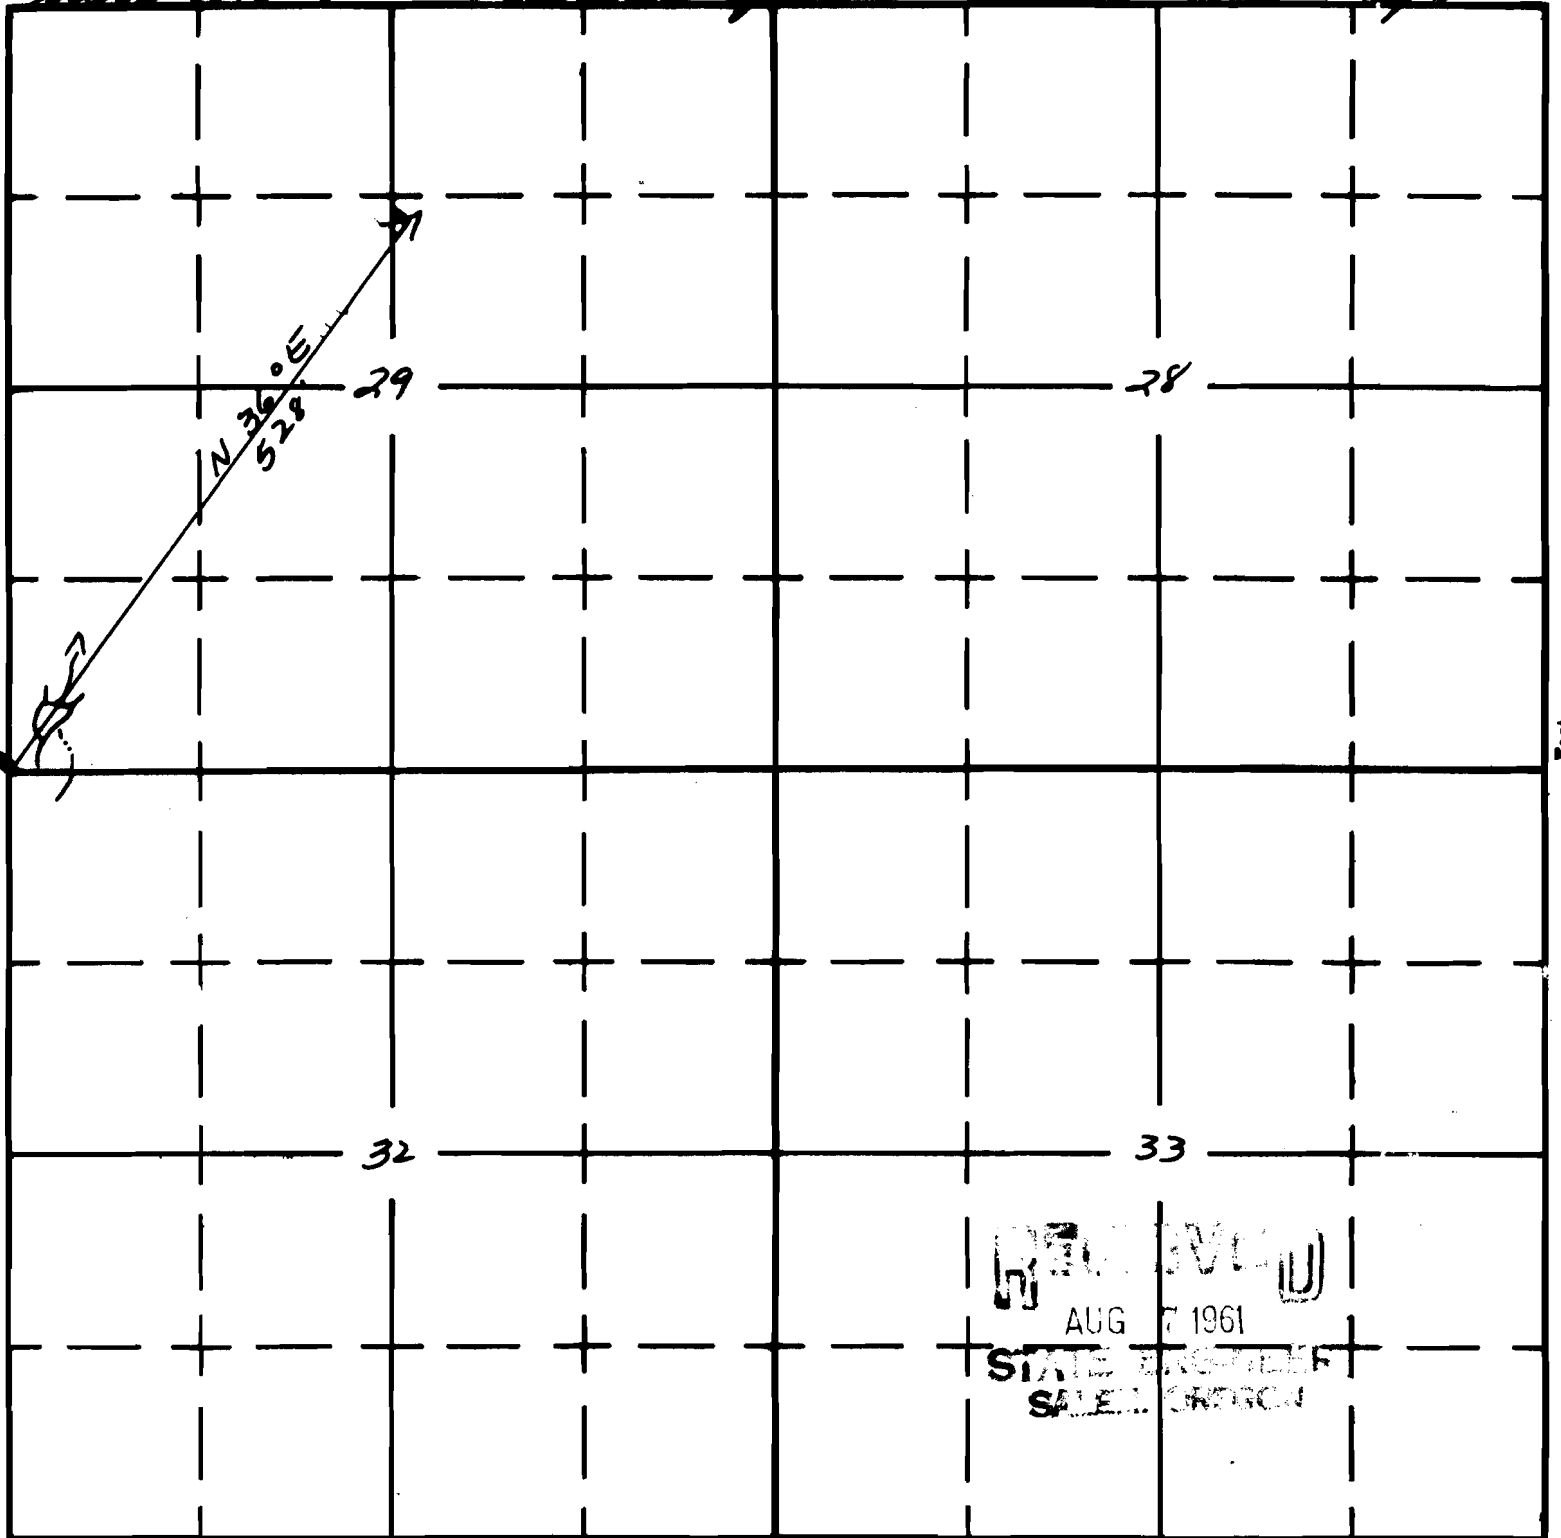

RECEIVED
AUG 7 1961
STATE ENGINEER
SALEM, OREGON

APPLICATION No. R-36333

PERMIT No. R-3628