


TOWNSHIP 39S, RANGE 27E, W. M.

North Tied in with aerial photo and ASHCO and Maps.

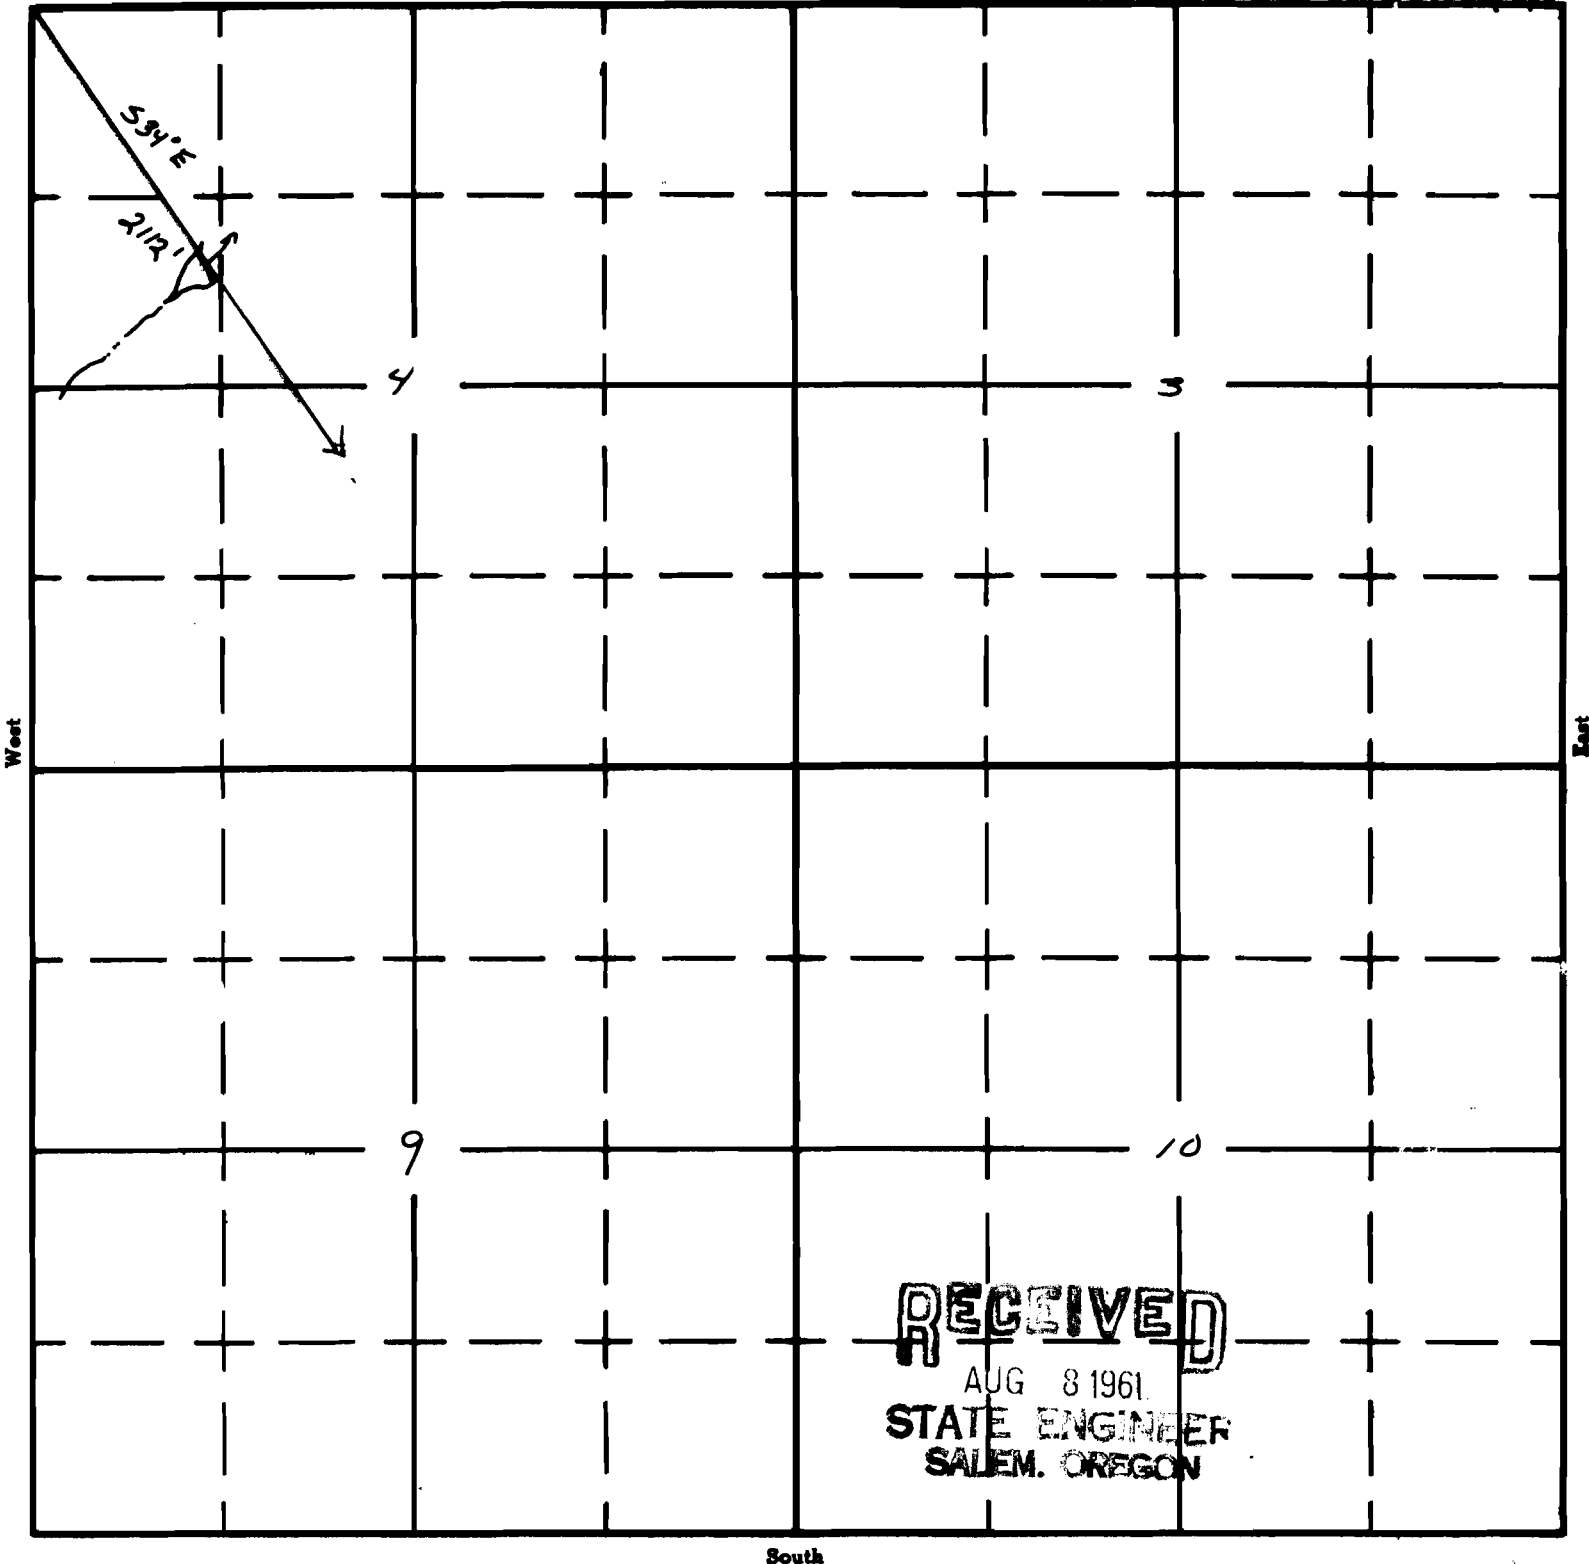

APPLICATION No. **R-36342**

PERMIT No. R-3632.