


Form AI-187
March 1961

UNITED STATES
DEPARTMENT OF THE INTERIOR
BUREAU OF LAND MANAGEMENT

SECTION 8
W 1/2 NE 1/4

Oregon State Water Filings
TOWNSHIP 28S, RANGE 13E, W. M.

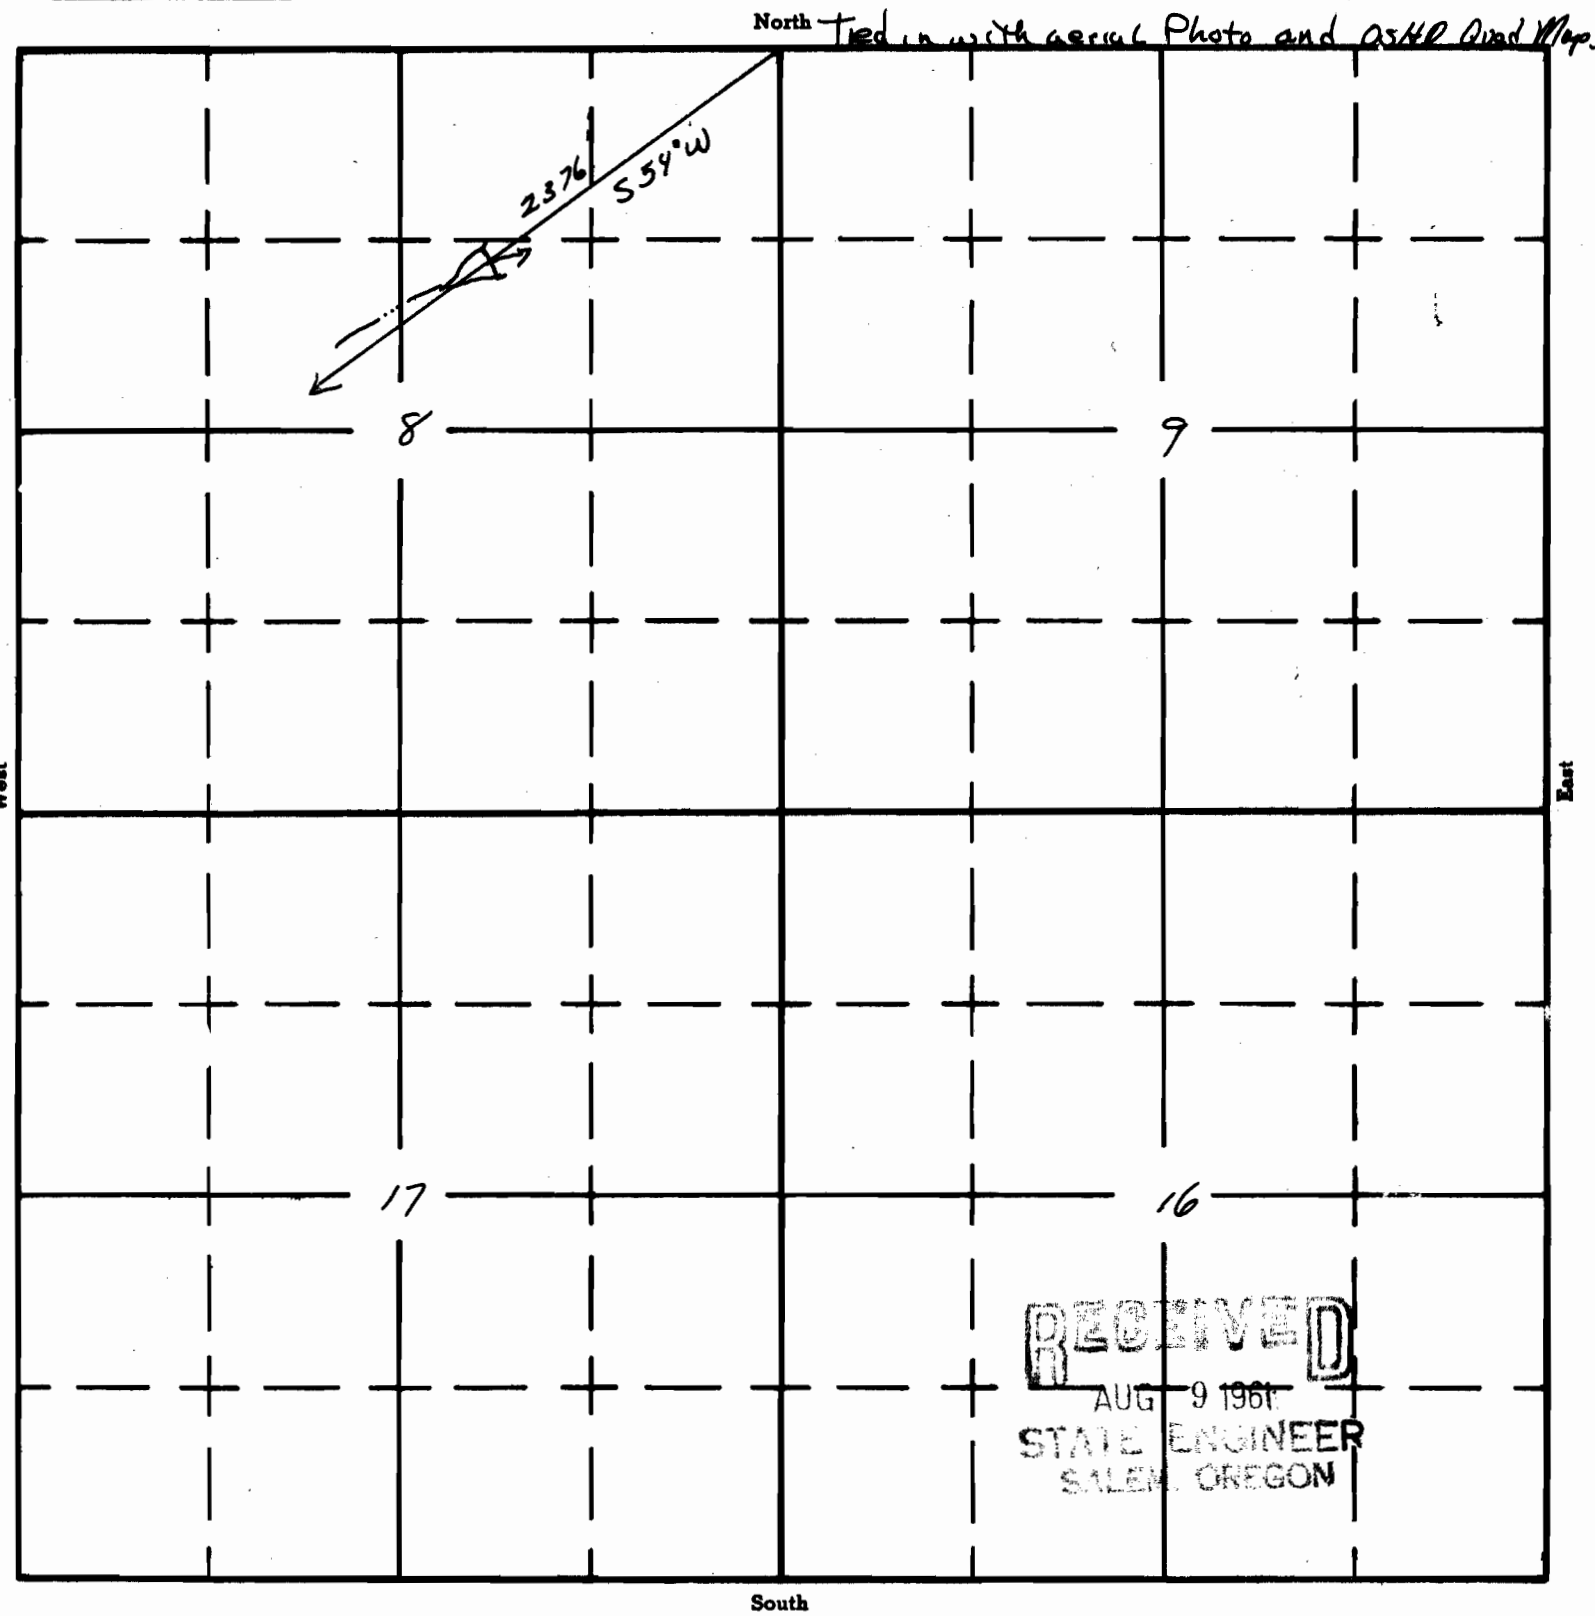

APPLICATION No. R-36961
PERMIT No. R-3676