

Form A1-187
March 1961

UNITED STATES
DEPARTMENT OF THE INTERIOR
BUREAU OF LAND MANAGEMENT


SECTION
3

Oregon State Water Filings

SE 1/4 SE 1/4

TOWNSHIP 31 S, RANGE 25 E, W. M.

Tied in with aerial photos and O.S.H.D. Quad Maps.

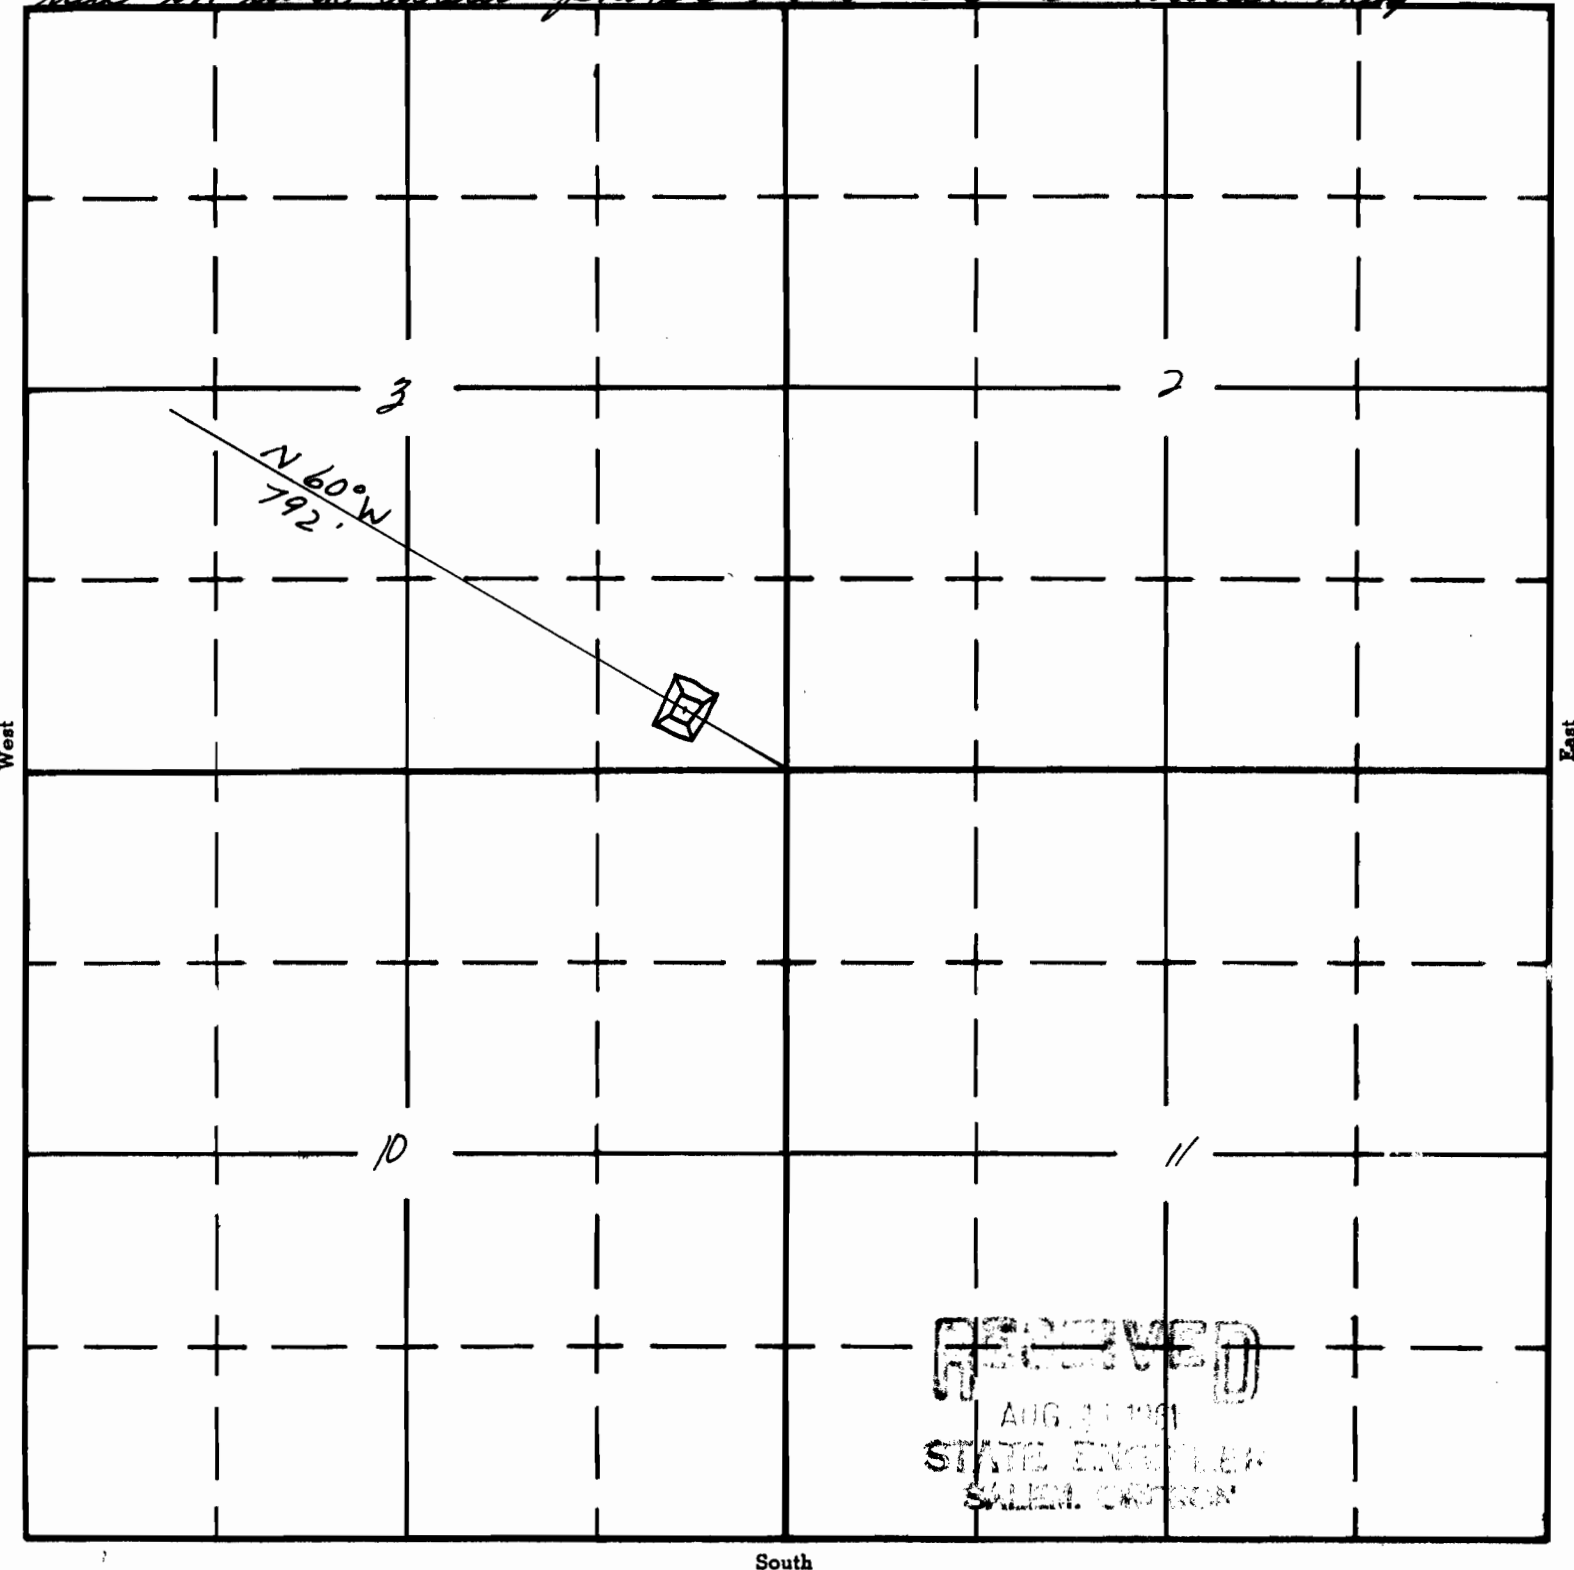

APPLICATION No. **R-35969**
PERMIT No. **R-3742**