

UNITED STATES
DEPARTMENT OF THE INTERIOR
BUREAU OF LAND MANAGEMENT


SECTION
21

Oregon State Water Filings

NE 1/4 NW 1/4

TOWNSHIP 31 S, RANGE 21 E, W. M.

Tied in with aerial photos and O.S.H.D. Quad Maps

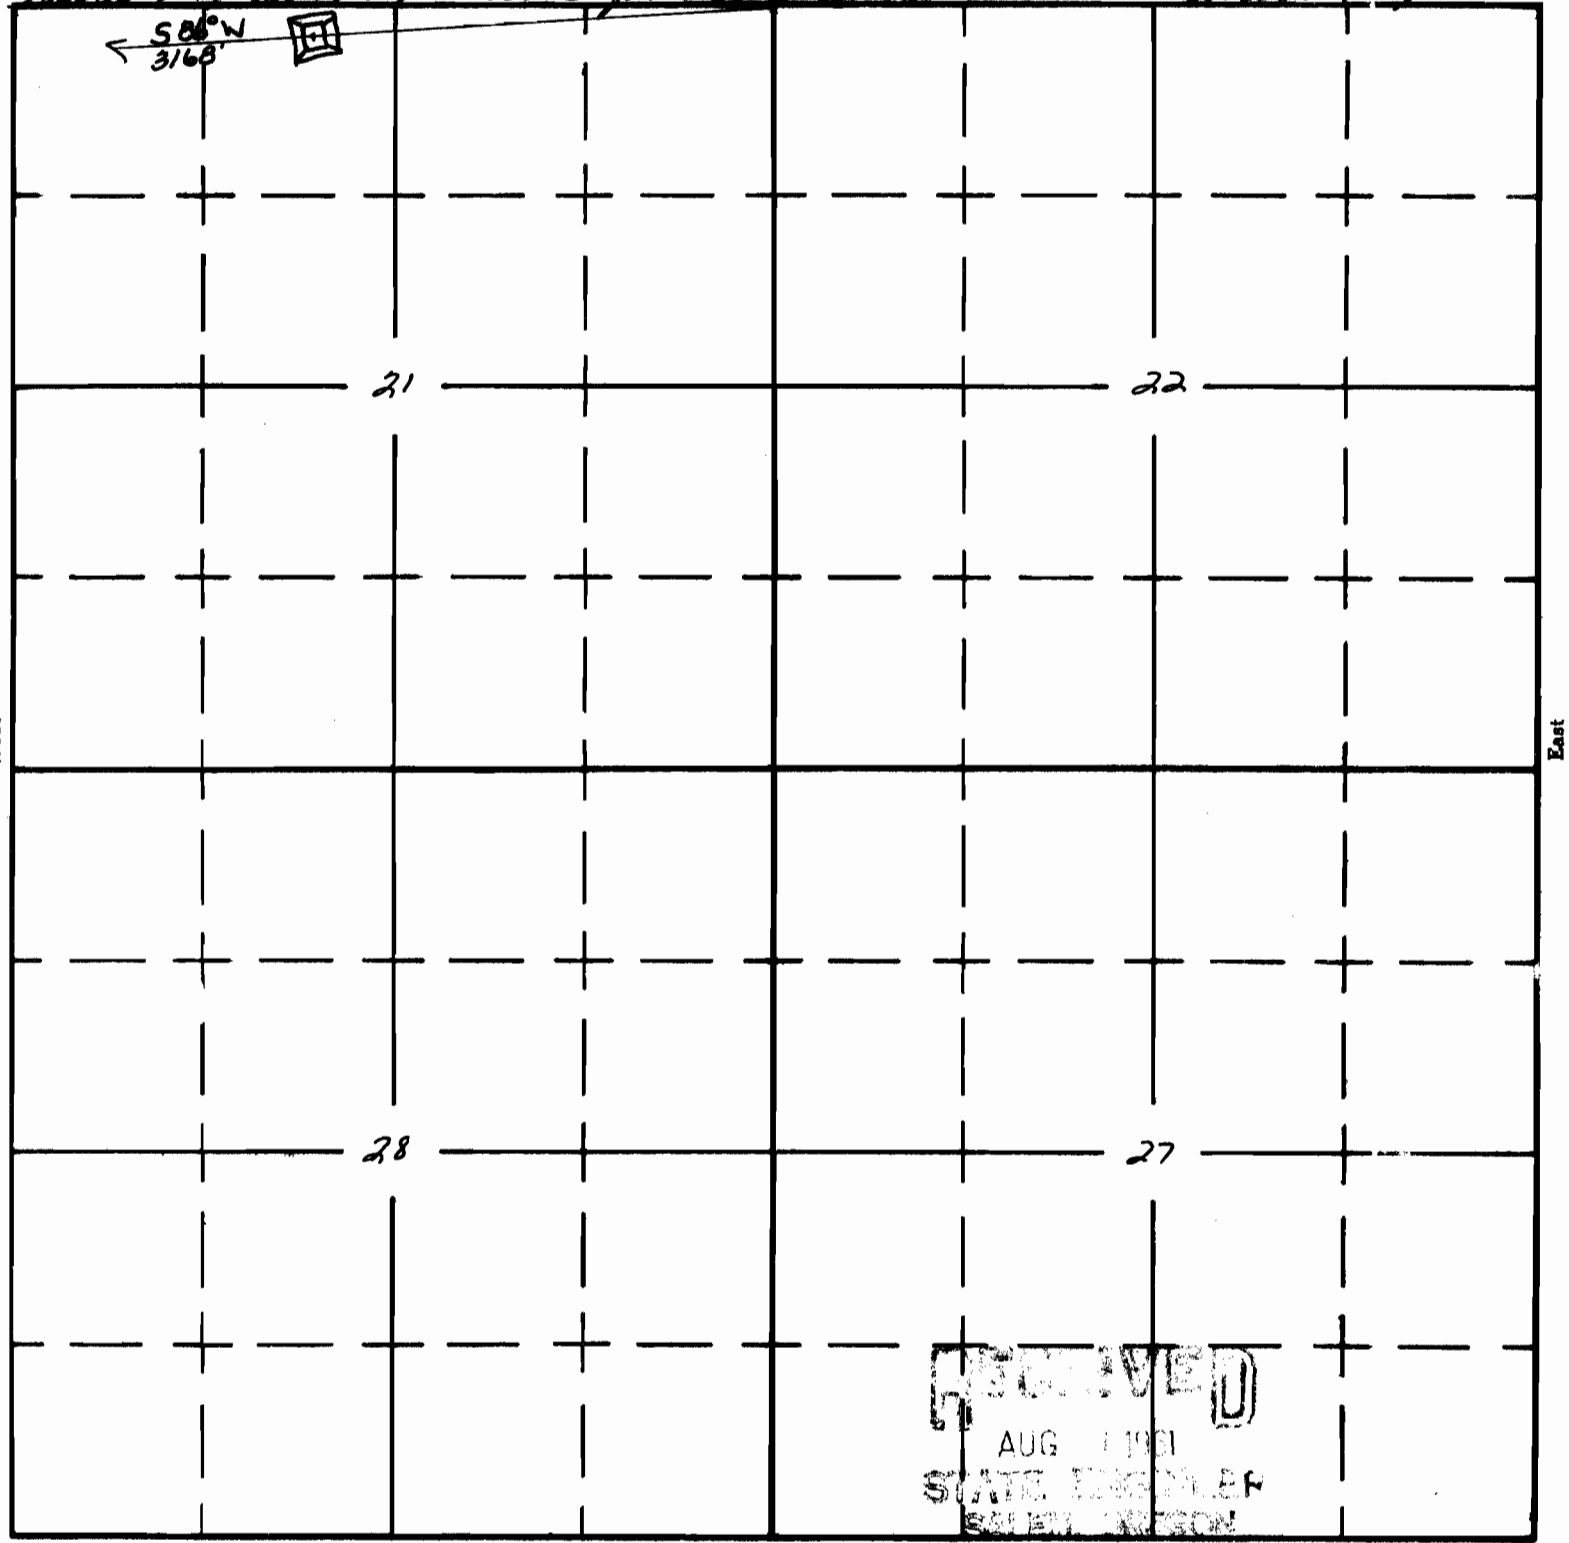

South

APPLICATION No. R-35975
PERMIT No. R-3748