

Form AI-187
March 1961

UNITED STATES
DEPARTMENT OF THE INTERIOR
BUREAU OF LAND MANAGEMENT


SECTION
17

Oregon State Water Filings

NE 1/4 NE 1/4

TOWNSHIP 23S, RANGE 19E, W. M.

Tied in with aerial photos and U.S.G.P. Quad Maps

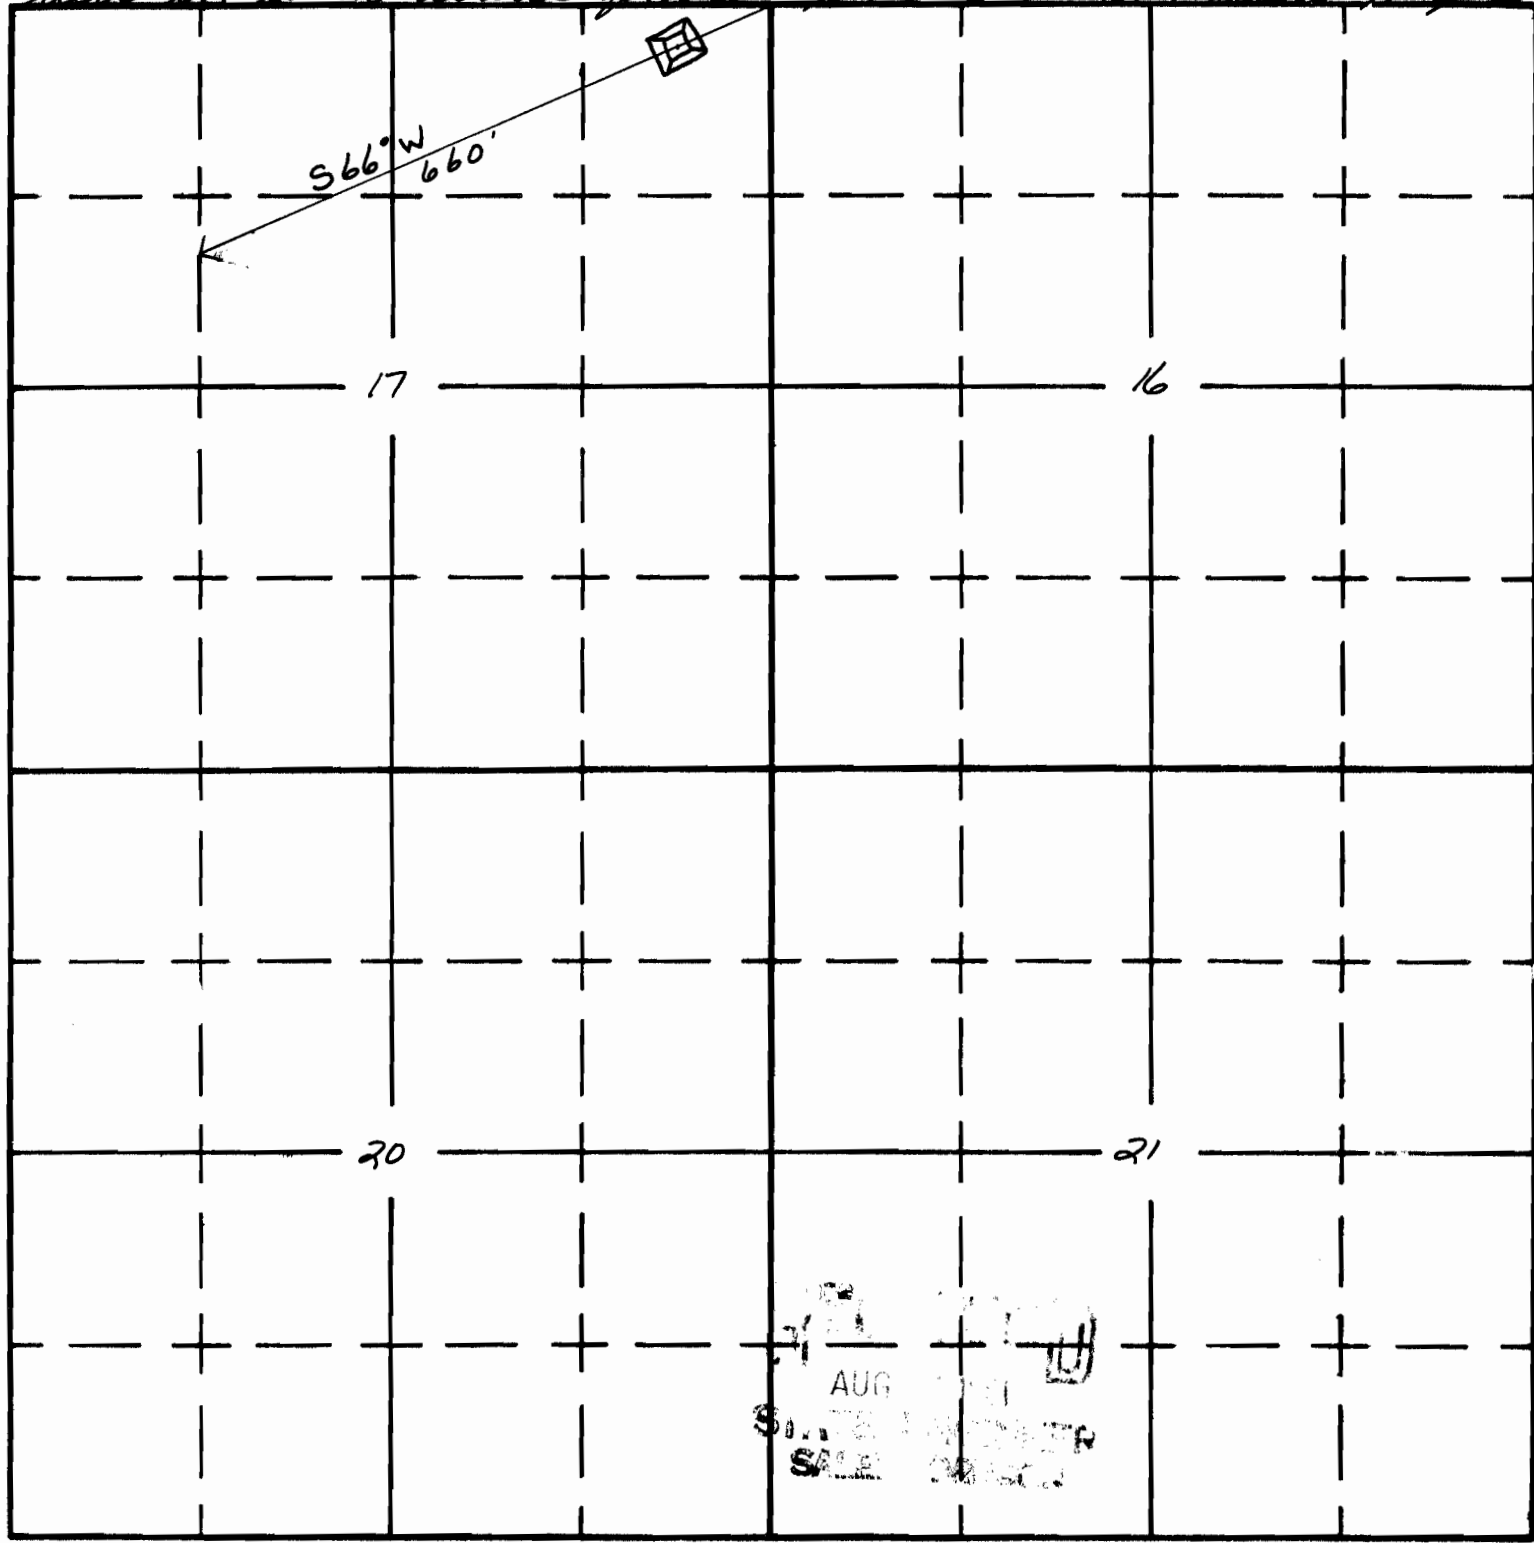

South

APPLICATION No. R-36006

PERMIT No. R-3763