

UNITED STATES
DEPARTMENT OF THE INTERIOR
BUREAU OF LAND MANAGEMENT


SECTION 12

Oregon State Water Filings

SW 1/4 SE 1/4

TOWNSHIP 23 S, RANGE 17 E, W. M.

Tied in with aerial photos and O.S.H.D. Quad Maps.

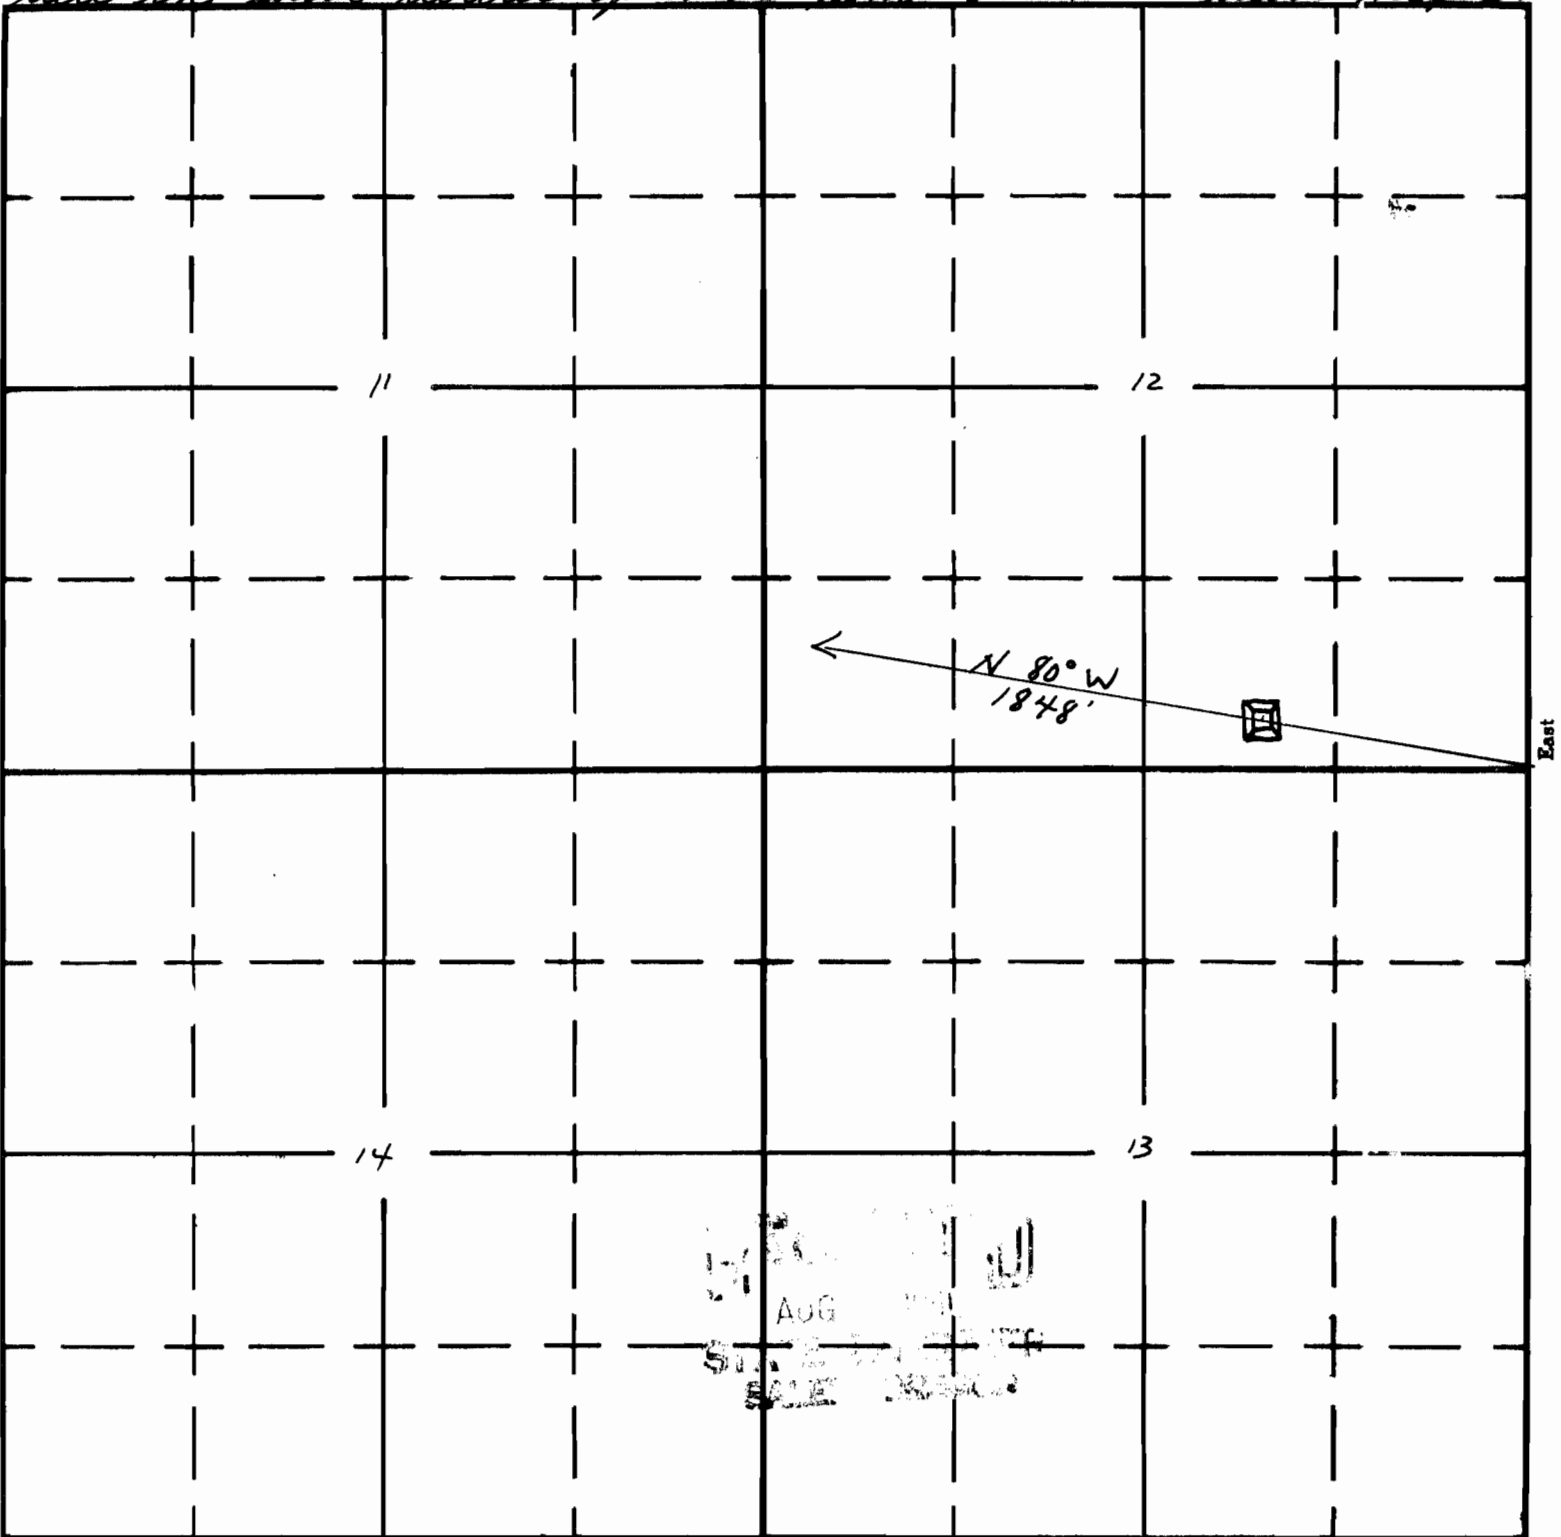

South

APPLICATION No. R-36007
PERMIT No. R-3764