

Form A1-187
March 1961

UNITED STATES
DEPARTMENT OF THE INTERIOR
BUREAU OF LAND MANAGEMENT


SECTION

15
SE 1/4 NW 1/4

Oregon State Water Filings

TOWNSHIP 38S, RANGE 25E, W. M.

North *Tied in with aerial photo and 1940 Quad Maps*

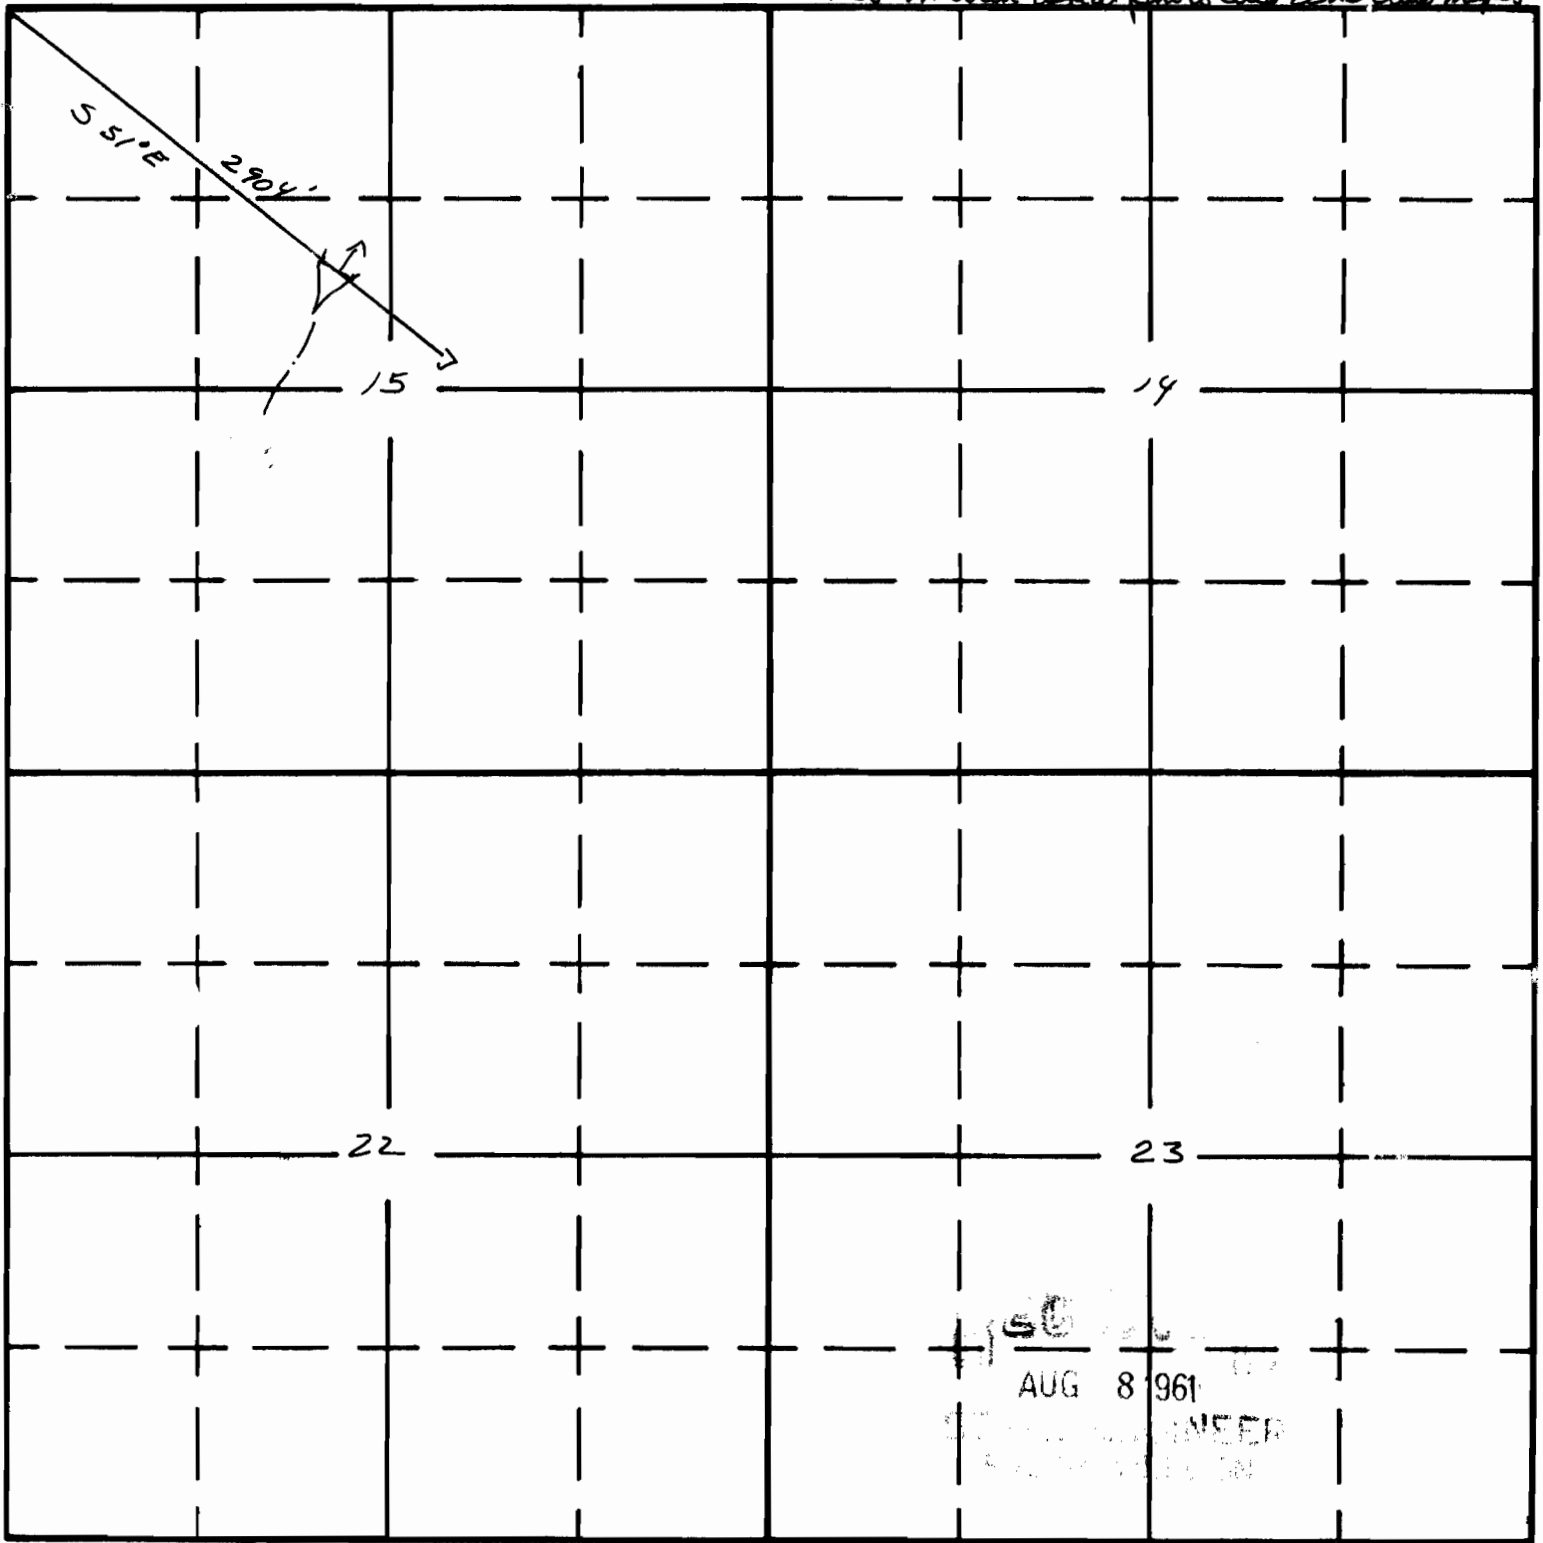

156
AUG 8 1961
ENGINEER
BUREAU OF LAND MANAGEMENT

APPLICATION No. R-36555
PERMIT No. R-3795