

Form AI-187
March 1961

UNITED STATES
DEPARTMENT OF THE INTERIOR
BUREAU OF LAND MANAGEMENT

SECTION


11

Oregon State Water Filings

SE 1/4 NW 1/4

TOWNSHIP 23S, RANGE 19E, W. M.

TIED IN WITH AERIAL PHOTOS AND O.S.H.D. ROAD MAPS.

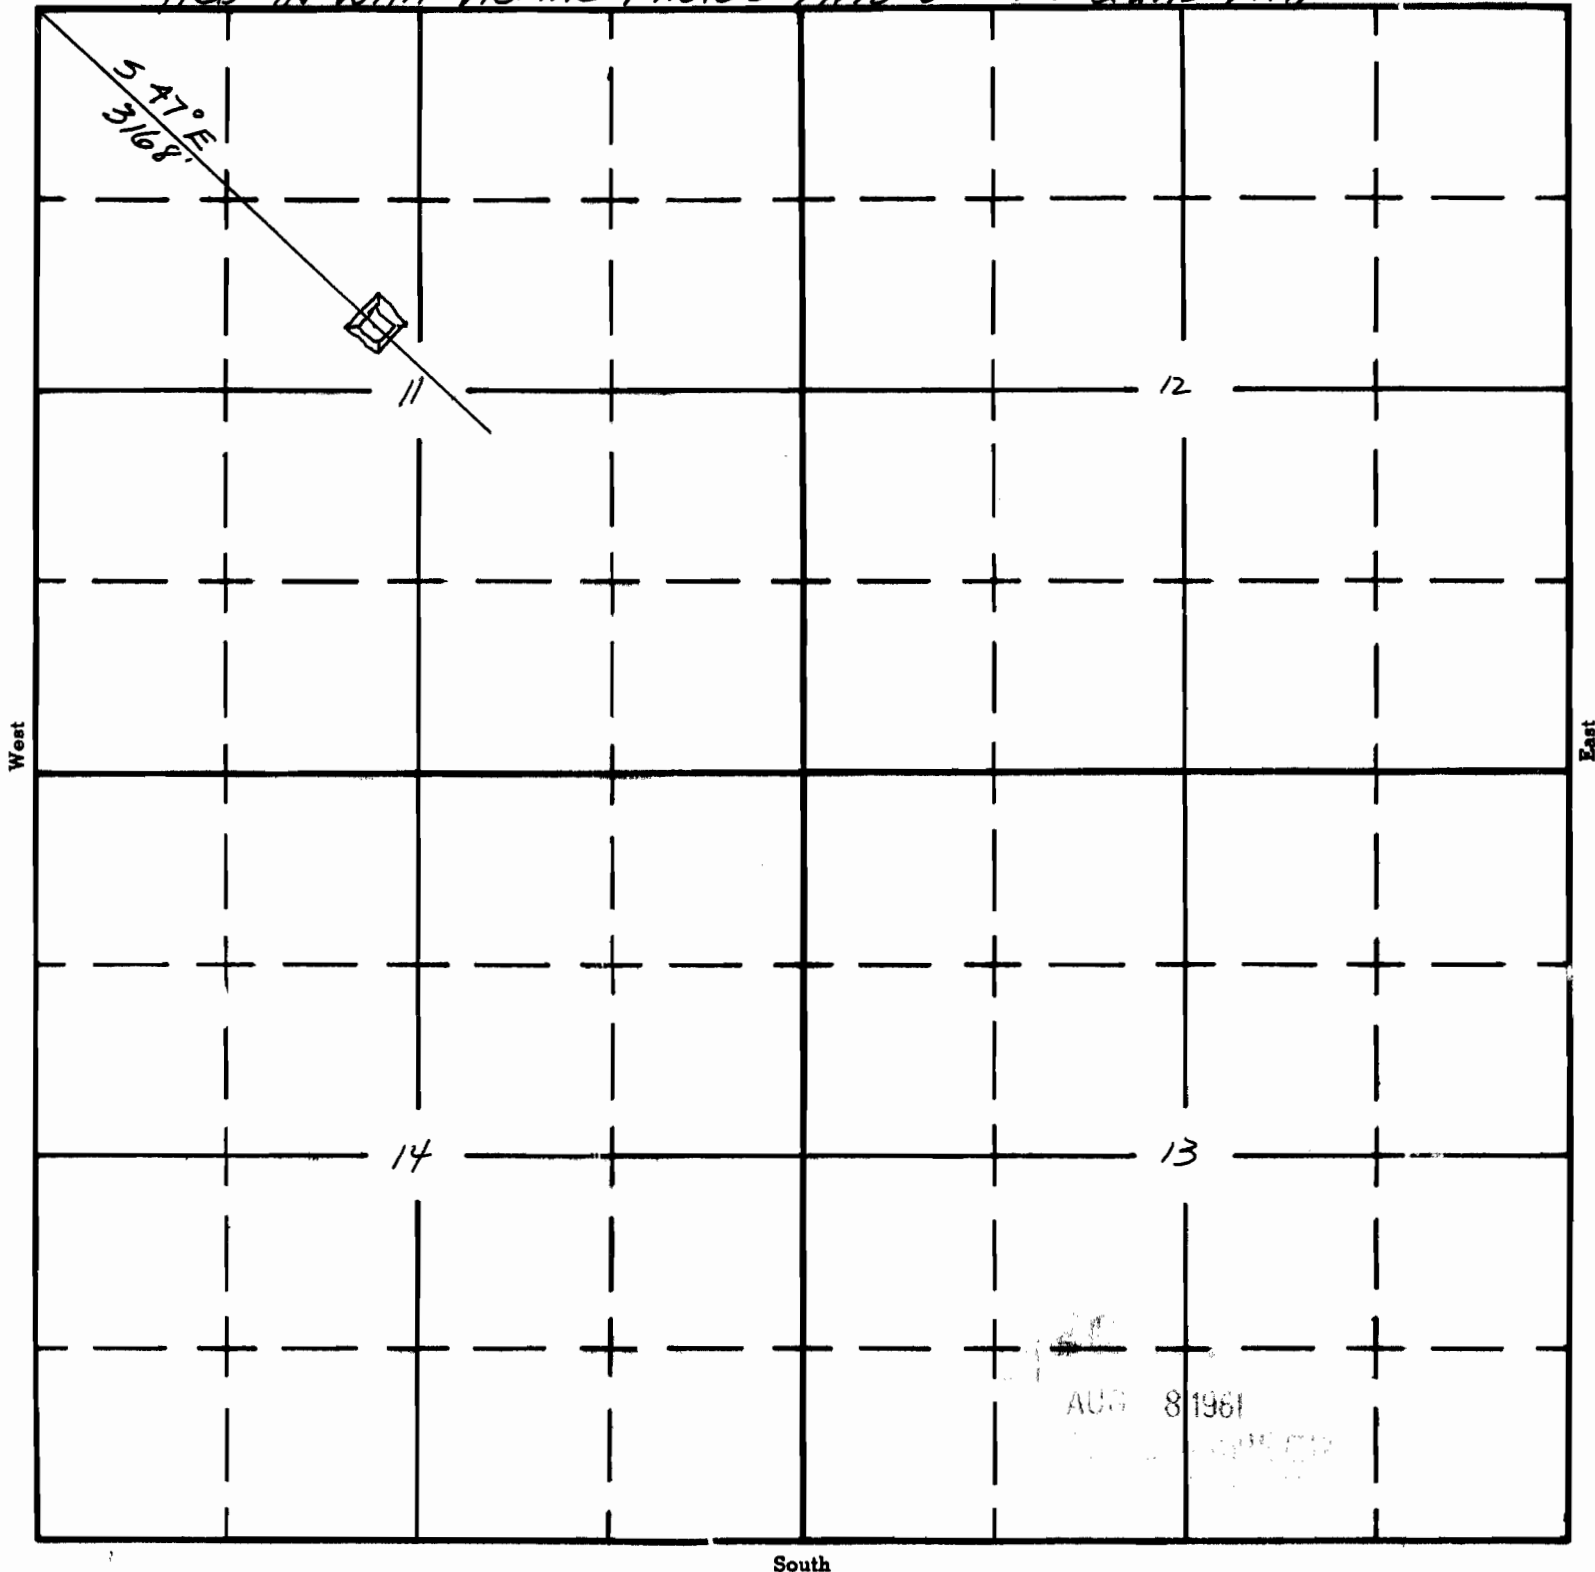

APPLICATION No. R-36572
PERMIT No. R-3786