

UNITED STATES
DEPARTMENT OF THE INTERIOR
BUREAU OF LAND MANAGEMENT

SECTION


2

Oregon State Water Filings

SW¹/₄ SE¹/₄

TOWNSHIP 31 S, RANGE 28 E, W. M.

North

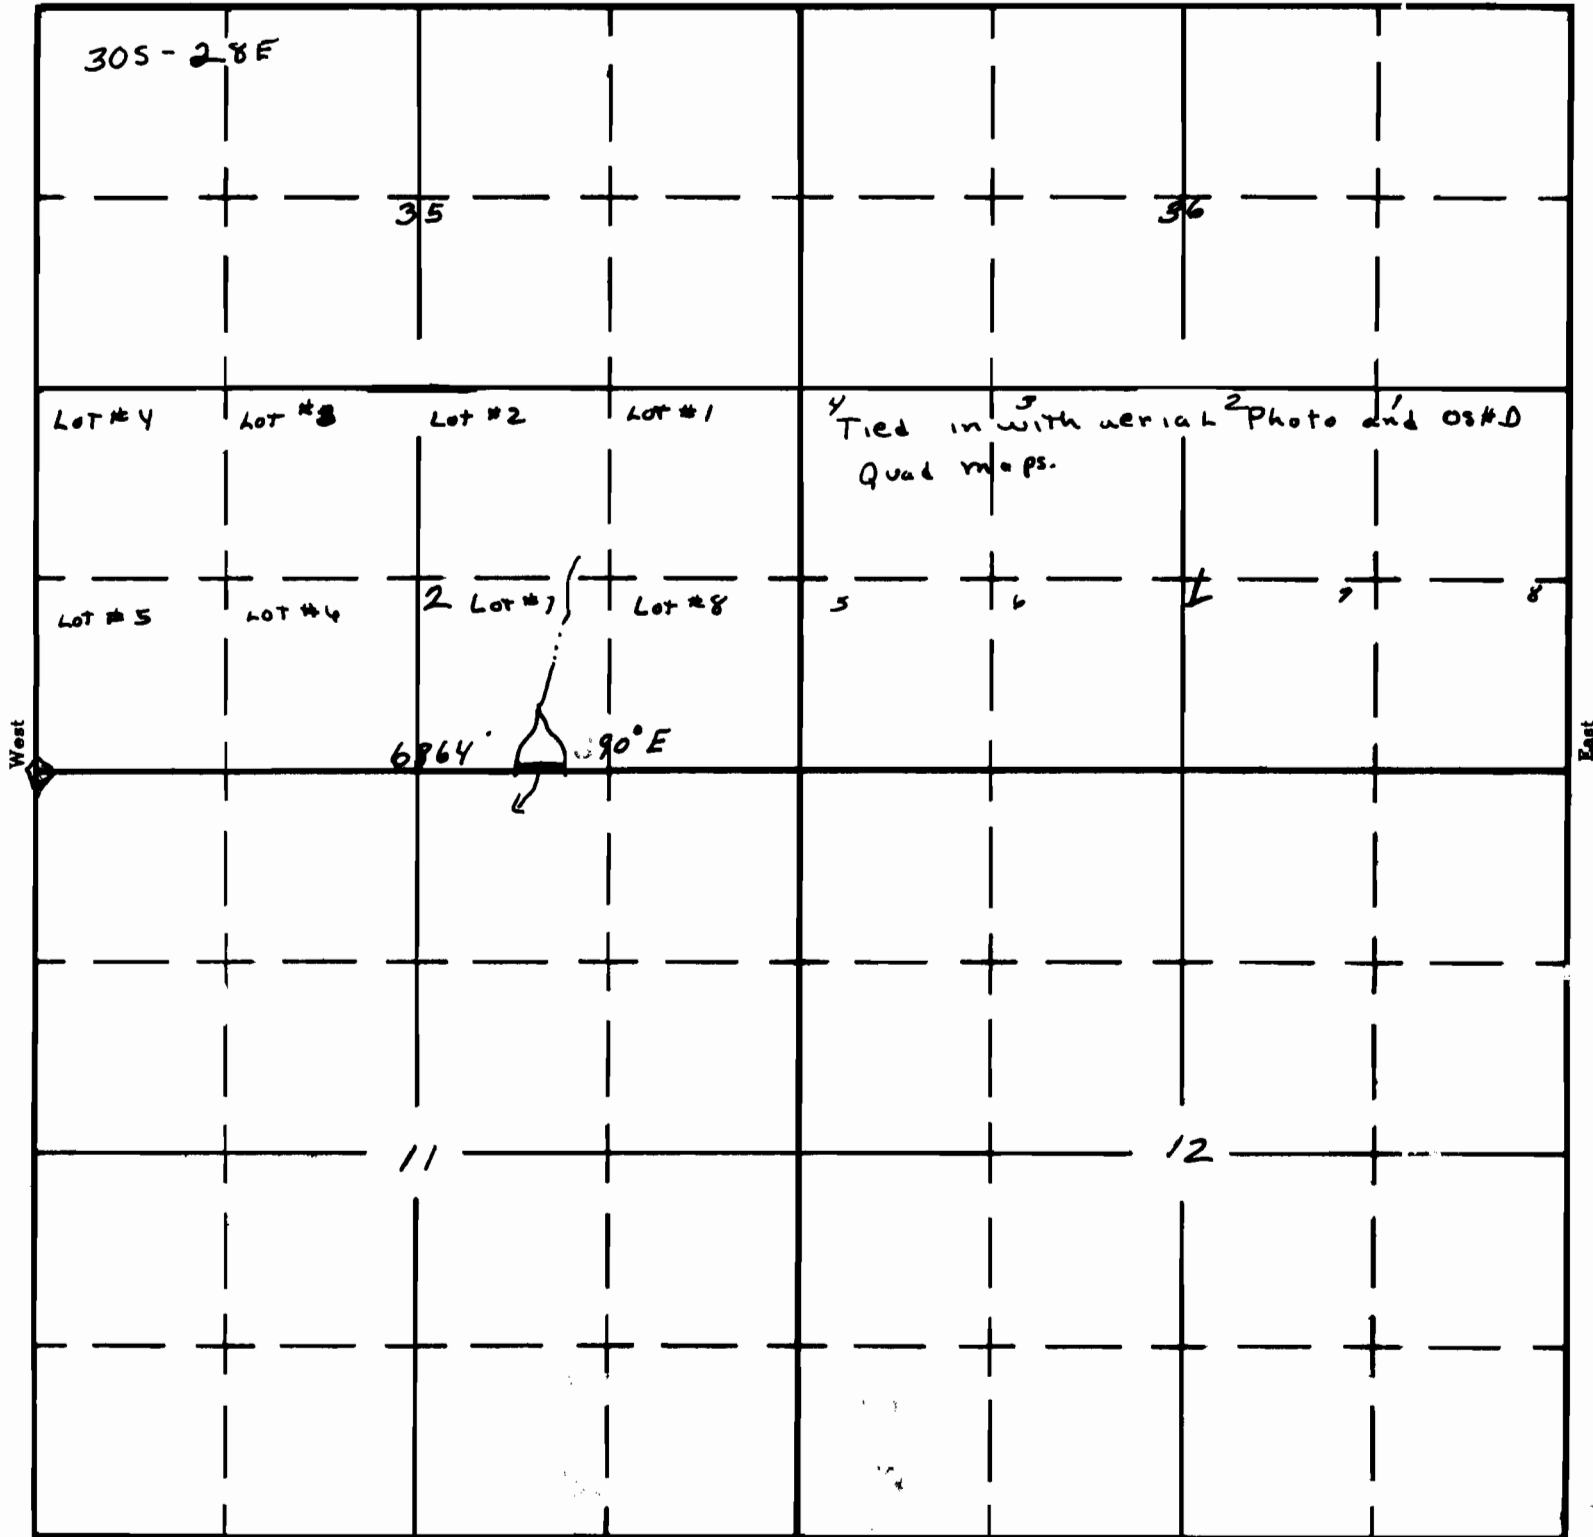

South

APPLICATION No. R-35741

PERMIT No. R-4066